




SEE SURVEY
JAMES POWERS
CL. 1:00

- 054
31.45 A.

~~052~~
~~33.12 A.~~

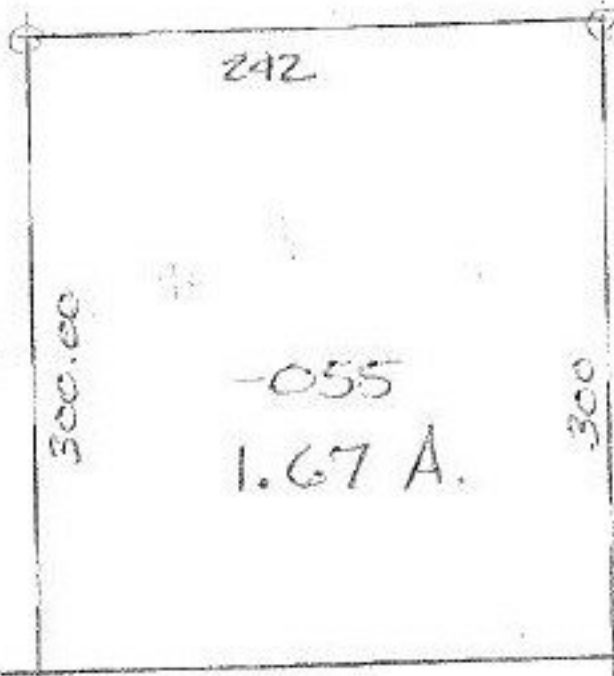

#1640
APPROVED
LORAIN CO.
MAP DEPT.

DATE 10.8.85

PAGE 12.00.008 B

BY T. McMain

VOID
IF

4-11-86

390.85

~~394.85~~

242

262

RD. 0

1879.40

MARKS