


* SEE SURVEY - KLEINBENDER SCHMIDT & ASSOC.

① EL. 1.38461

② EL. 1:250000

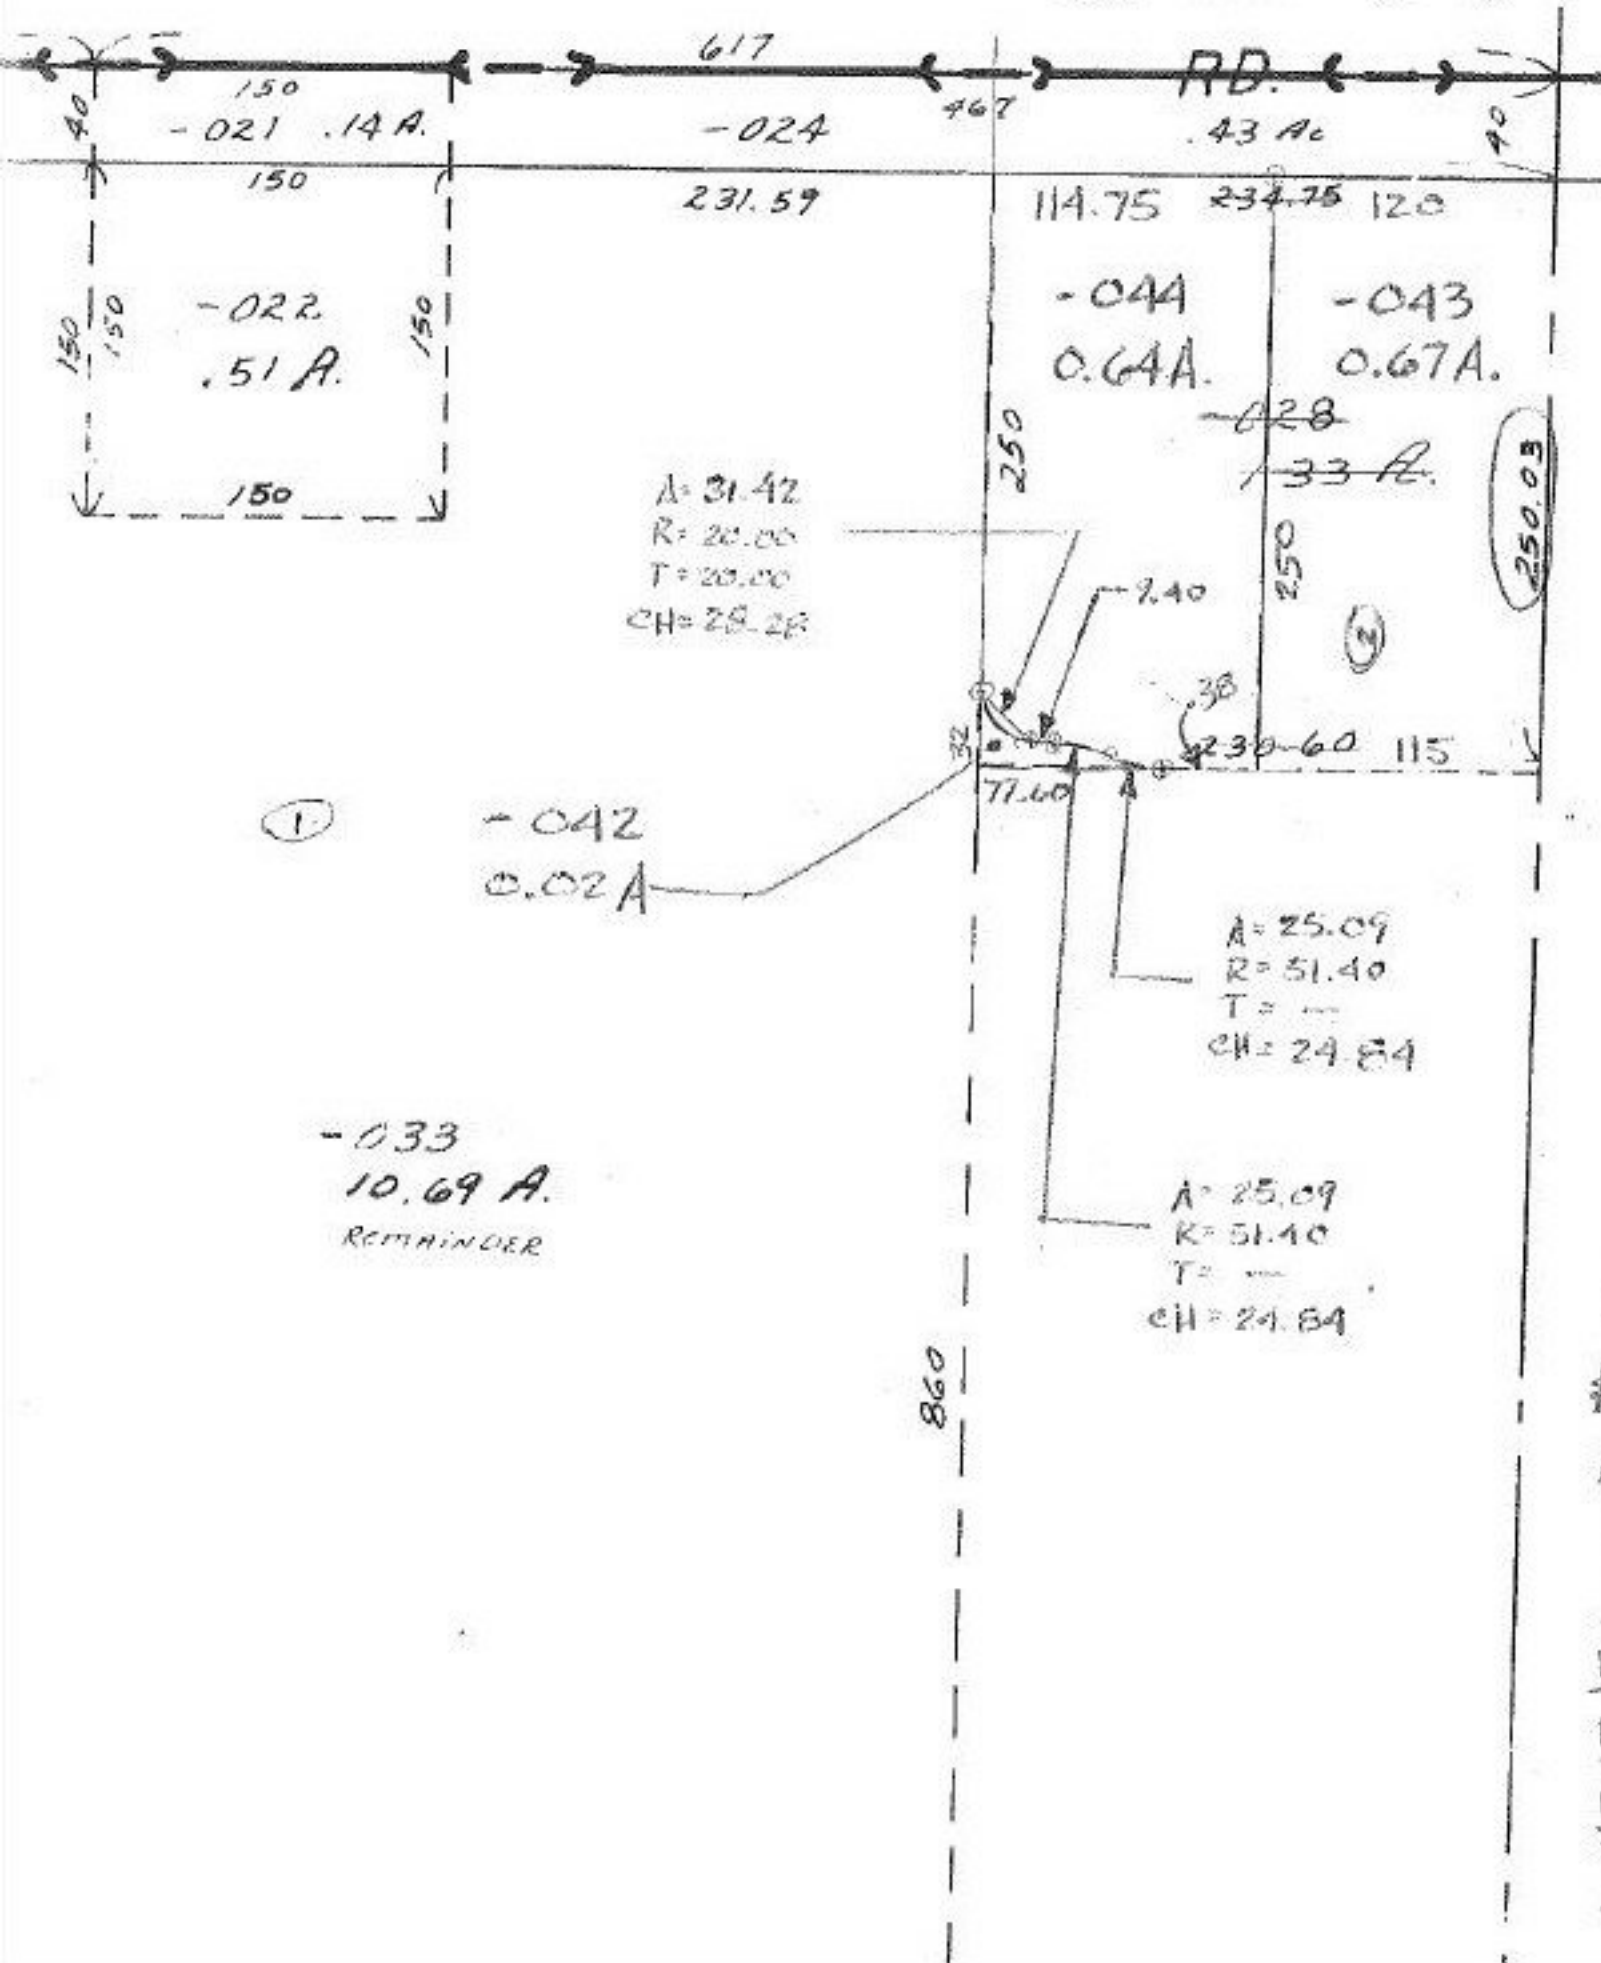

#16414

#16415

APPROVED
LORAIN CO.
MAP DEPT.

DATE 10-18-85

PAGE 5-00-041-B

BY T. McNamee

VOID 1

CH 3-28-86