


Surveyed By Arnold Koepf  
 ORIG. D. V. 858/83 & 84

272-008	115	257-008	116	169-008	117
271-009	106.95	258-009	183-024	170-009	95-024
270-010	107.16	259-010	182-025	171-010	94-025
269-011	107.37	260-011	181-026	172-011	93-026
268-012	107.58	261-012	180-027	173-012	92-027
267-013	107.79	262-013	179-028	174-013	91-028
266-014	108	263-014	178-029	175-014	90-029
265-015	108.21	264-015	177-030	176-015	89-030
30	108.42	50	100	60	100

STEEL

NATIONAL

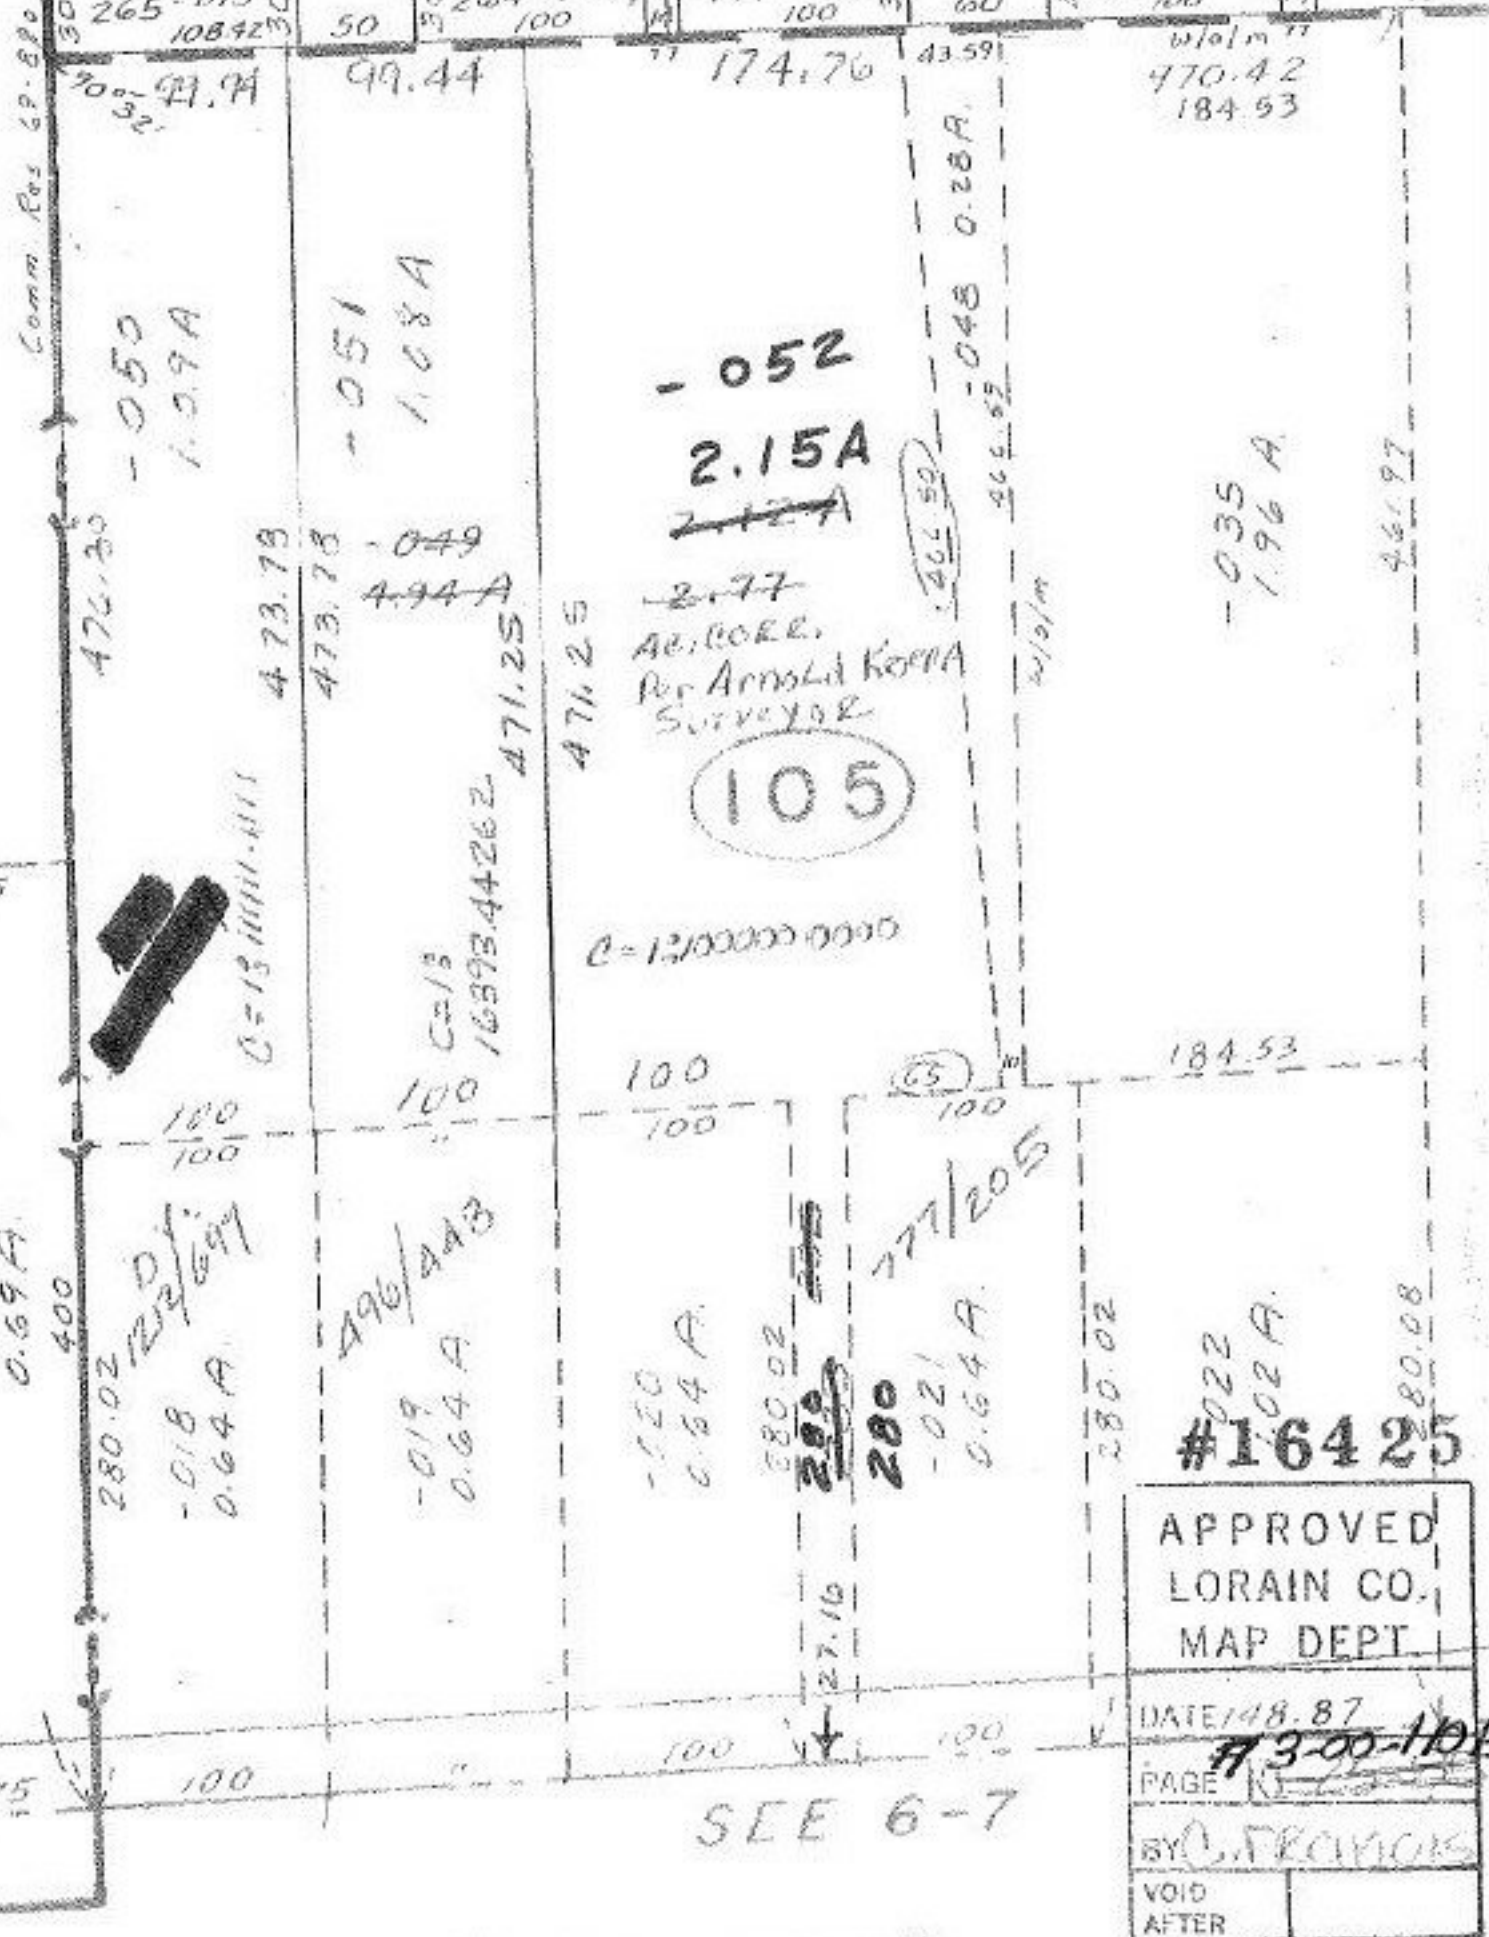

105

#16425

APPROVED  
 LORAIN CO.  
 MAP DEPT.  
 DATE 1/48.87  
 PAGE # 3-00-10  
 BY C. FRANCOIS  
 VOID AFTER

3-00-110-B

3-26-86