



Done
5-4-68
L W Hall

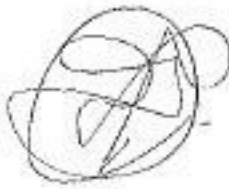

1644

APPROVED
LORAIN CO.
MAP DEPT.
DATE 3-29-68
6-79
BY <i>Bohler</i>

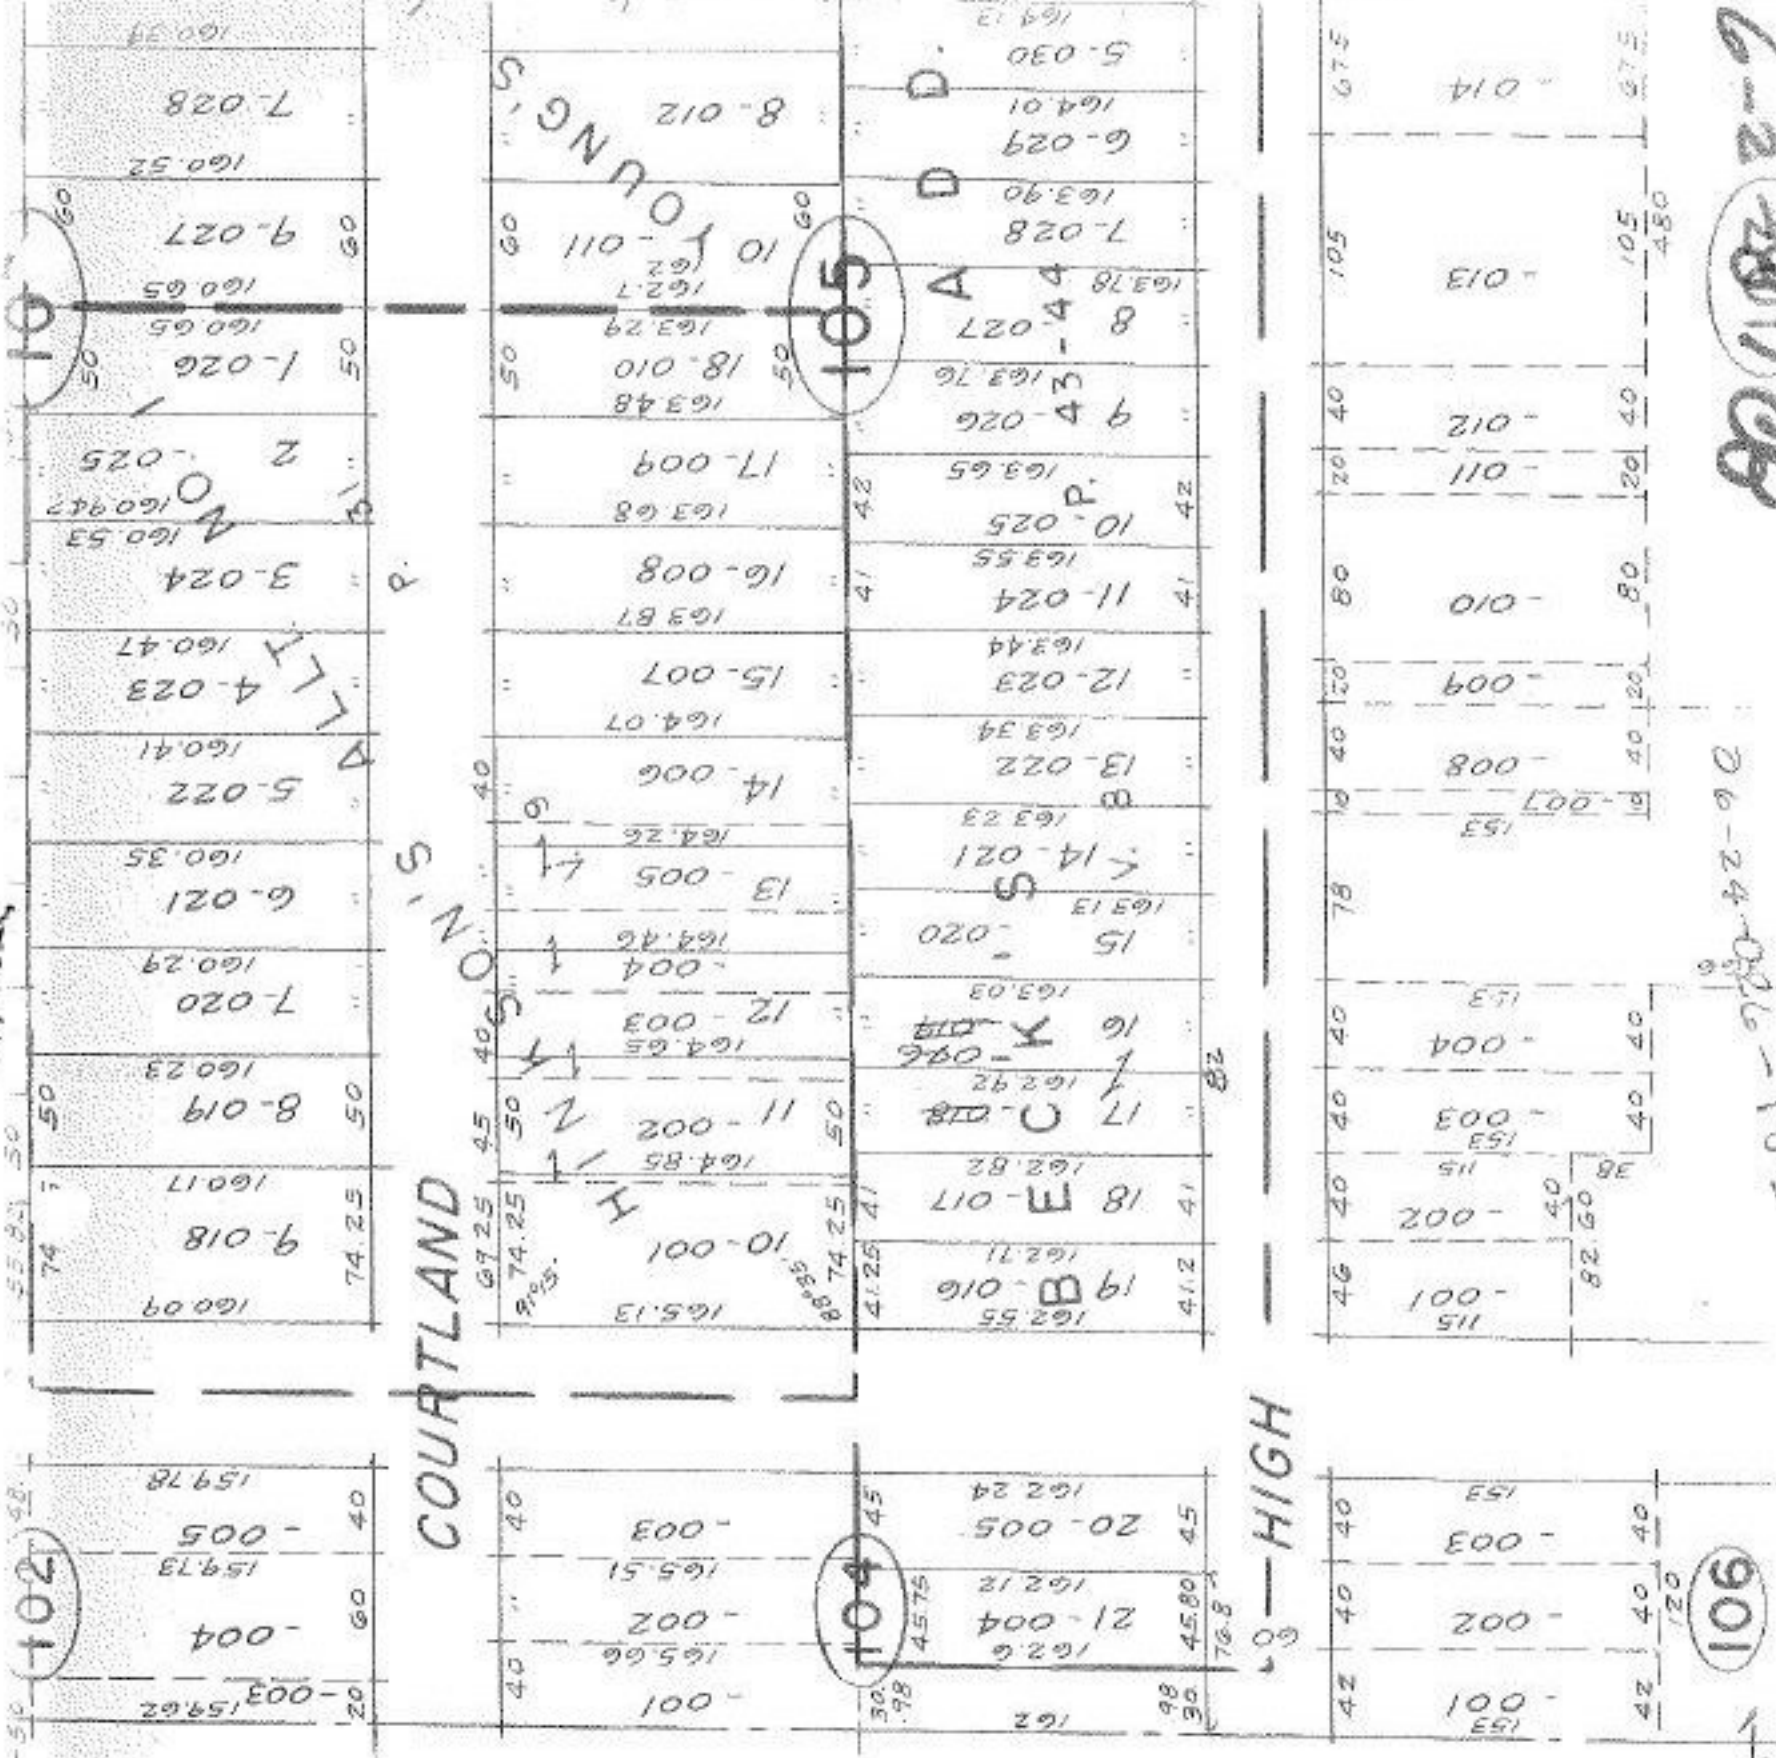

6-2-1872-9
26-24-026-105