


SEE 6-130

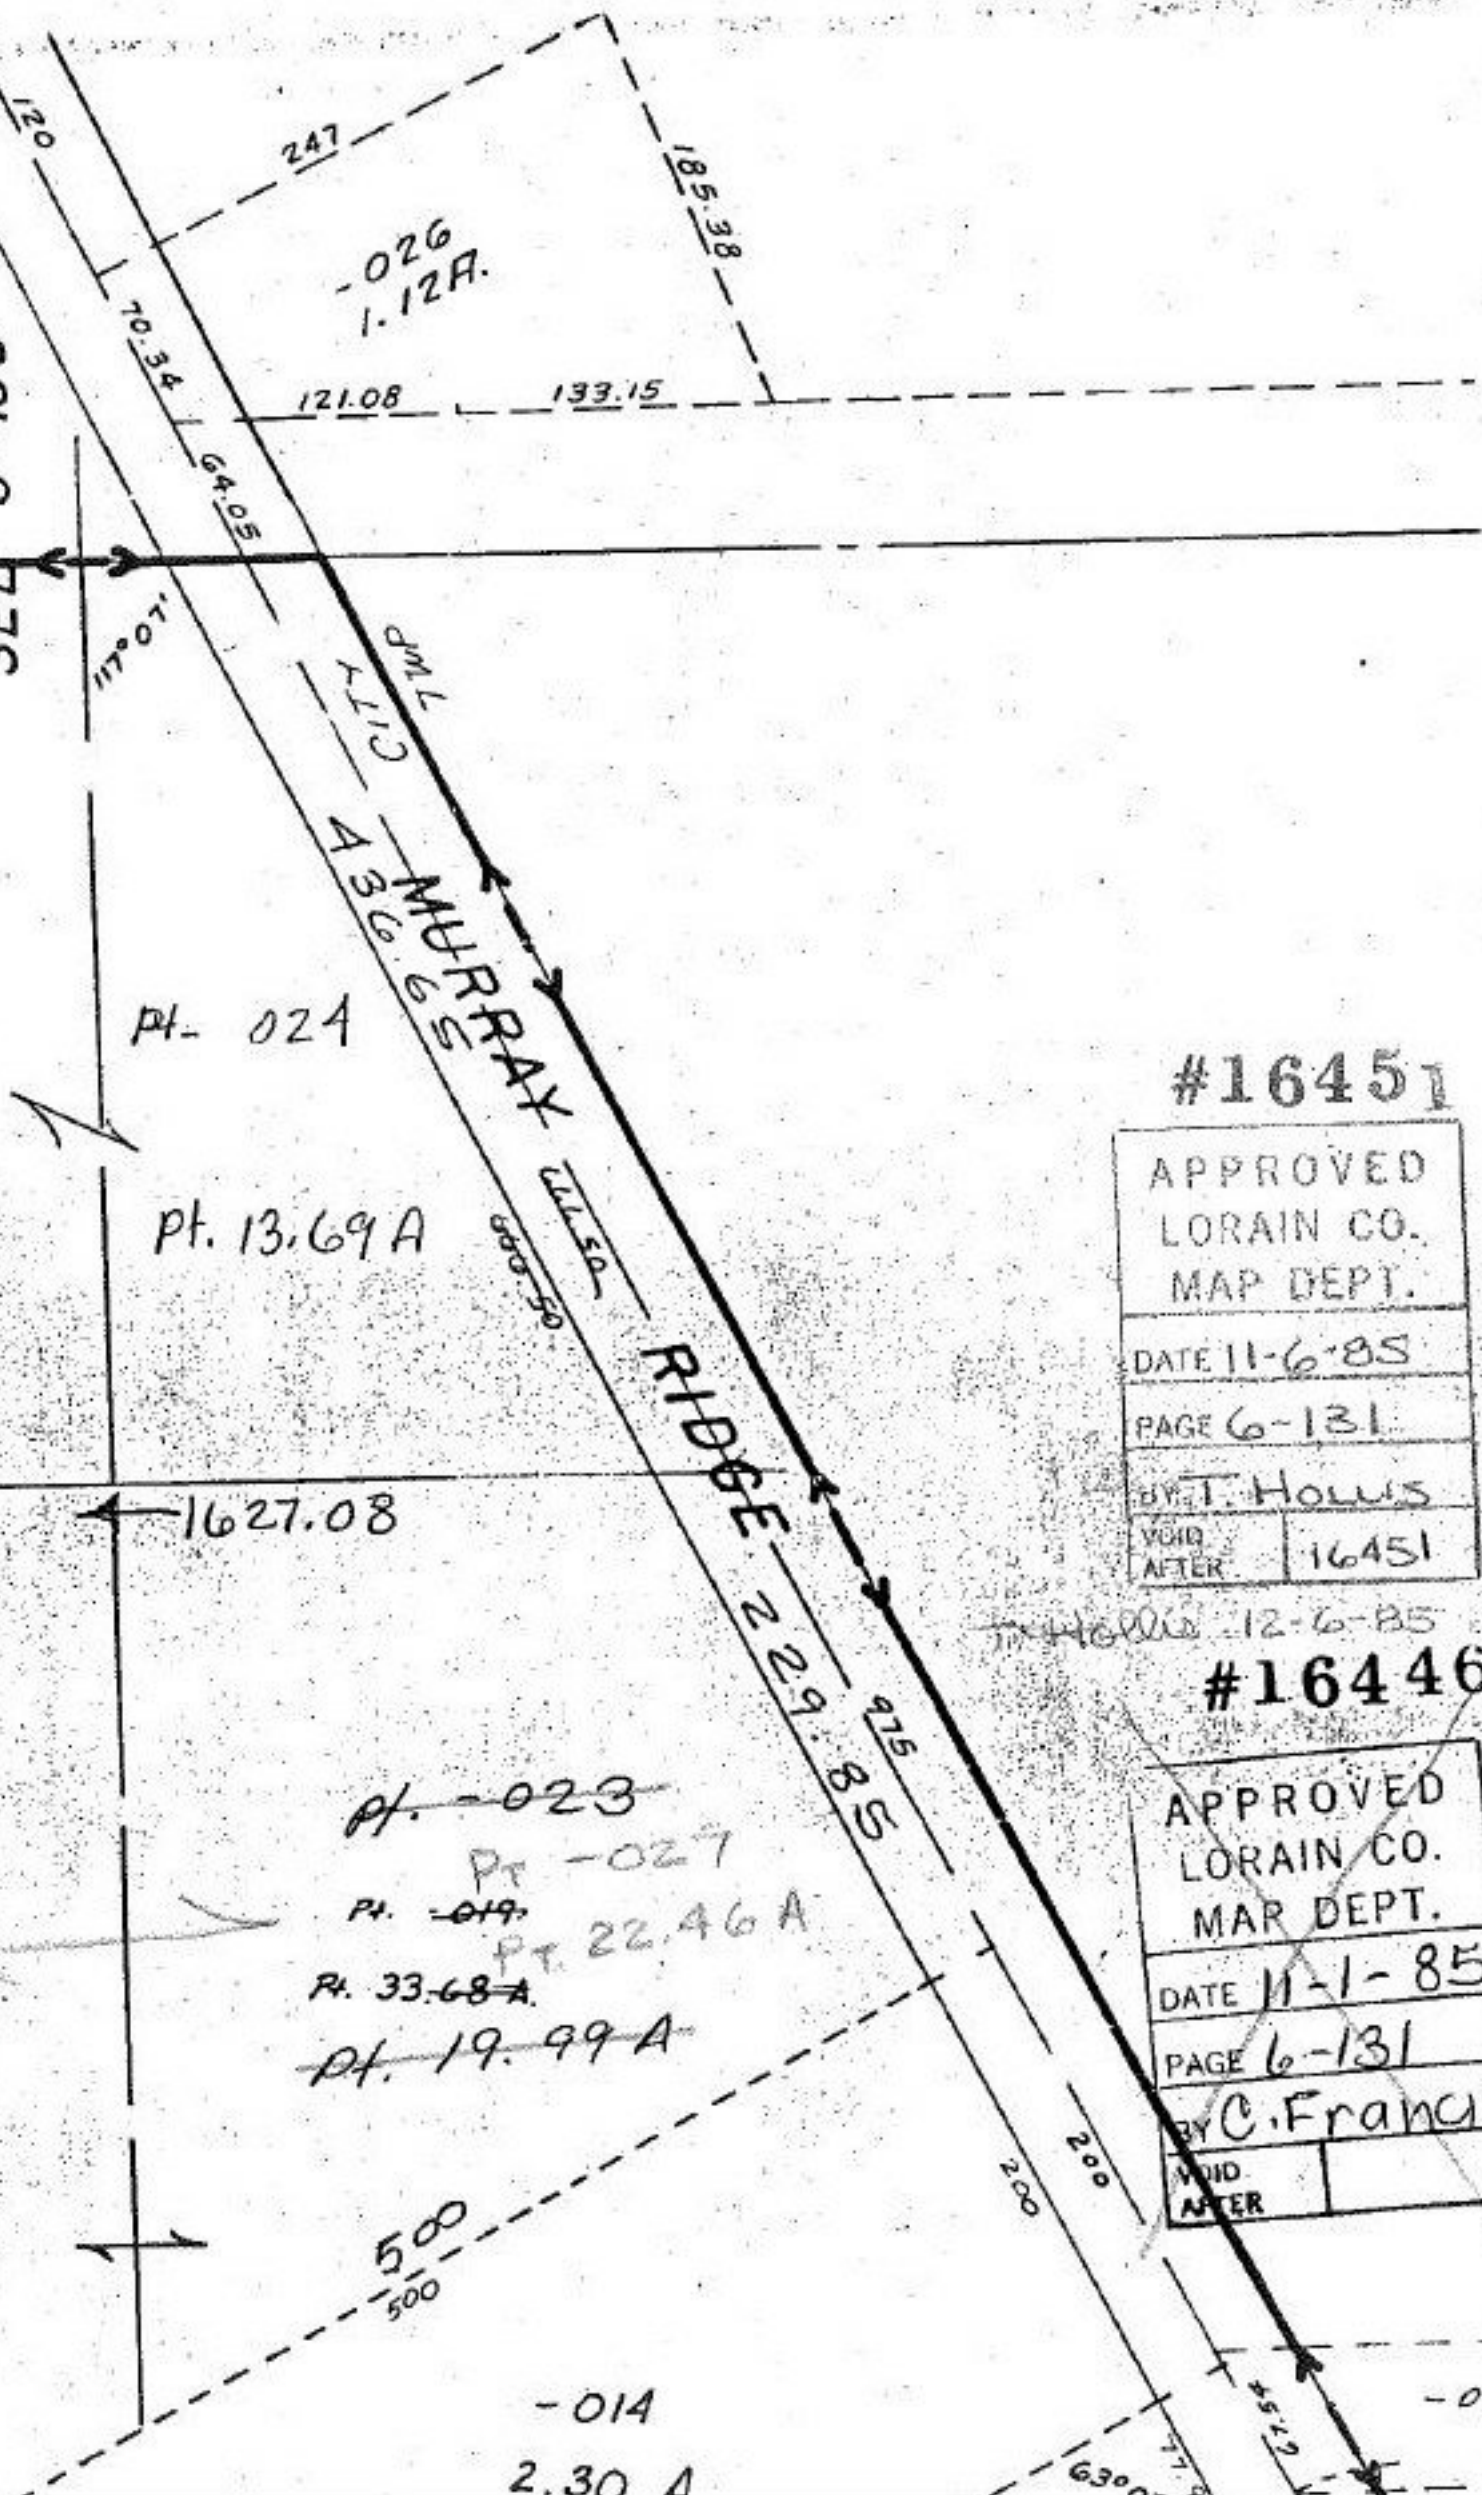

#16451

| | |
|--------------|-------|
| APPROVED | |
| LORAIN CO. | |
| MAP DEPT. | |
| DATE 11-6-85 | |
| PAGE 6-131 | |
| BY T. Howis | |
| VOID | 16451 |
| AFTER | |

T. Howis 12-6-85

#16446

| | |
|---------------|--|
| APPROVED | |
| LORAIN CO. | |
| MAR DEPT. | |
| DATE 11-1-85 | |
| PAGE 6-131 | |
| BY C. Francis | |
| VOID | |
| AFTER | |

-014
2.30 A

-012