

501


-003
4.06 A

~~101~~

-017
30.19 A.

11-00-100-~~101~~

~~-004
30.19 A.~~

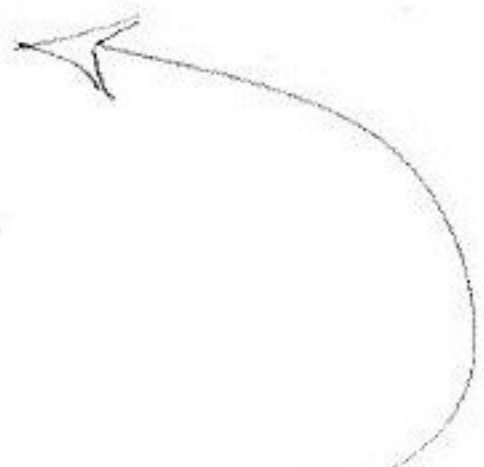

103

PARCEL
BLOCK
CORRECTION

#16468

APPROVED
LORAIN CO.
MAP DEPT.

DATE 11-18-85

PAGE 11-00-100-A

BY J. McMan

VOID

4-9-86

1585.83

874.40
879.90

95