

SEE 10-00-008-F

104.62

856.20

-181
5.80A

-183
5.52A

-170
6.94A

Survey By
R. SIMON

300

514.86

120.38
98.20

200


27.19

-053
1.49A

R-50
Ch-68.16

135

-179
0.98A

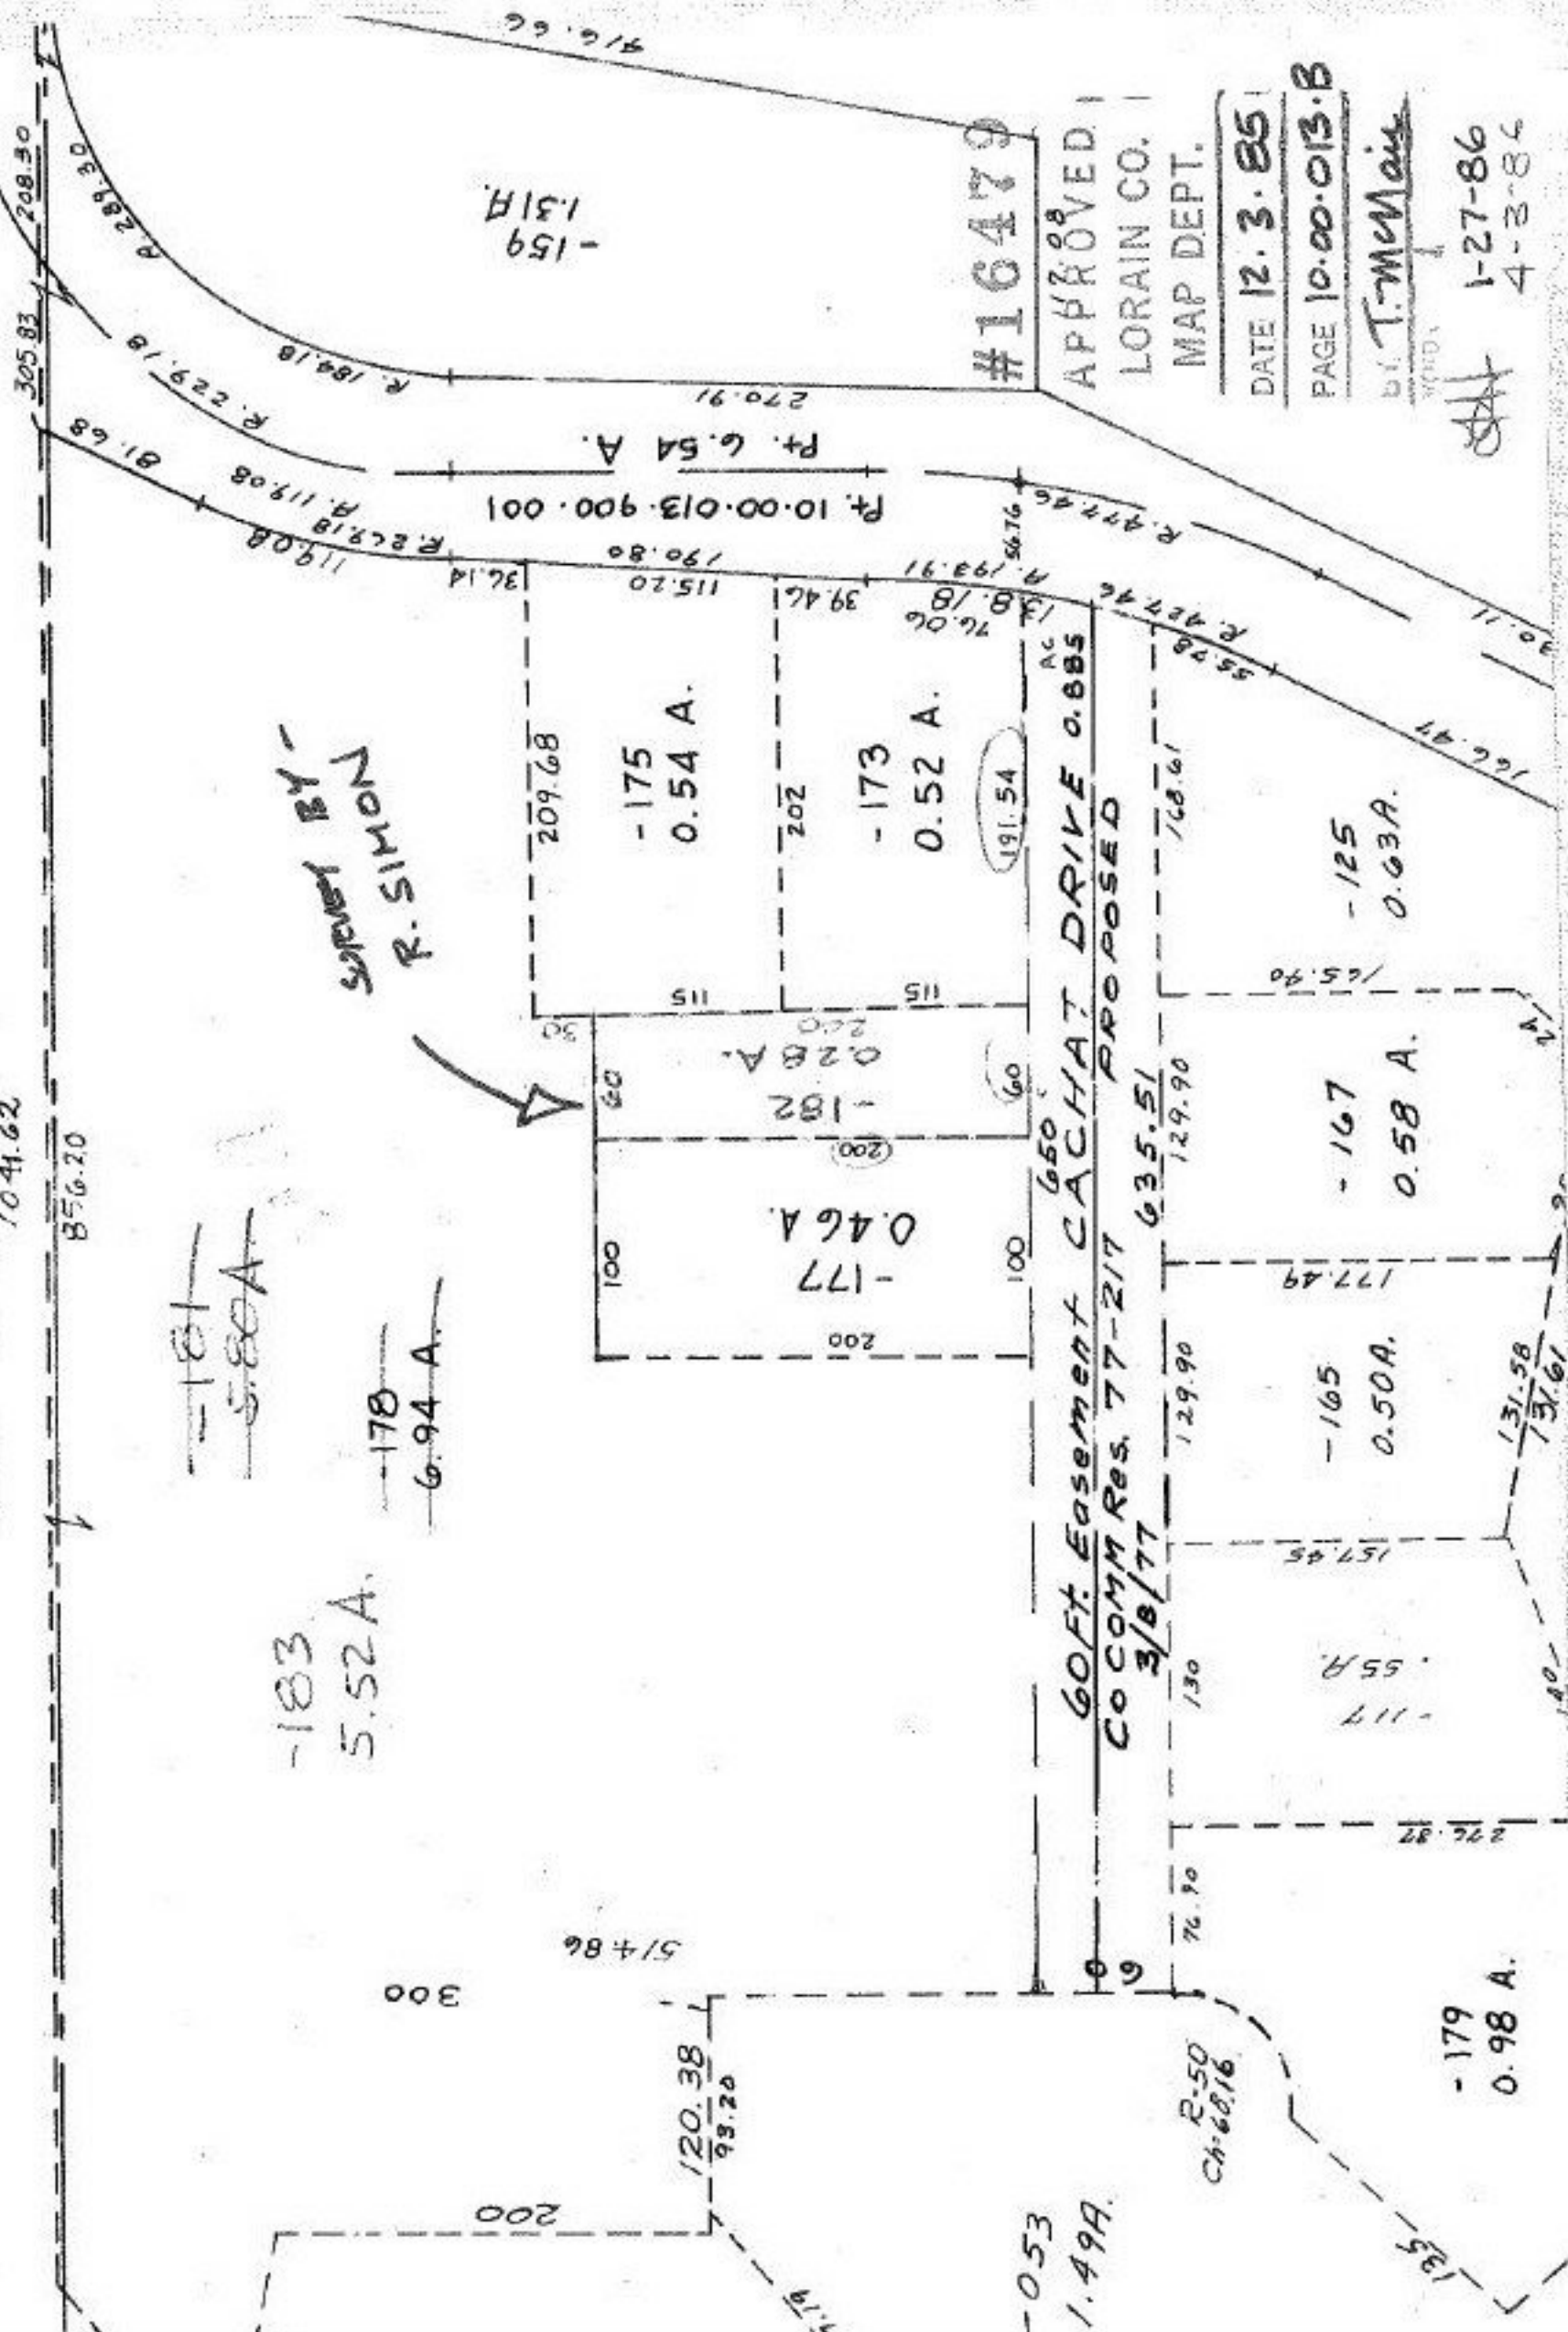

-159
1.31A

Pt. 6.54 A.

Pt. 10.00-013.900-001

115.20

39.46

115

115

#16479

APPROVED

LORAIN CO.

MAP DEPT.

DATE 12.3.85

PAGE 10.00-013.B

by T. McManis

1-27-86

4-3-86