


SEE 12-00-076-B

756.84

ELYRIA TWINSBURG



RD.

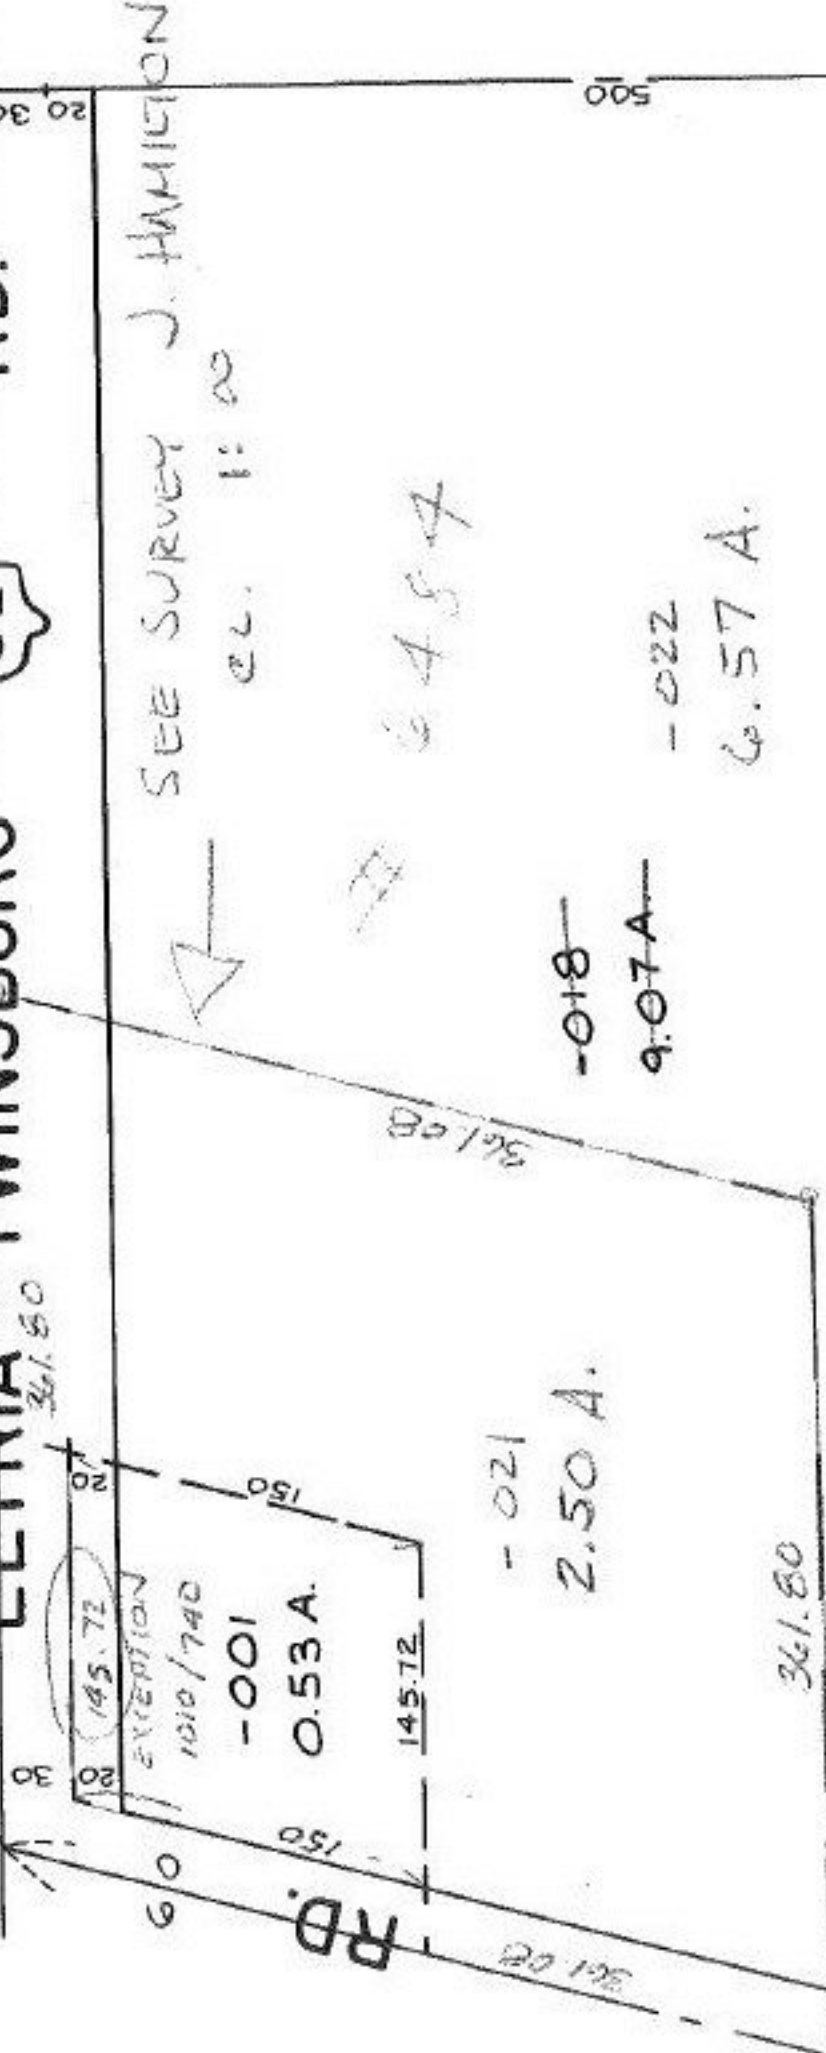

4-15-86
#16484

APPROVED
LORAIN CO.
MAP DEPT.

DATE 12.6.85

PAGE 12.00.075.B

BY T. McMain

VOID
IF
REPLACED

104