


-003
13.85A

-008
13.44 A.

105

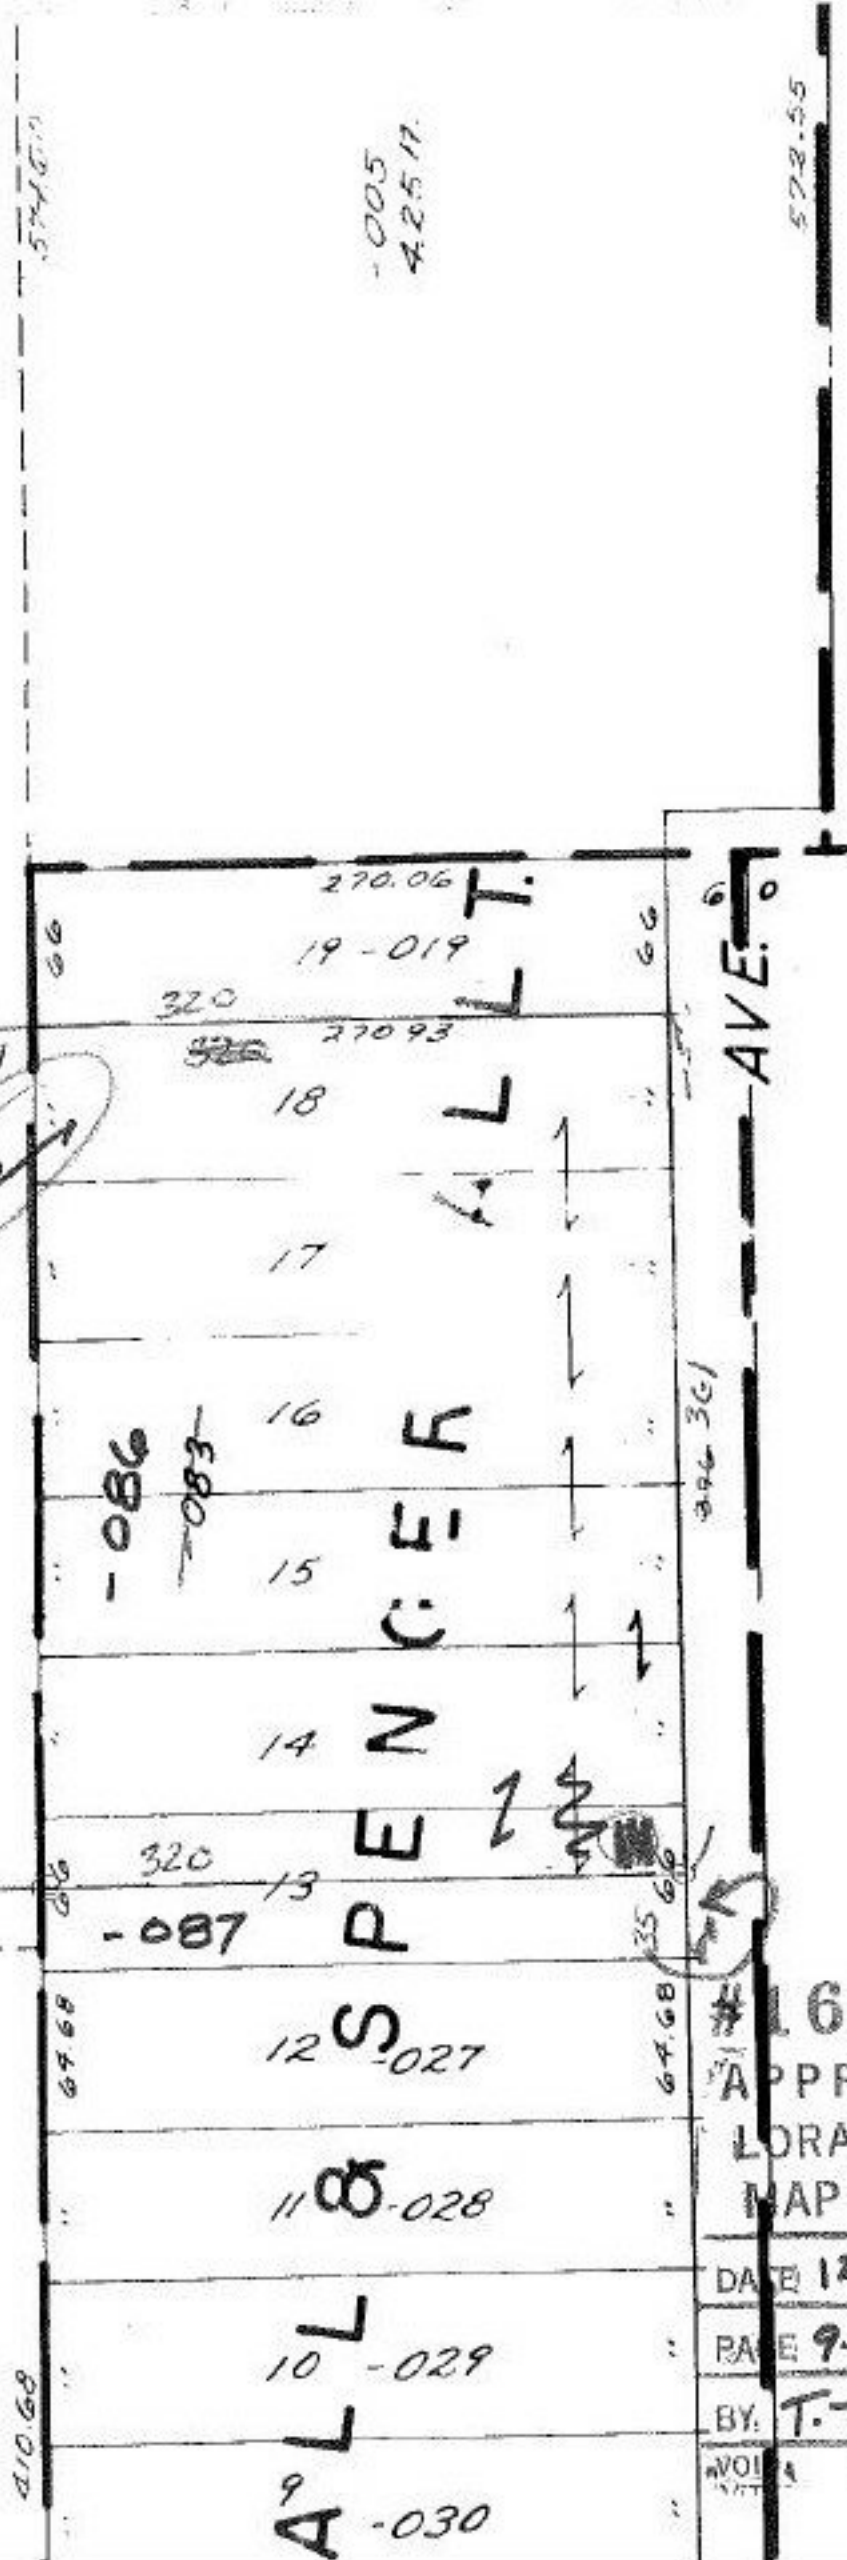

-005
4.25 A.

SEE 9-00-075-B

639.04?

-004
6.00A.

#16498
 APPROVED,
 LORAIN CO.
 MAP DEPT.
 DATE 12.12.85
 BY 9.00.075.A
 T. McMain