




?

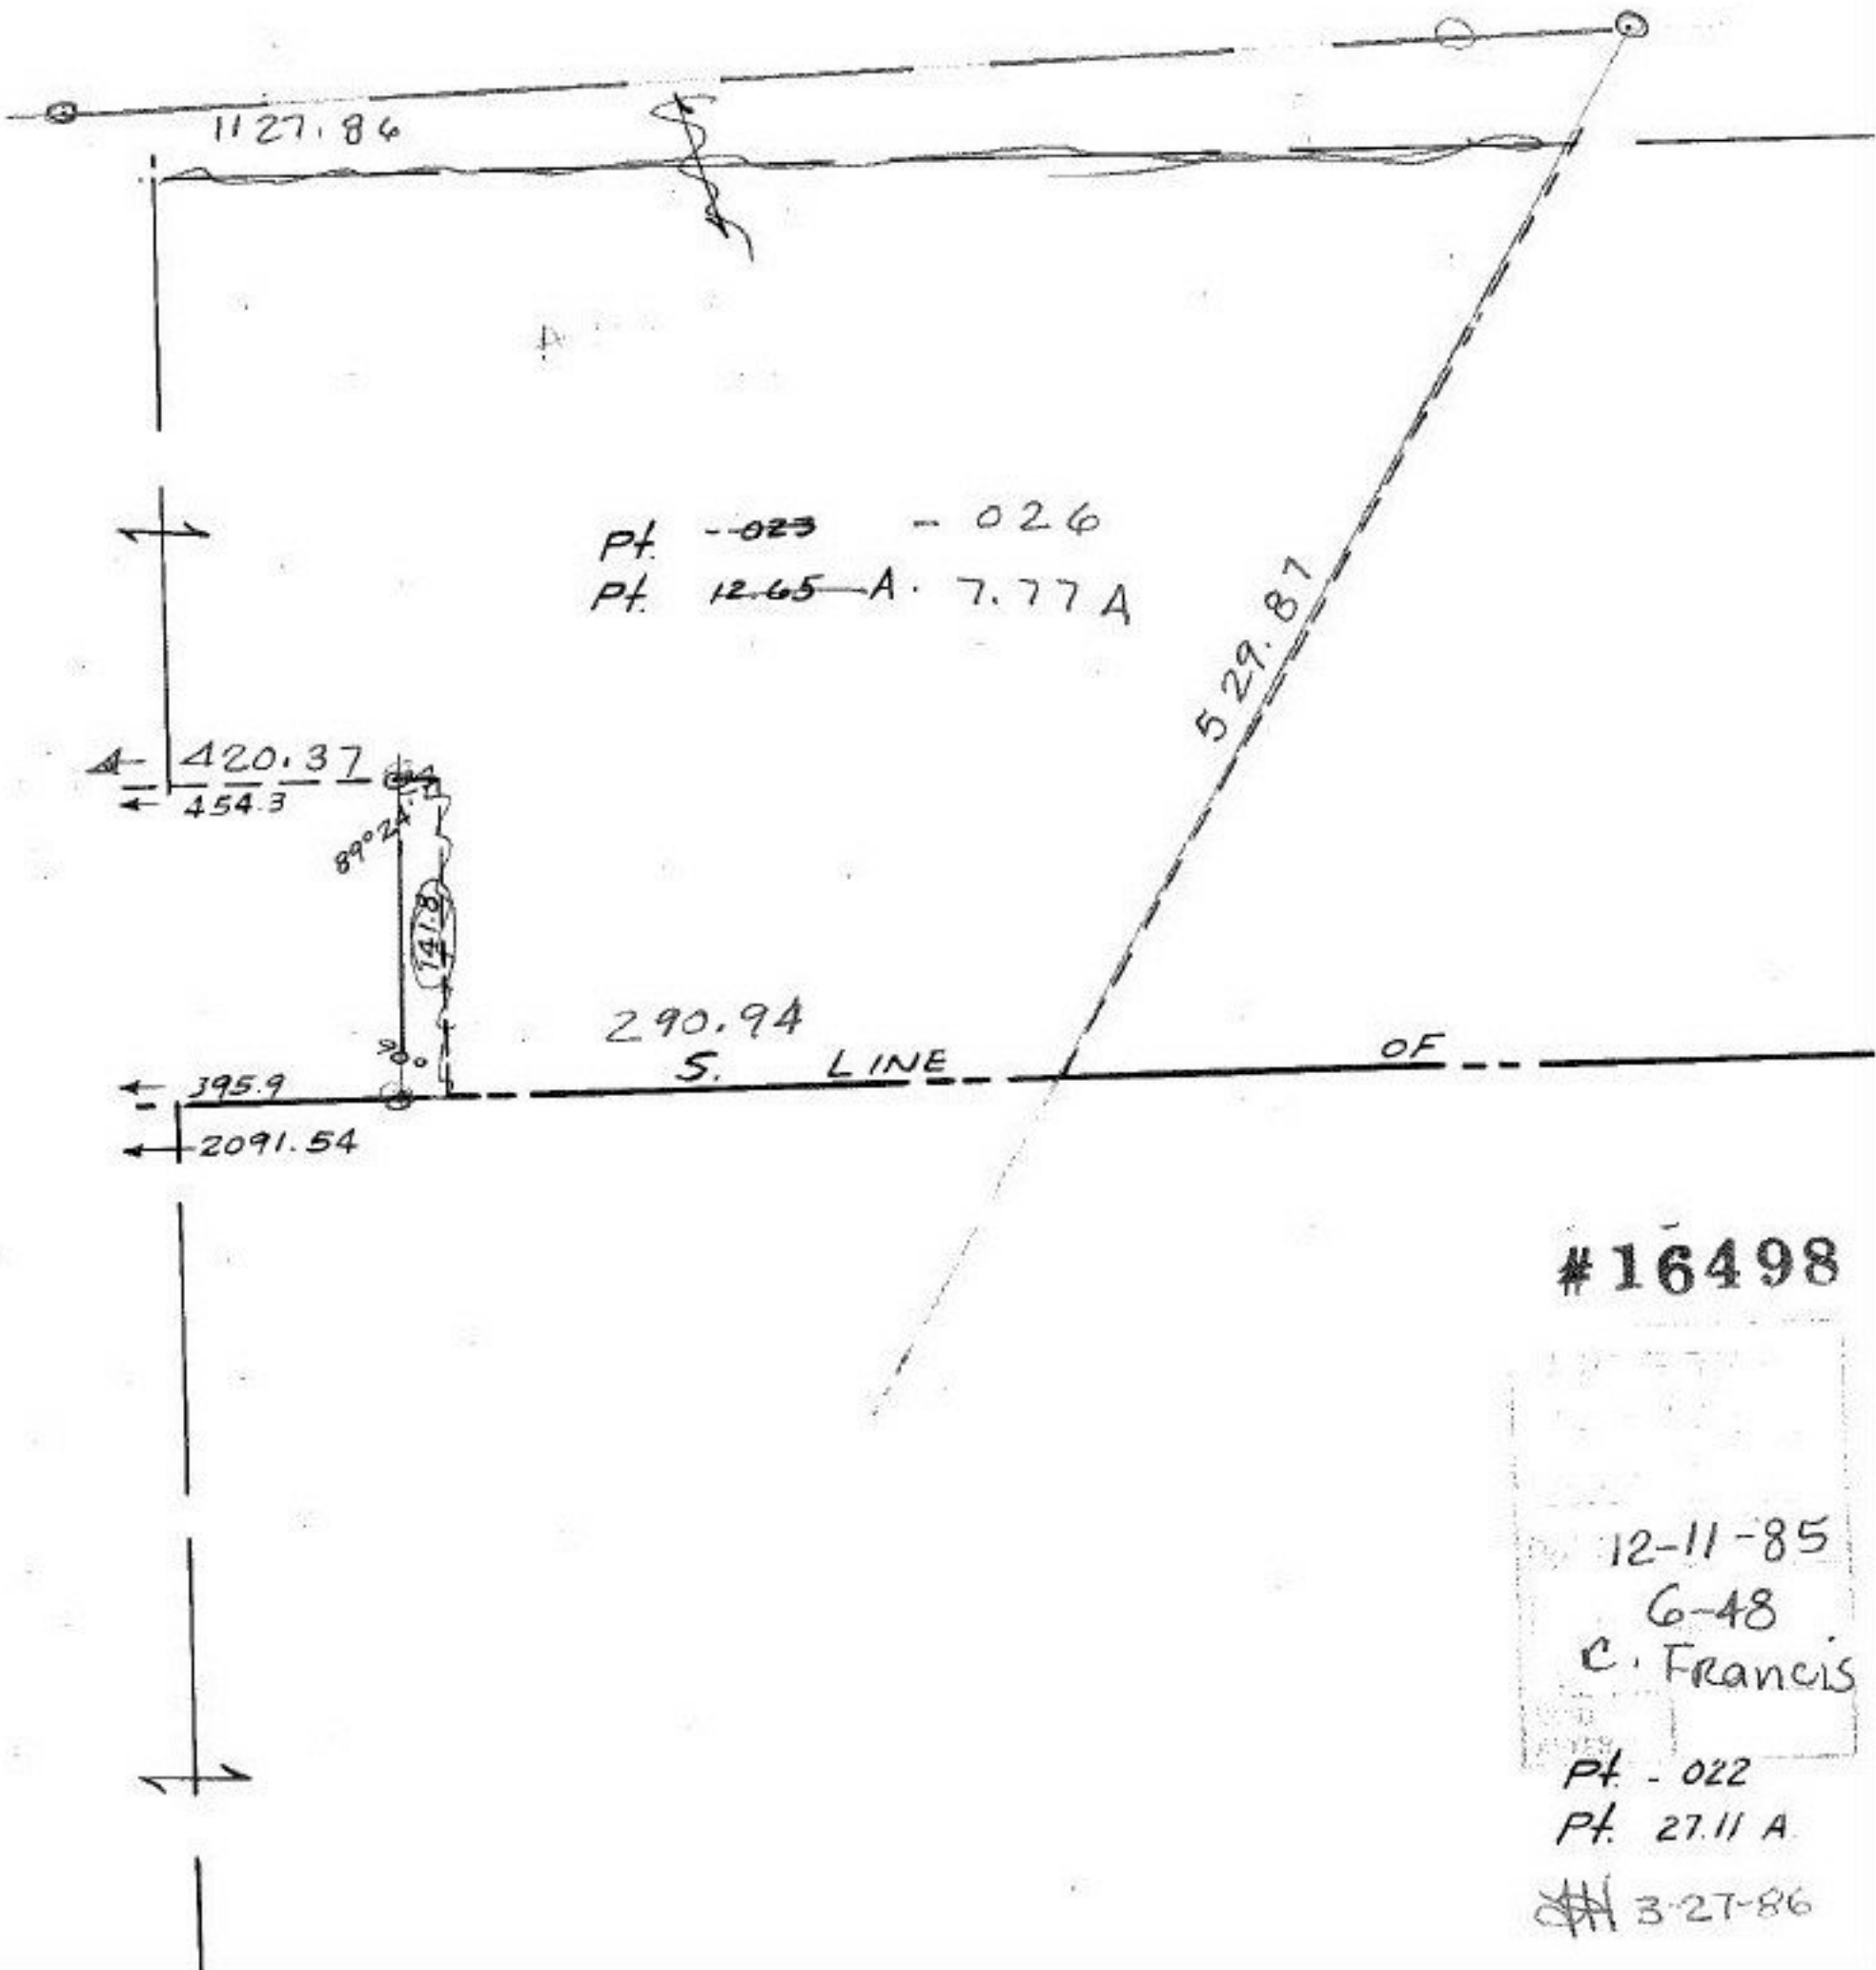

#16498

12-11-85

G-48

C. Francis

Pt. - 022

Pt. 27.11 A

3-27-86