


-002  
7.00A

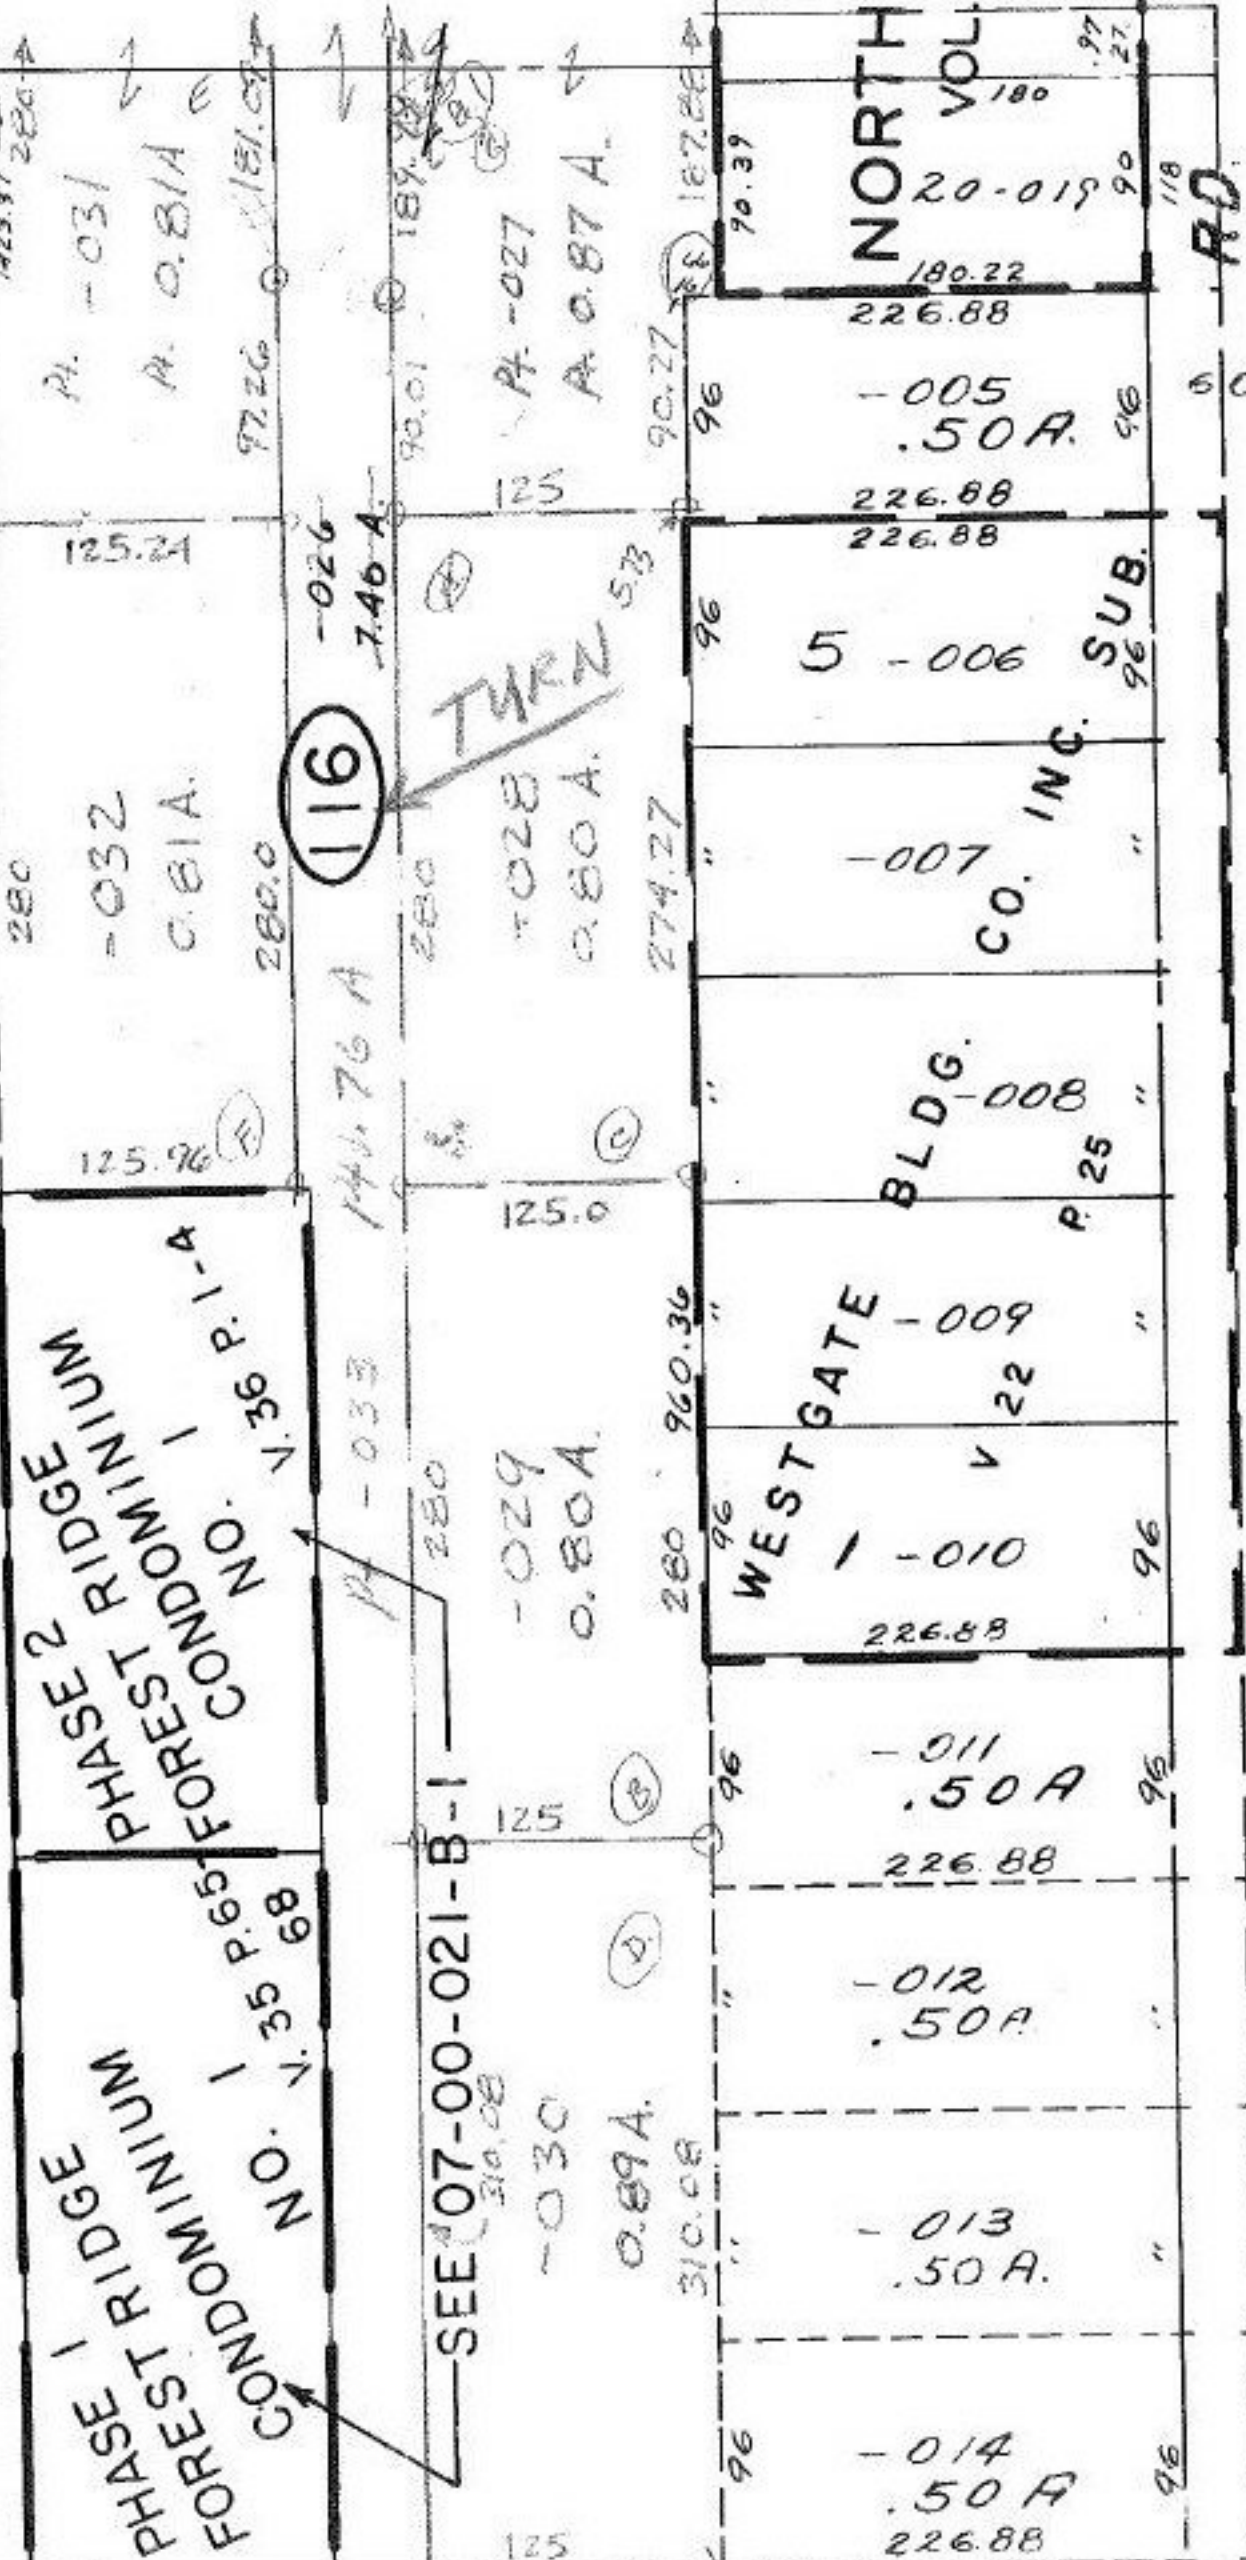

7.00.021-B

*[Handwritten signature]*

#16507

APPROVED  
LORAIN CO.  
MAP DEPT.

DATE 12.20.85

PAGE 7.00.021-B

BY T. McNeil

VOID

#4-1-86