


C = 500,000,000

92.8 d

124 WD
SR. 83

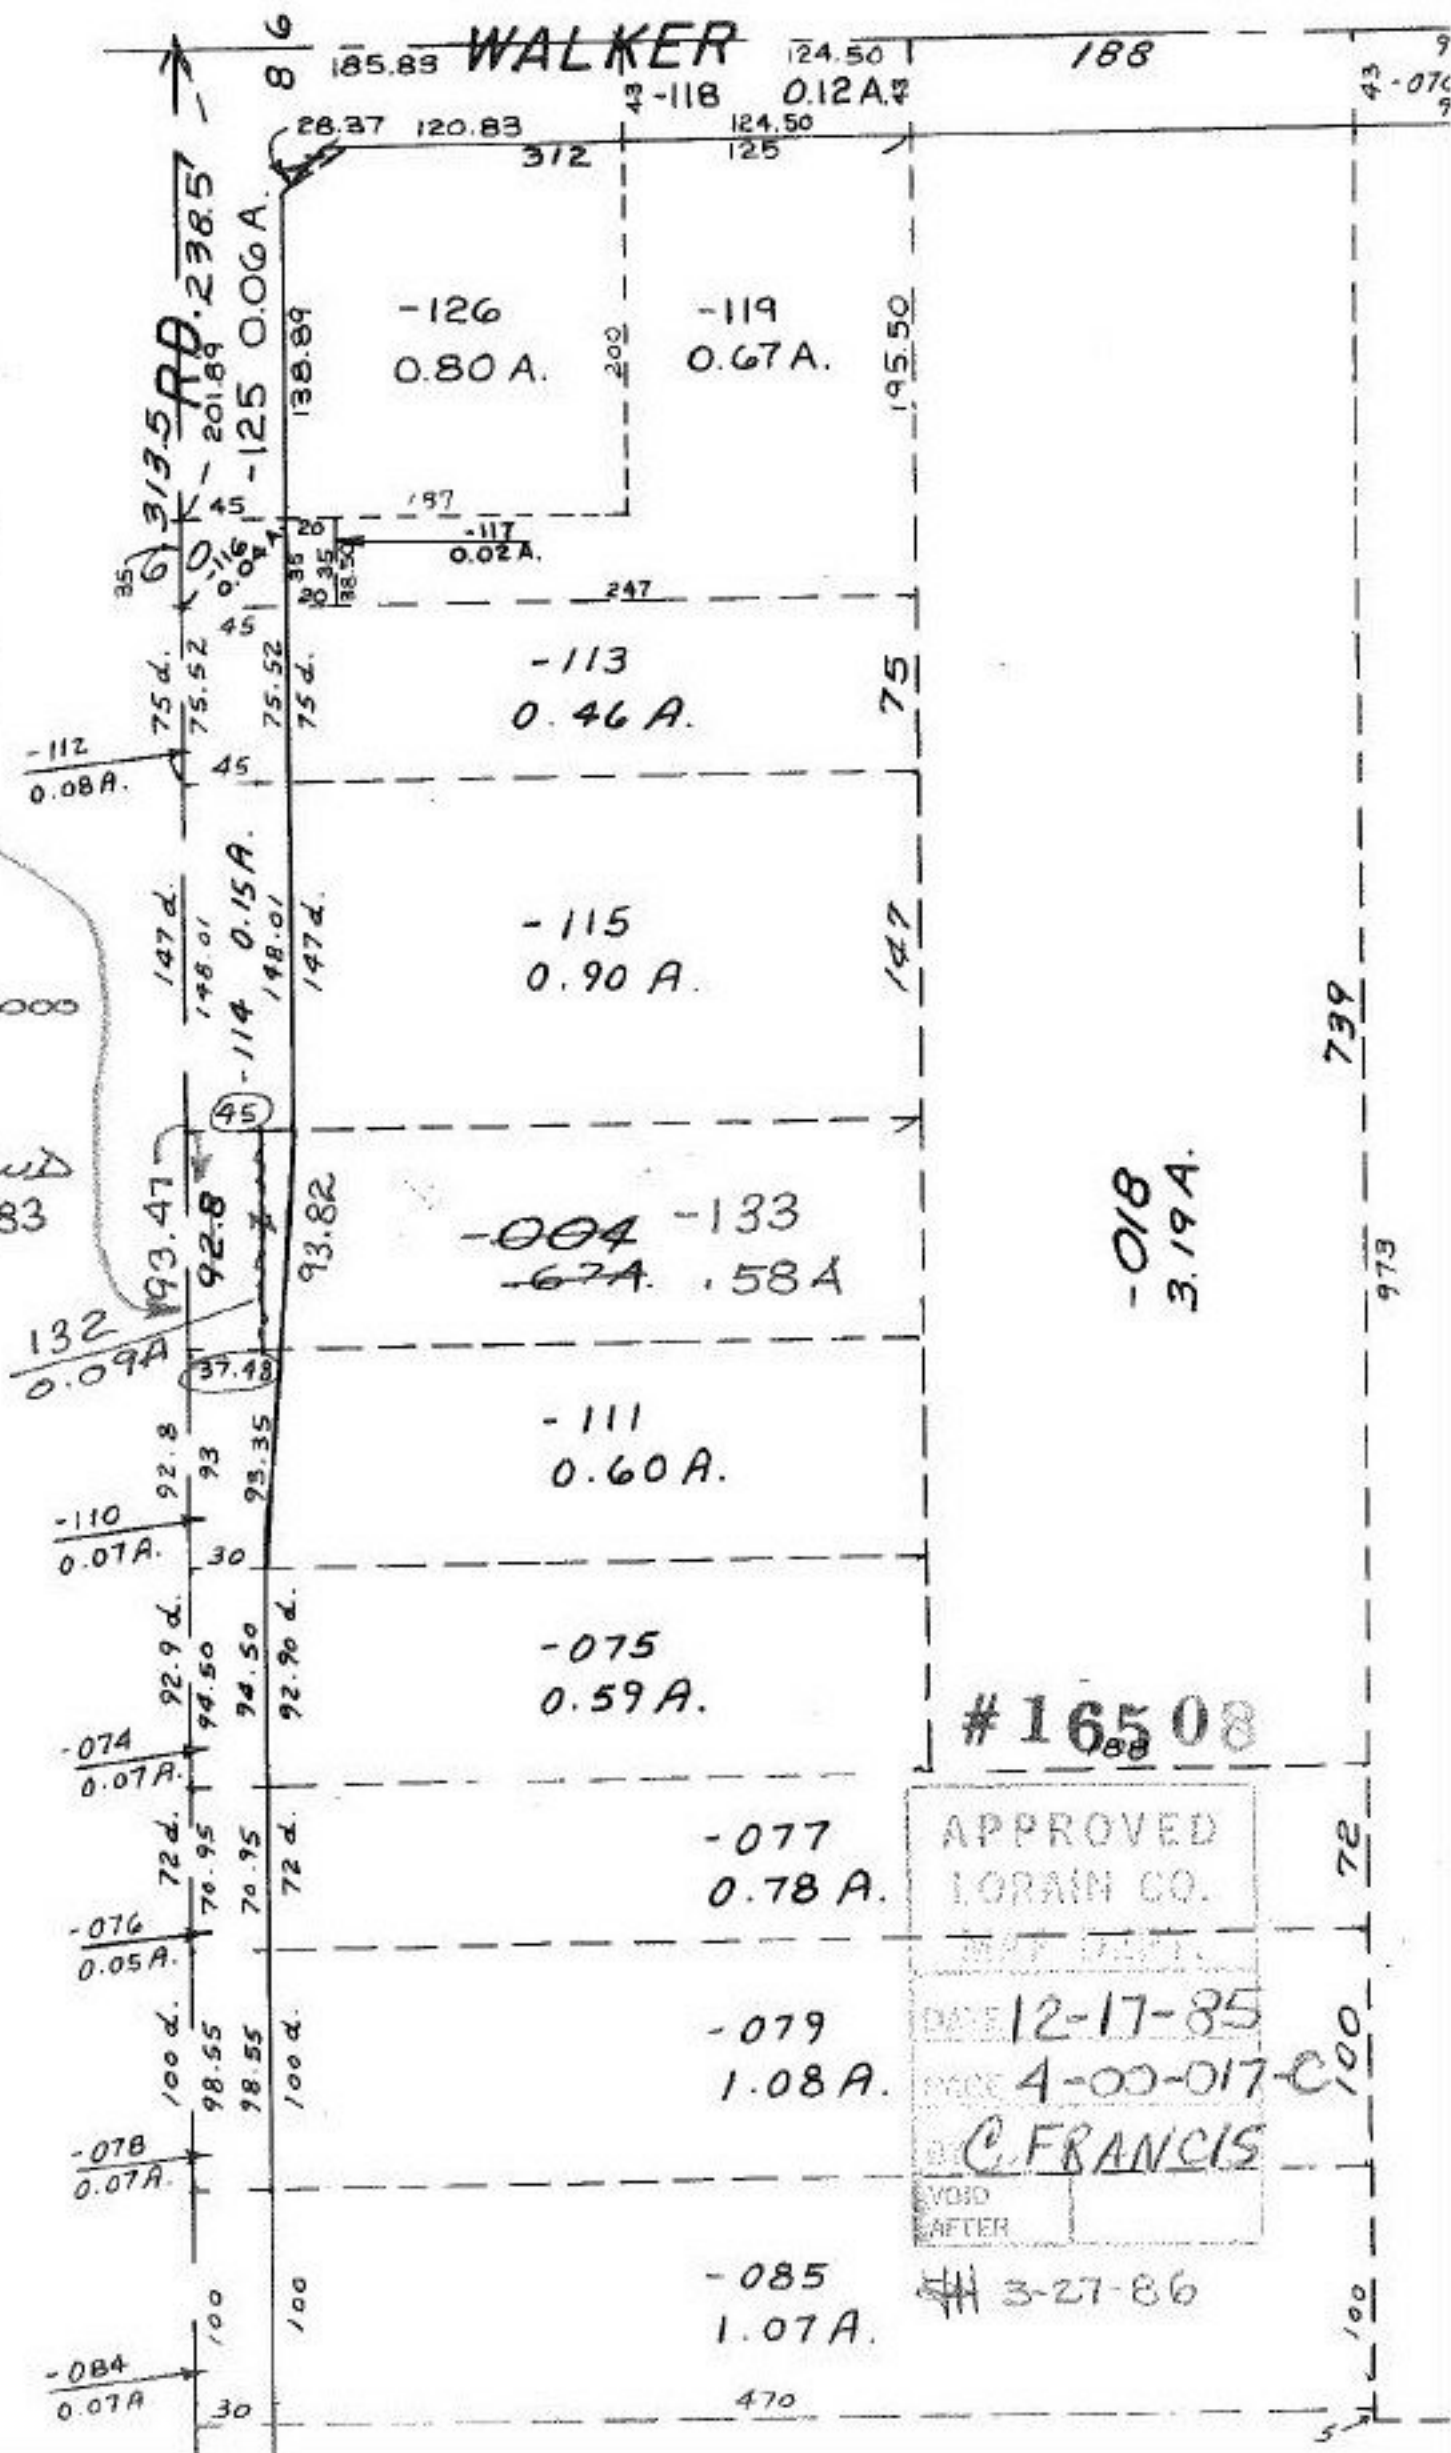

16508

APPROVED
LORAIN CO.
DATE 12-17-85
PAGE 4-00-017-C
C. FRANCIS
VOID AFTER

3-27-86