


PARCEL Number

Ac. CORR. ONLY

10

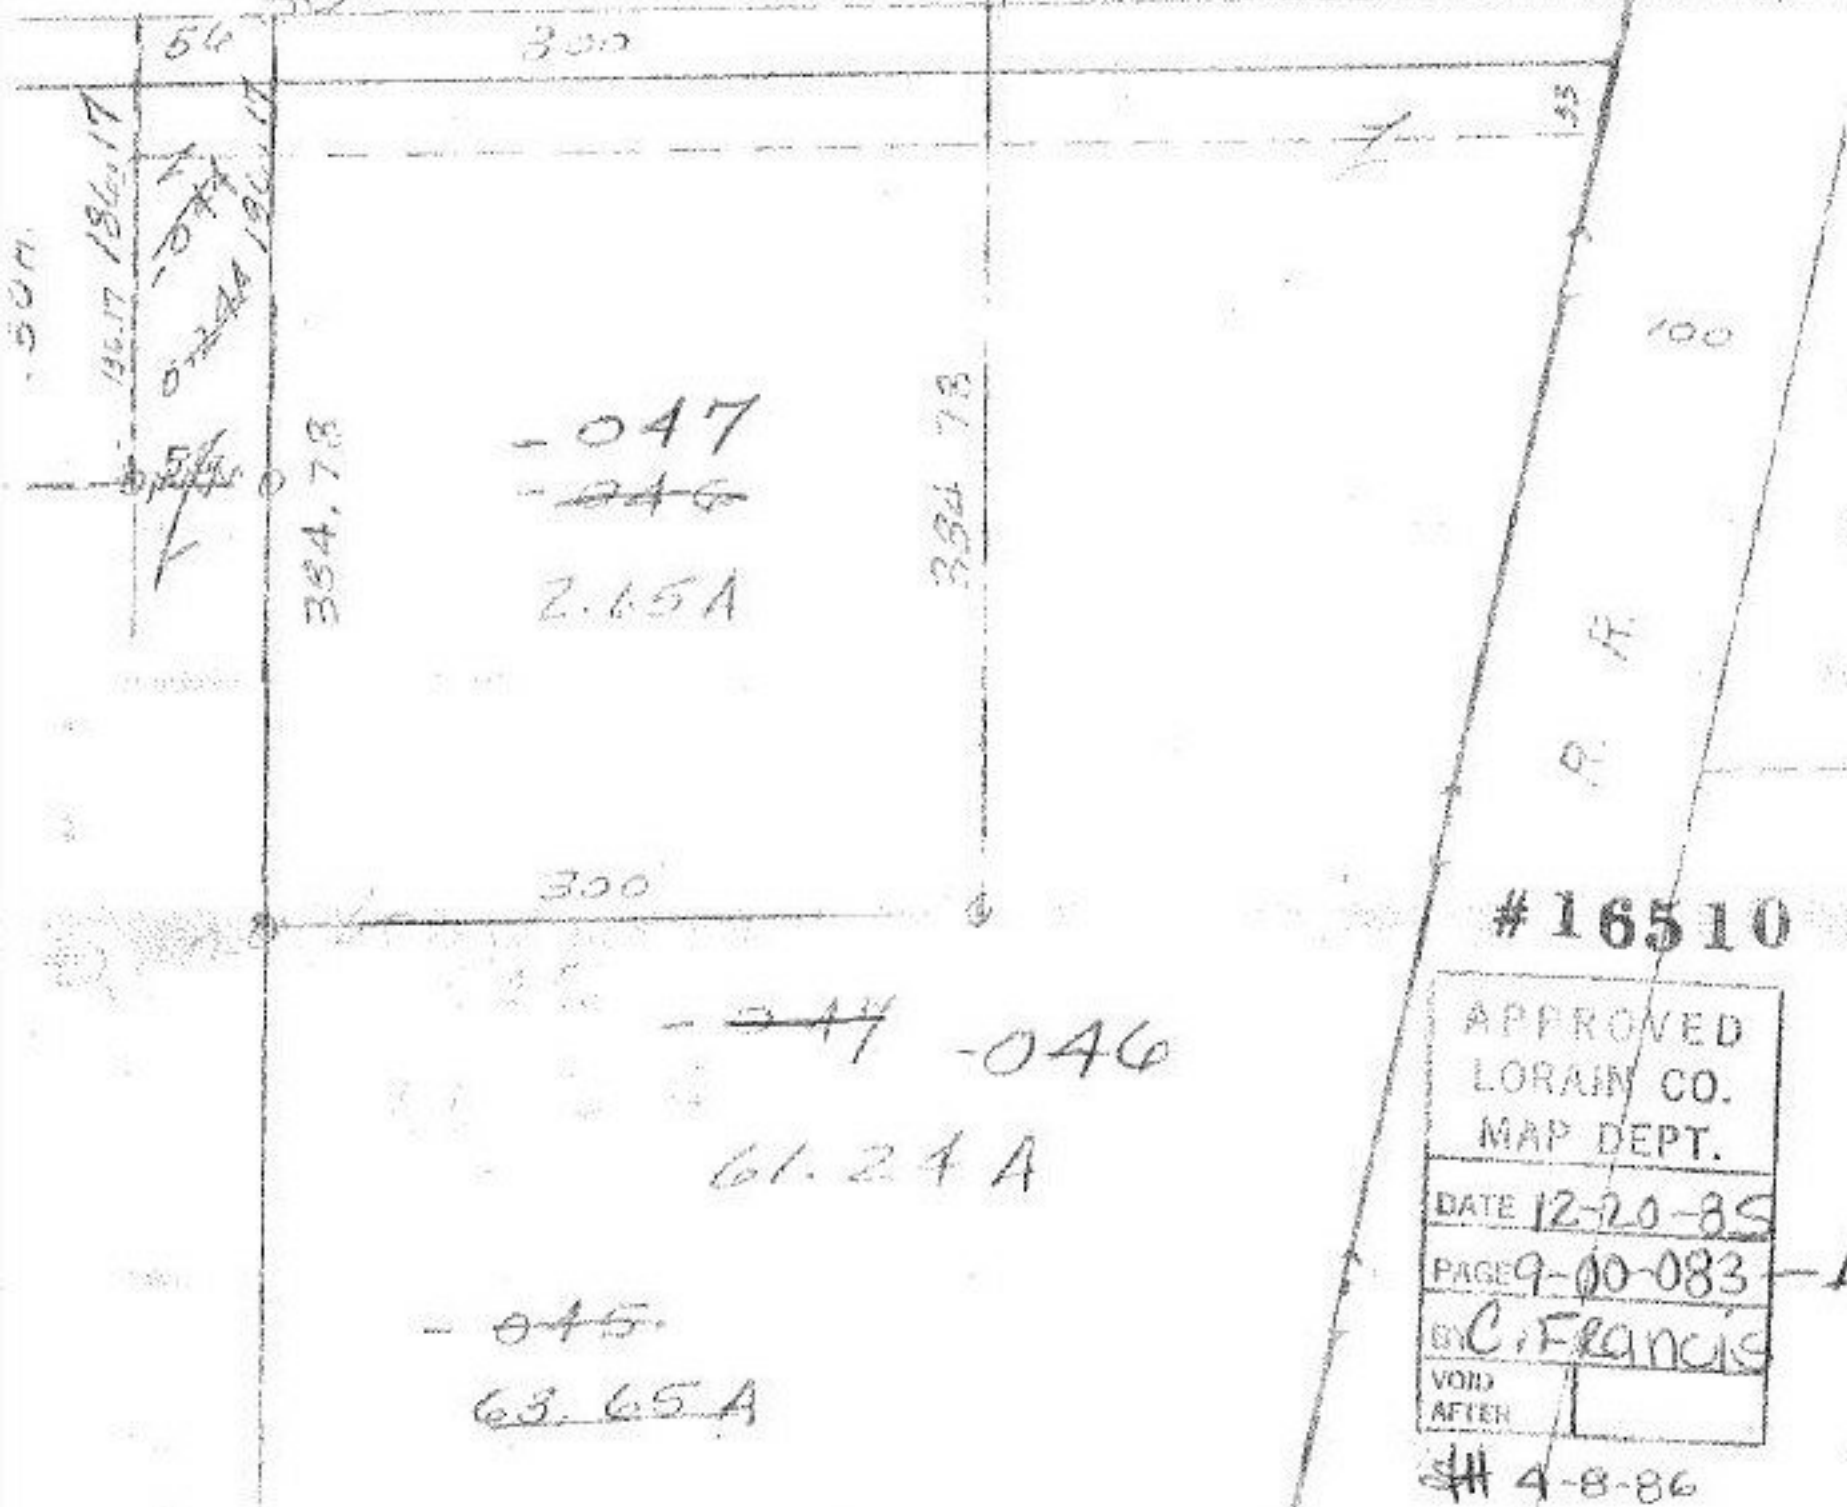

Surveyed by Laurence
Brown, Capt. of ...

This is to CORR.
PARCEL Numbers IN
SPLIT No. #46392

See Deed Vol. 1385/21

[REDACTED]

APPROVED
LORAIN CO.
MAP DEPT.
DATE 12-20-85
PAGE 9-00-083 - A
BY C. FRANCIS
VOID AFTER