


to a separate rd

SEE 12-00-082-A
152055
1045 55 B.M.

SEE 12-00-082-A

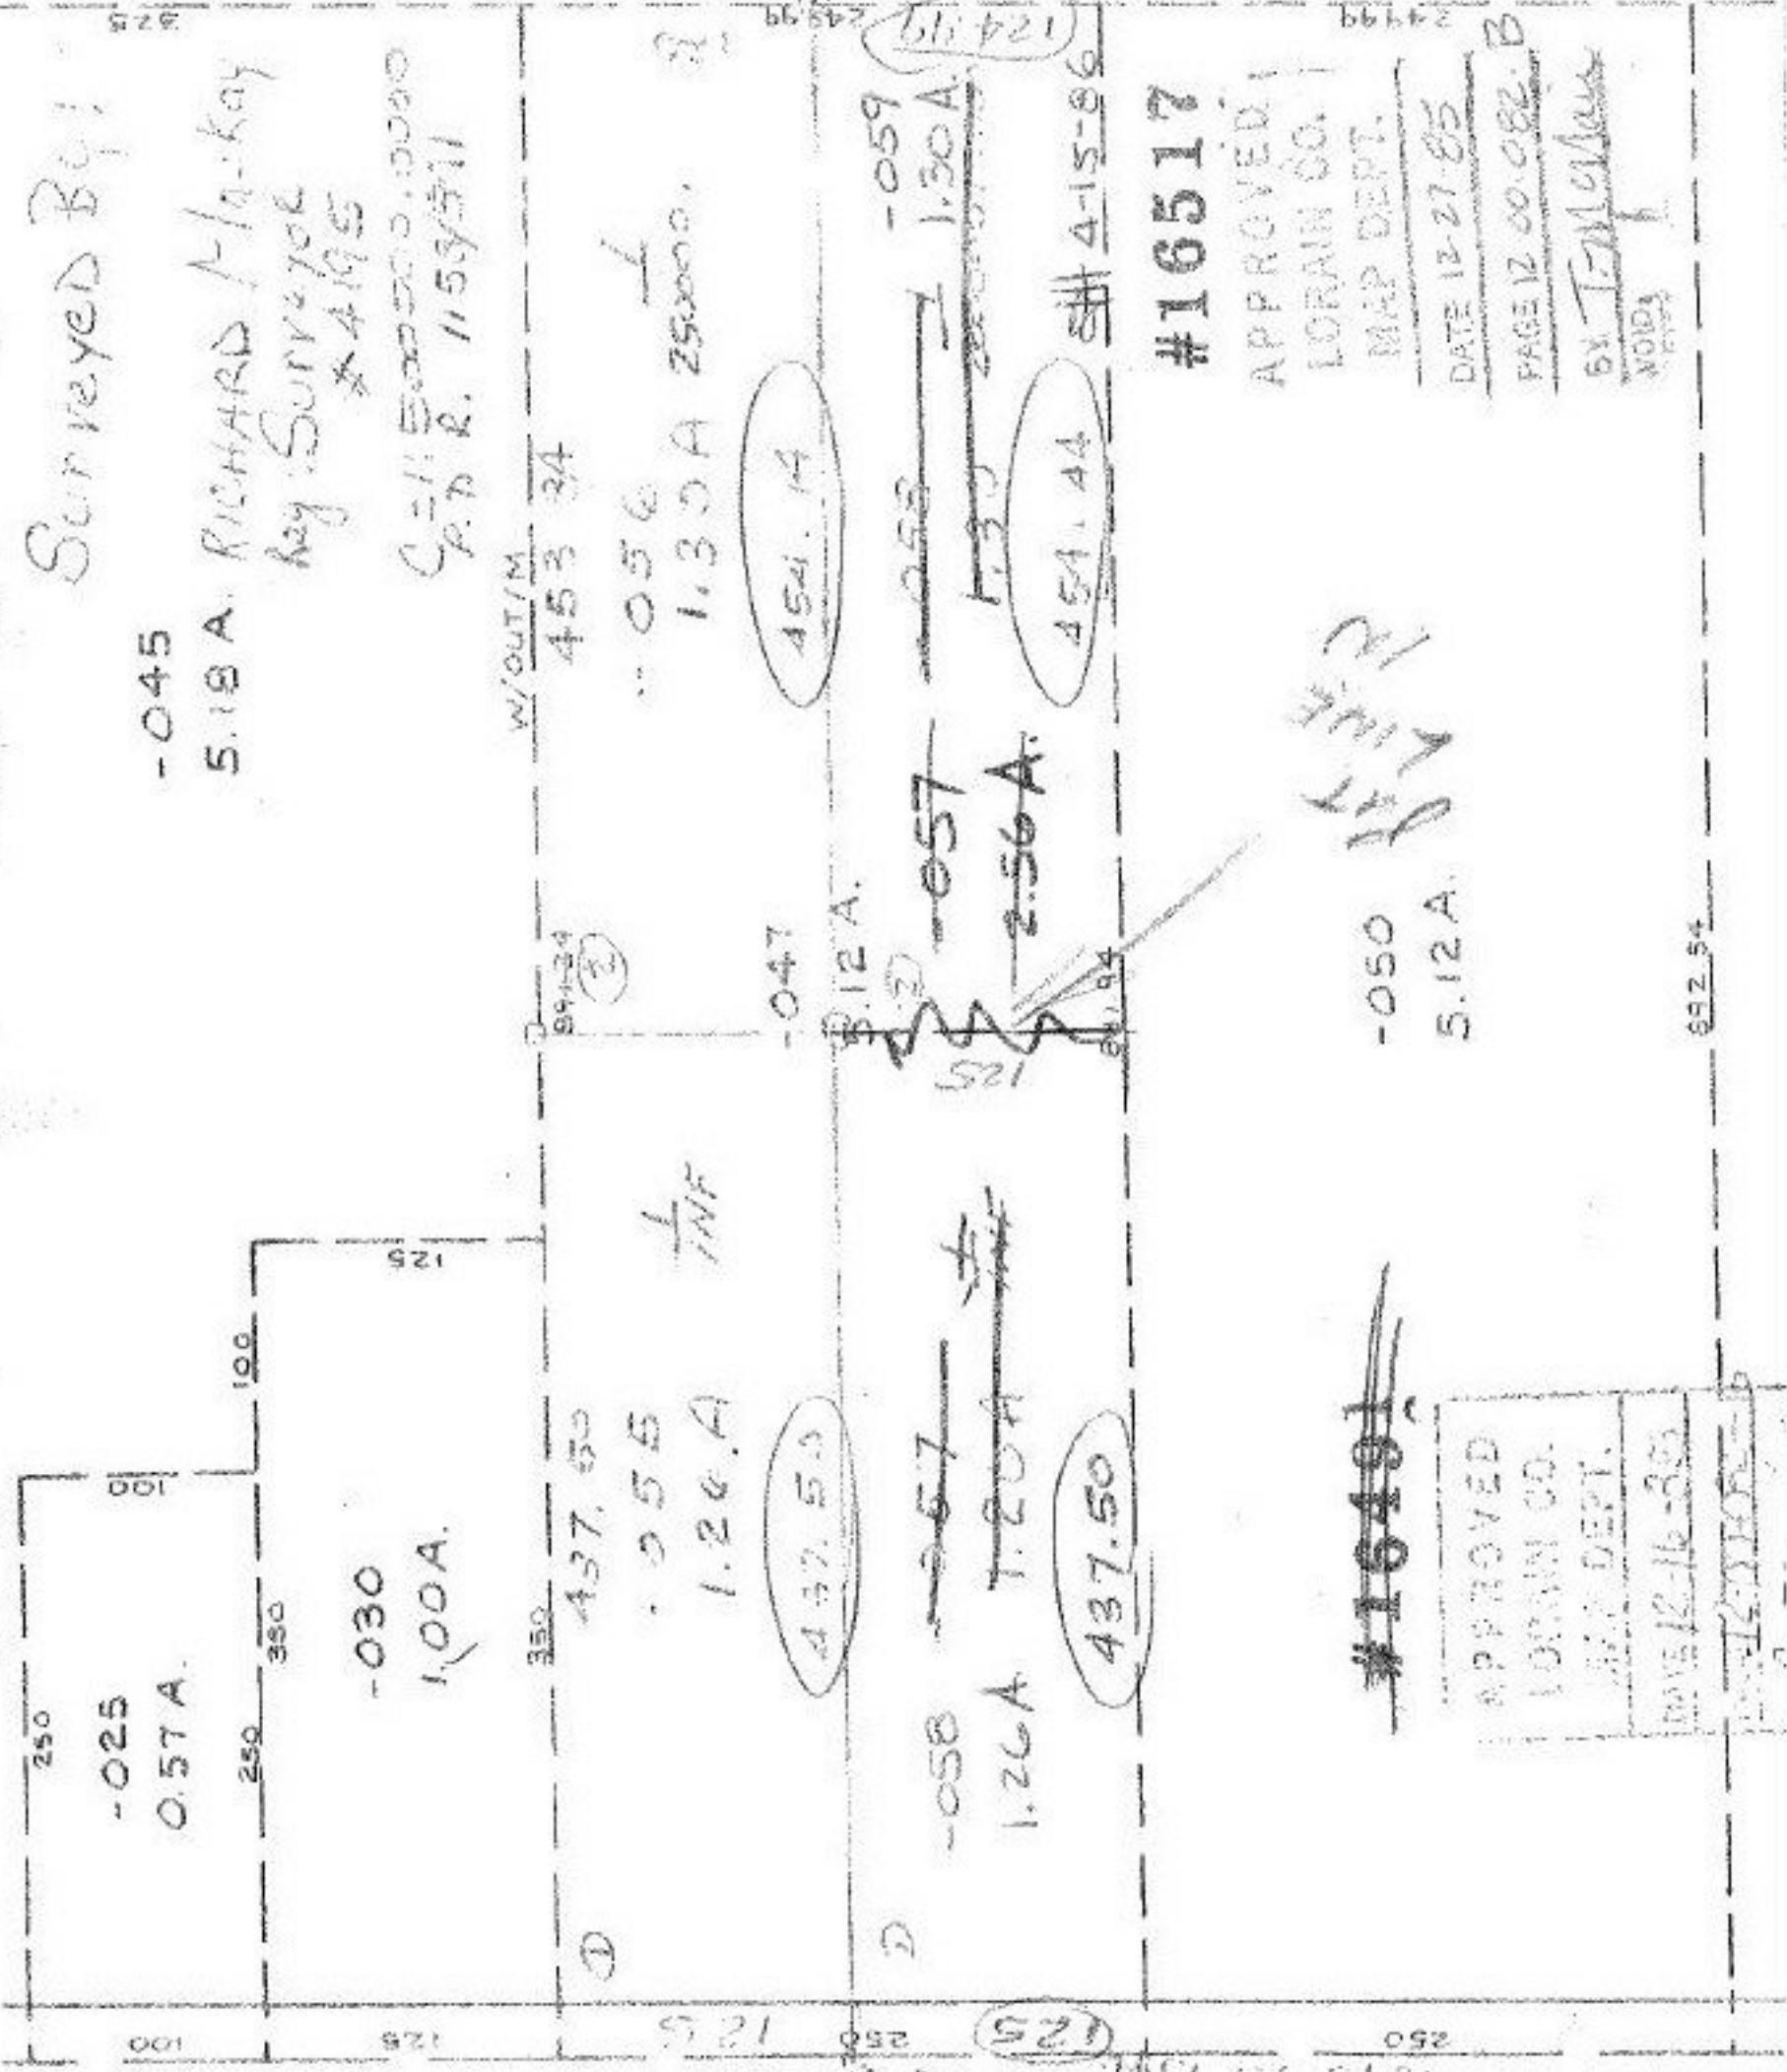

Surveyed By:
 -045
 5.18 A. RICHARD Mackay
 Key: Surveyed
 * 4195

C=1:5000
 P.D.R. 1153/3711

W/OUT/M
 453 34

0.56
 1.30 A 25000.

454.14

-047
 3.12 A.

-057
 1.30 A

-059
 1.30 A

454.44

4-15-86

#16517

APPROVED
 LORAIN CO.
 MAP DEPT.

DATE 12-27-85
 PAGE 12 00 082-B

BY: J.M. [Signature]
 VOIDA

12449

-050
 5.12 A.

#16491

APPROVED
 LORAIN CO.
 MAP DEPT.

DATE 12-16-85

692.54