

42

-003


97.50 A.

PRIOR Deed Ins.  
Vol. 1323/P. 717

SURVEYED BY  
William Barton  
Reg. Surveyor  
C=1371423, 57143

54  
-00  
4.3  
54  
353

472  
507.60  
-006  
5.50 A.  
472

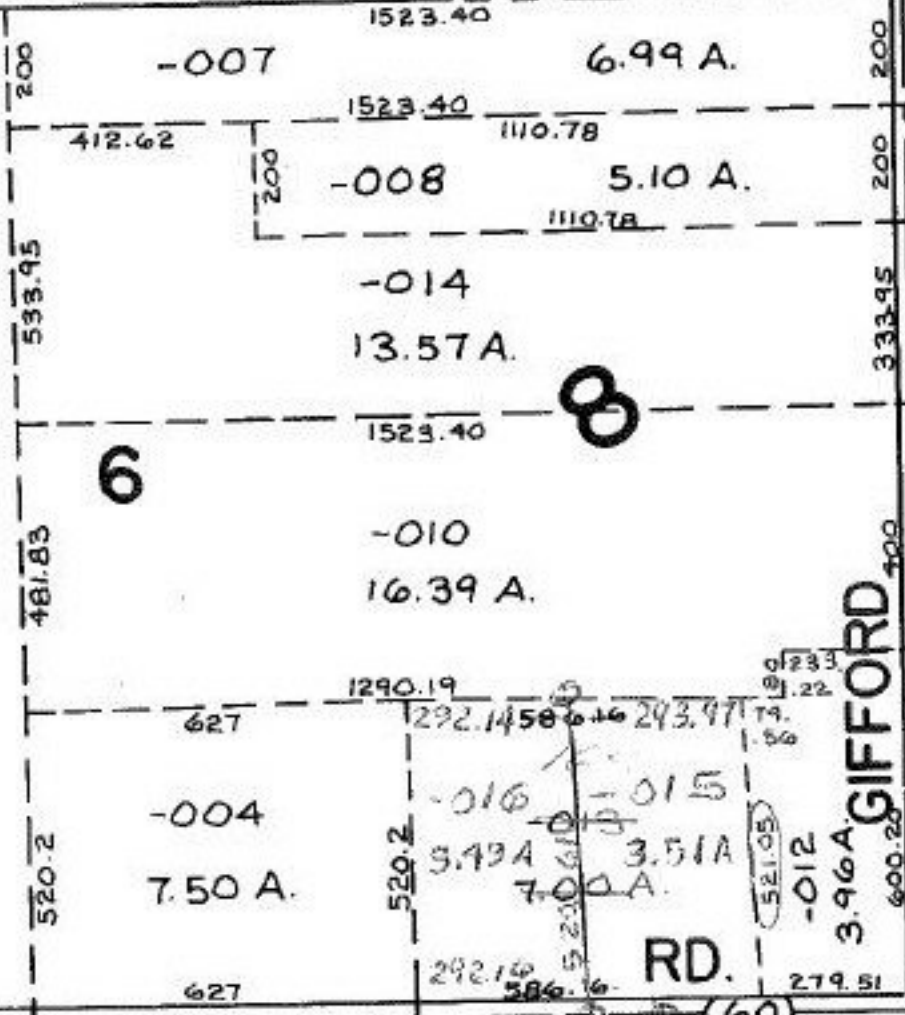

-001  
30.00 A.

T

# 16519

APPROVED  
LORAIN CO.  
MAP DEPT.

DATE 1-3-86  
PAGE 13-G  
BY C. Francis

VOID  
SEAL

# 7-22-86

294

13

02  
00 A.

15.60 A.

C

320