


373.00
53.04
319.96
233.88
96.08

231.50
151.07
80.43

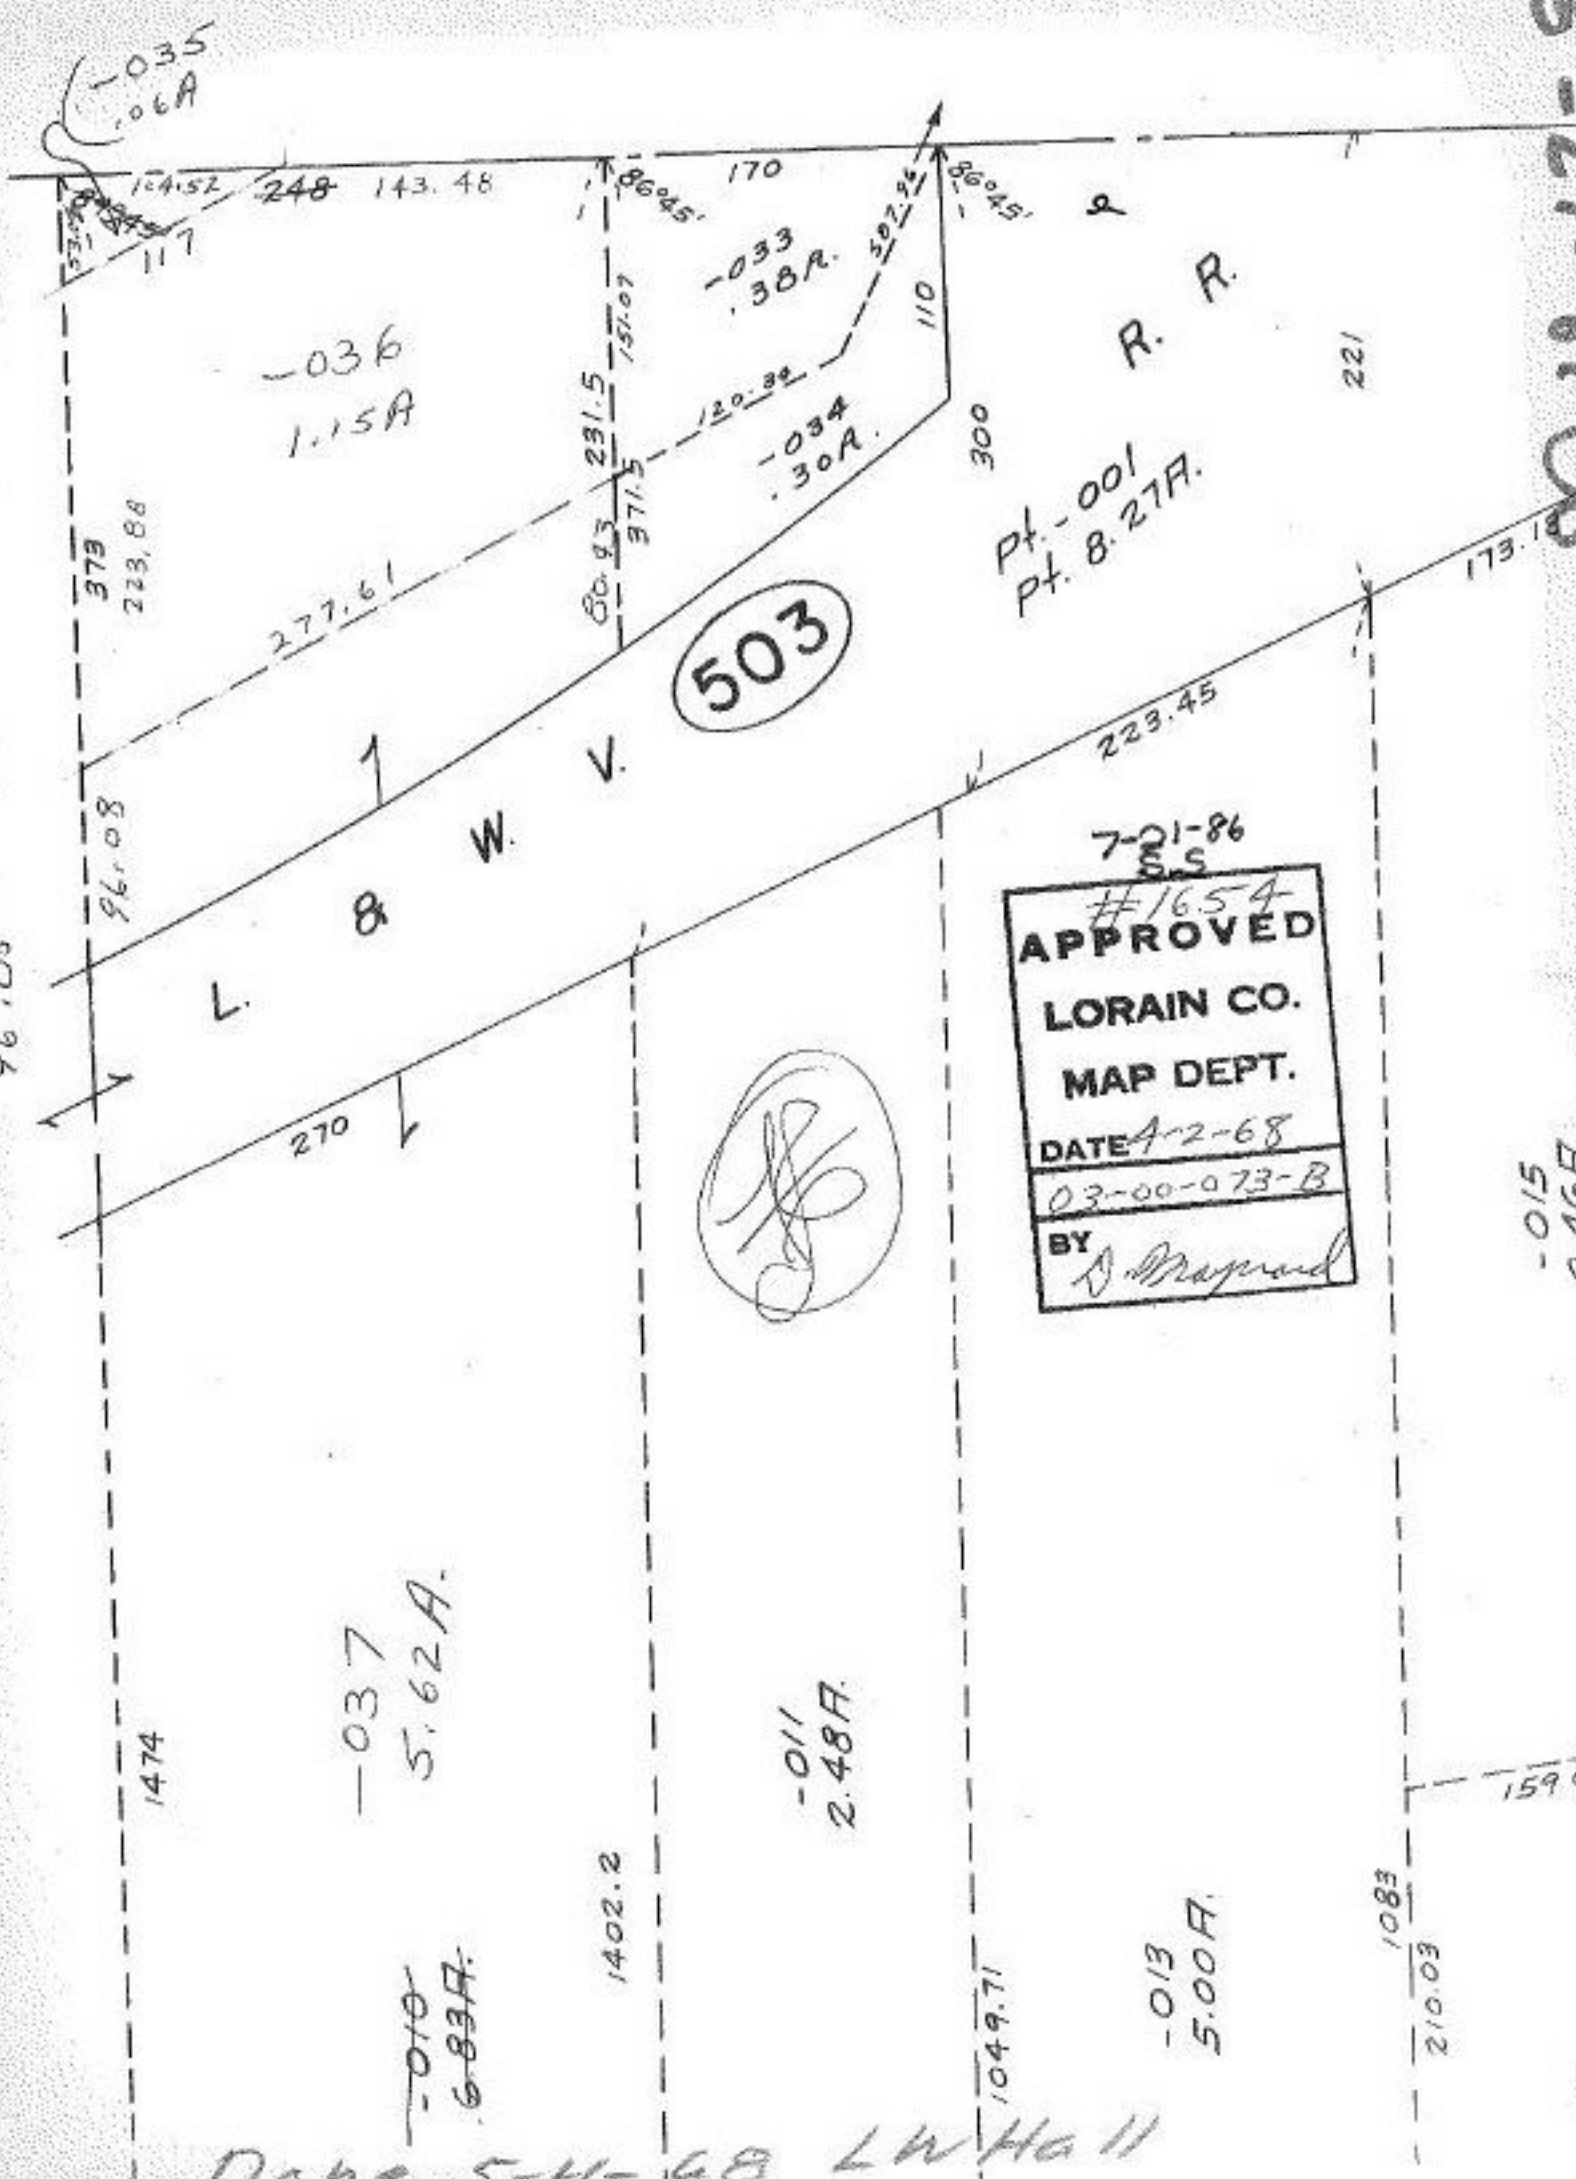

Done 5-4-68 LW Hall

2018-62-5

-015
2.46A