

VAC. ORD. 86-6  
PASSED 1-6-86

ASK ME  
JB

ALREADY A  
PART OF -007 O.IIA.

SEE 6-101


NORTH

ST.

LOBLEY ST.

West


Bl

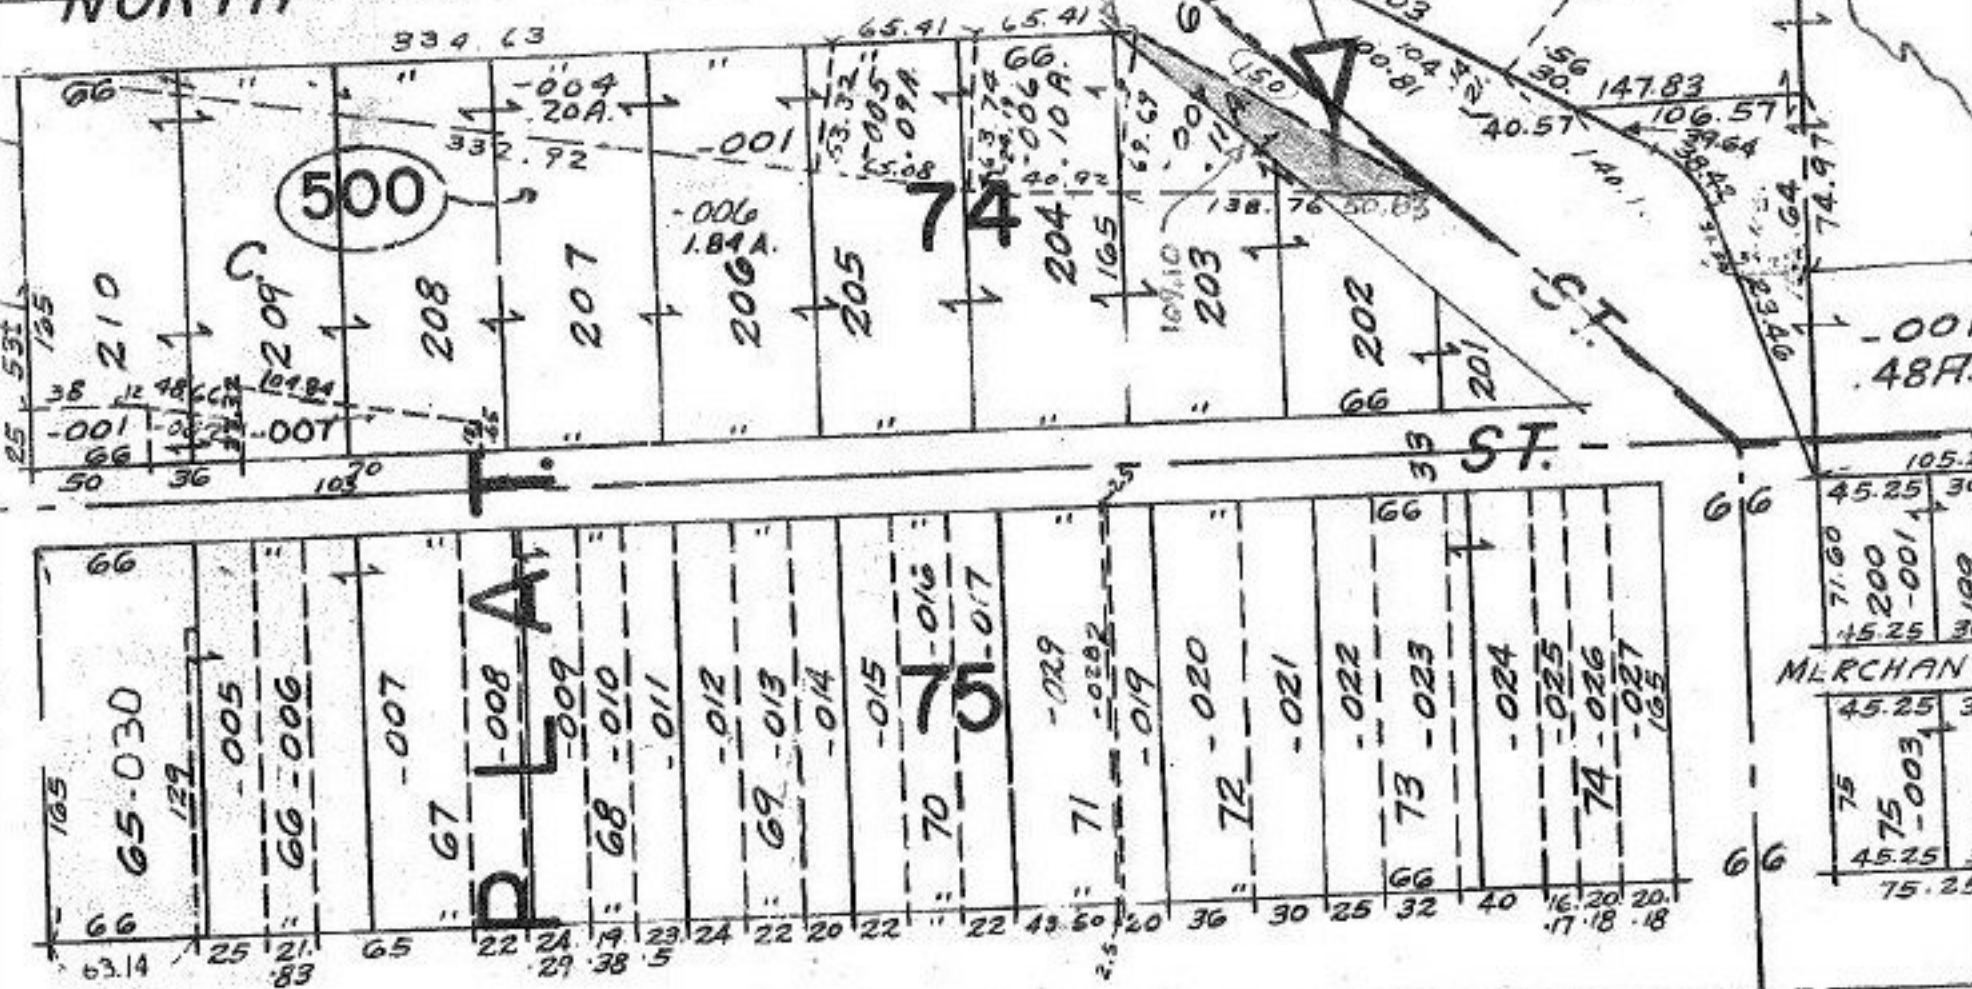

500

PLA

70-016  
71-017

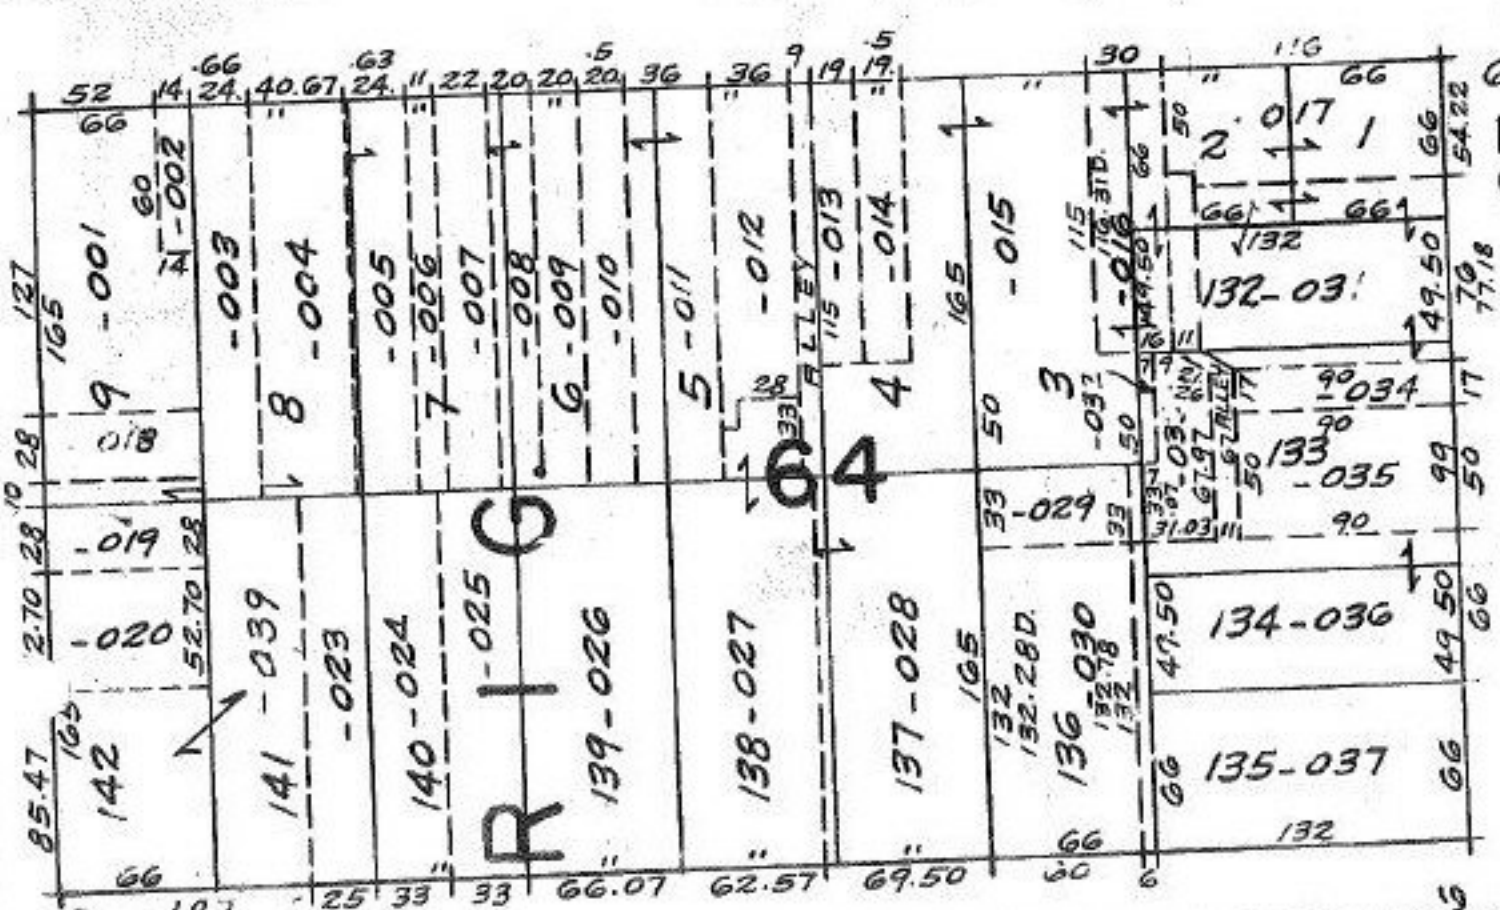

RIG

4

ST. MAP CORRECTION

St. Vacation

#1654

APPROVED  
L. RAIN  
MAP DEPT.

DATE 1-24-86

PAGE 6-119

BY T. McMain

3-27-86