


SEE 10-00-001-C

# COMBINATION

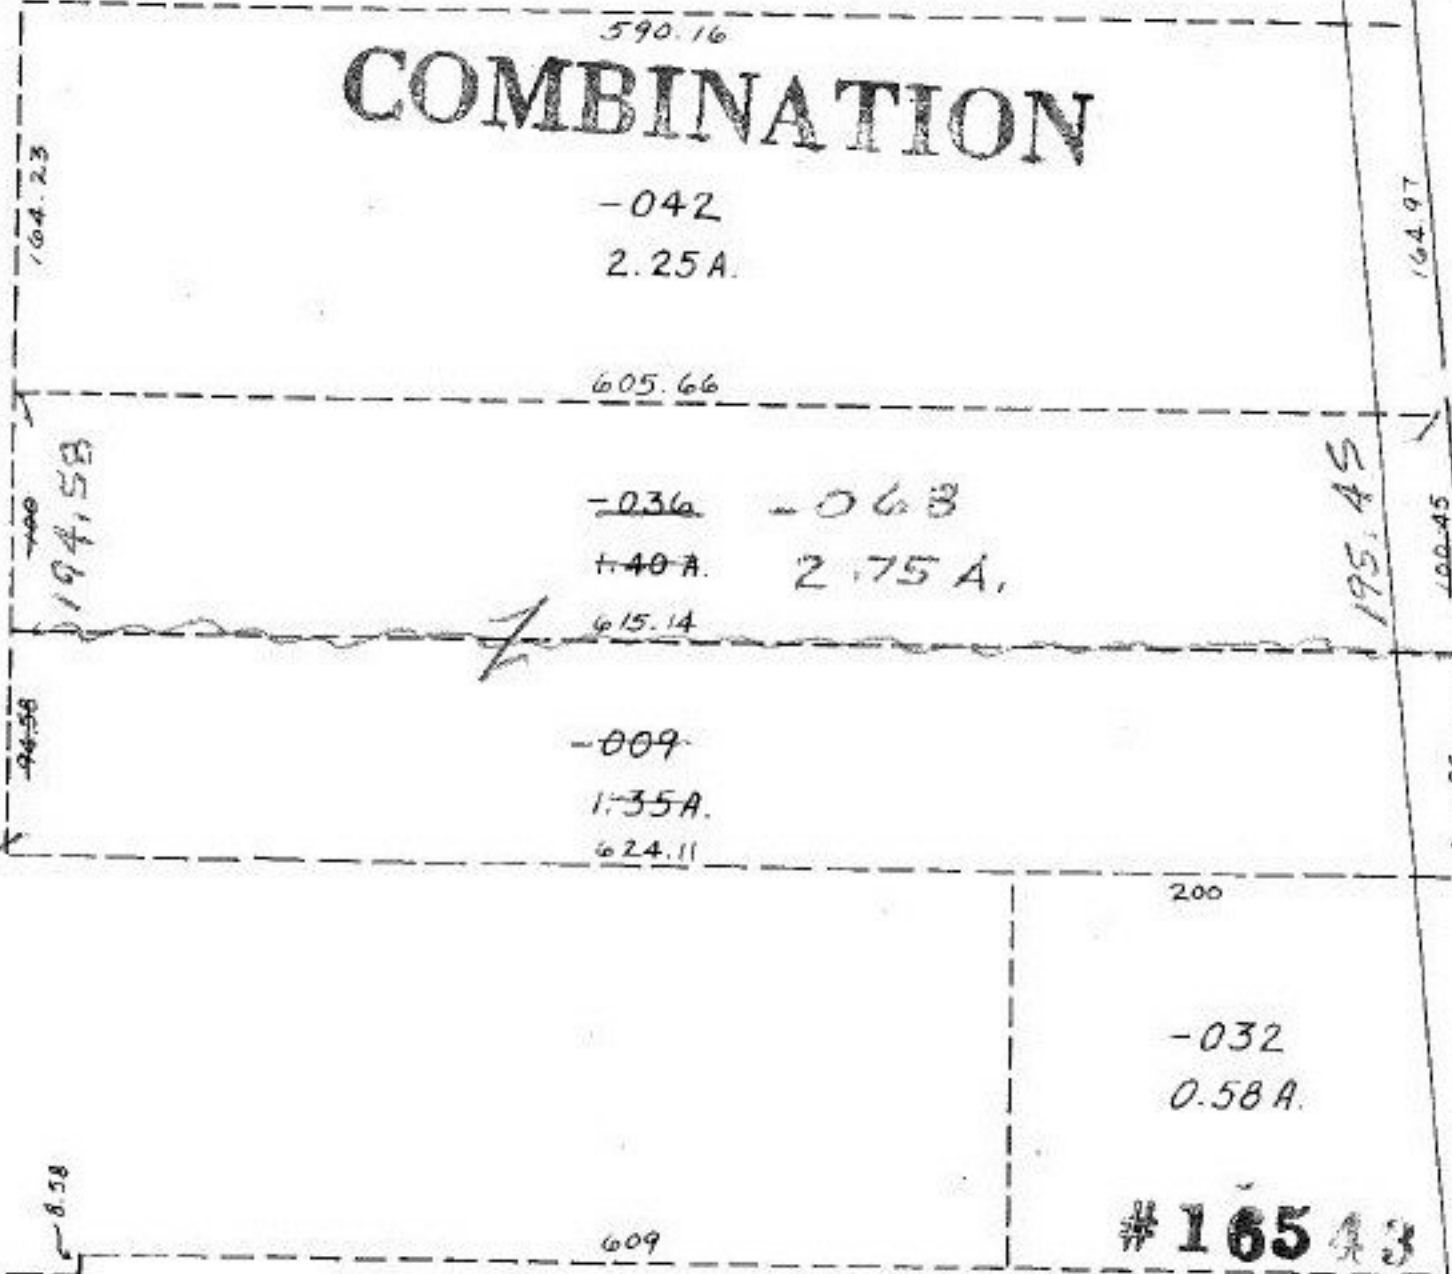

APPROVED  
 LORAIN CO.  
 MAP DEPT.  
 DATE 1-15-86  
 0.57 A.  
 PAGE 10-00-001-B  
 BY B. FRANCIS

506 4-7-86

168.02  
40.26  
1.25  
35.64 20

164.23

590.16

-042  
2.25A.

605.66

-036 -063  
1.40A. 2.75A.

615.14

-009  
1.35A.  
624.11

200

-032  
0.58A.

#16543

609

194.58

195.45

94.58

8.58

164.97

100.45

95

168.02

40.26

1.25

35.64 20