
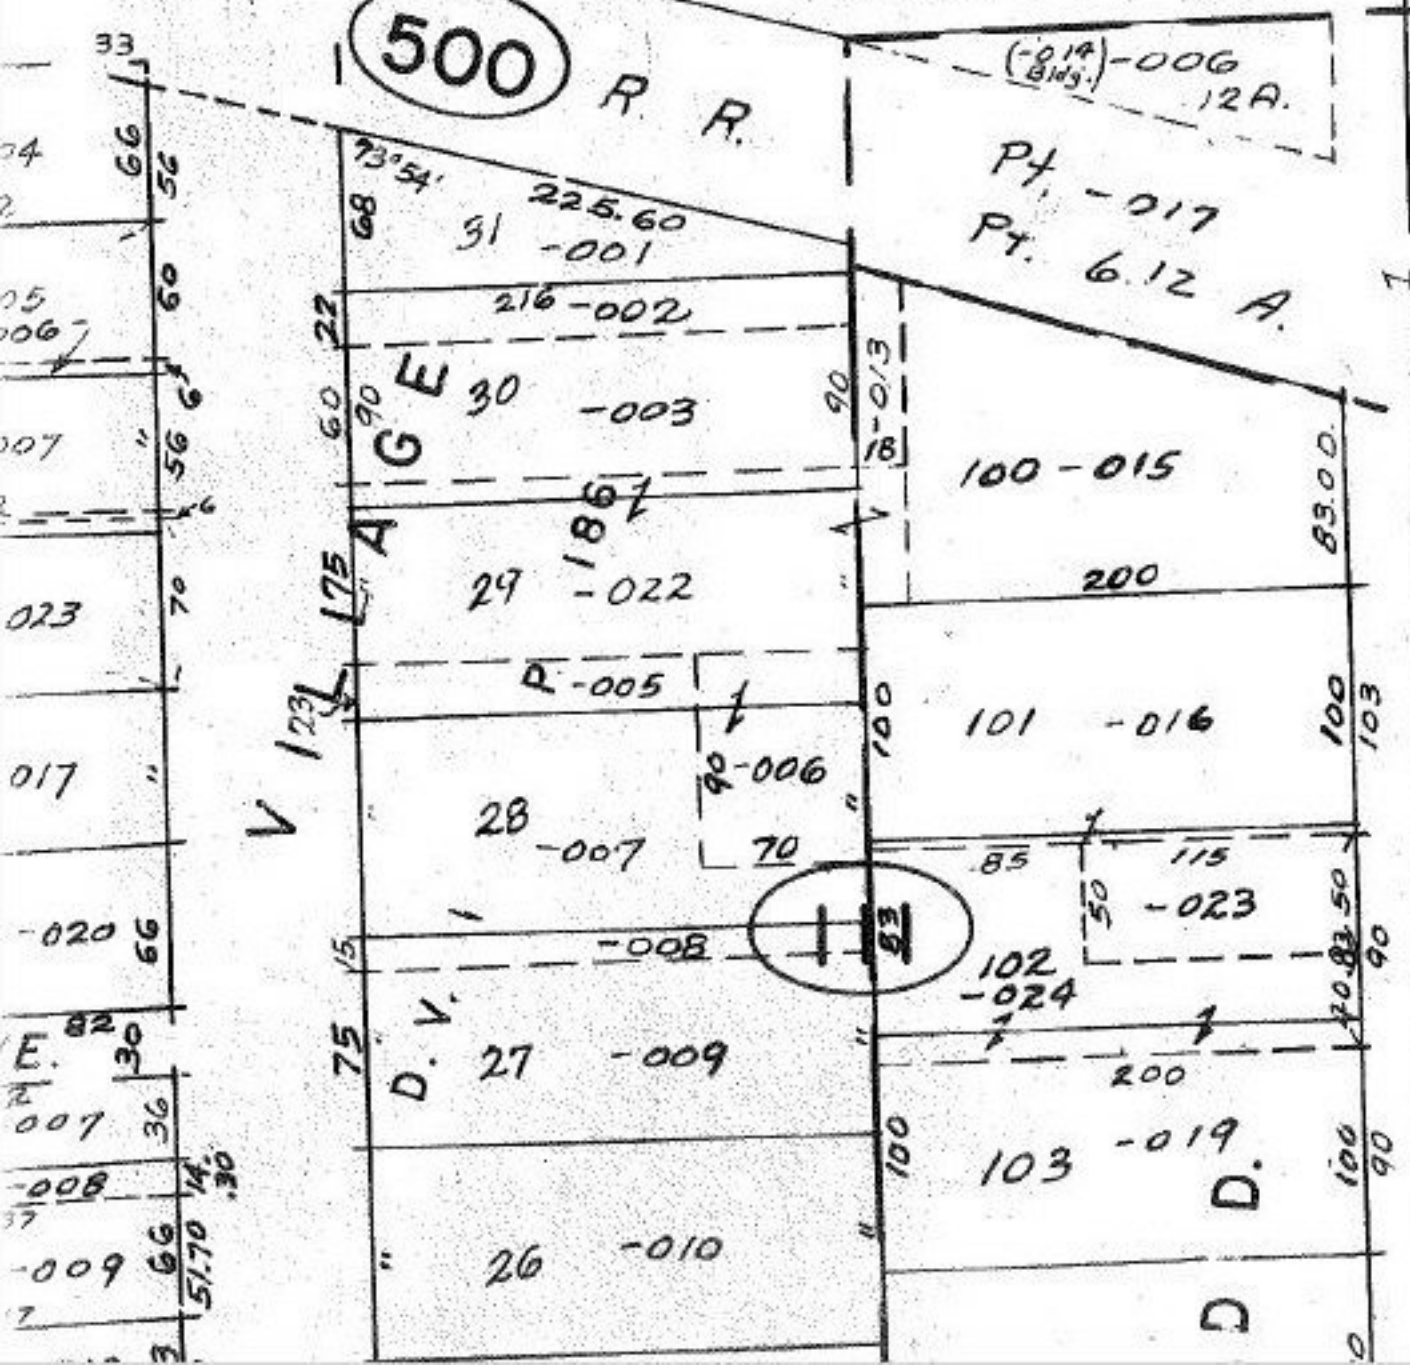


E 5-00-023-A

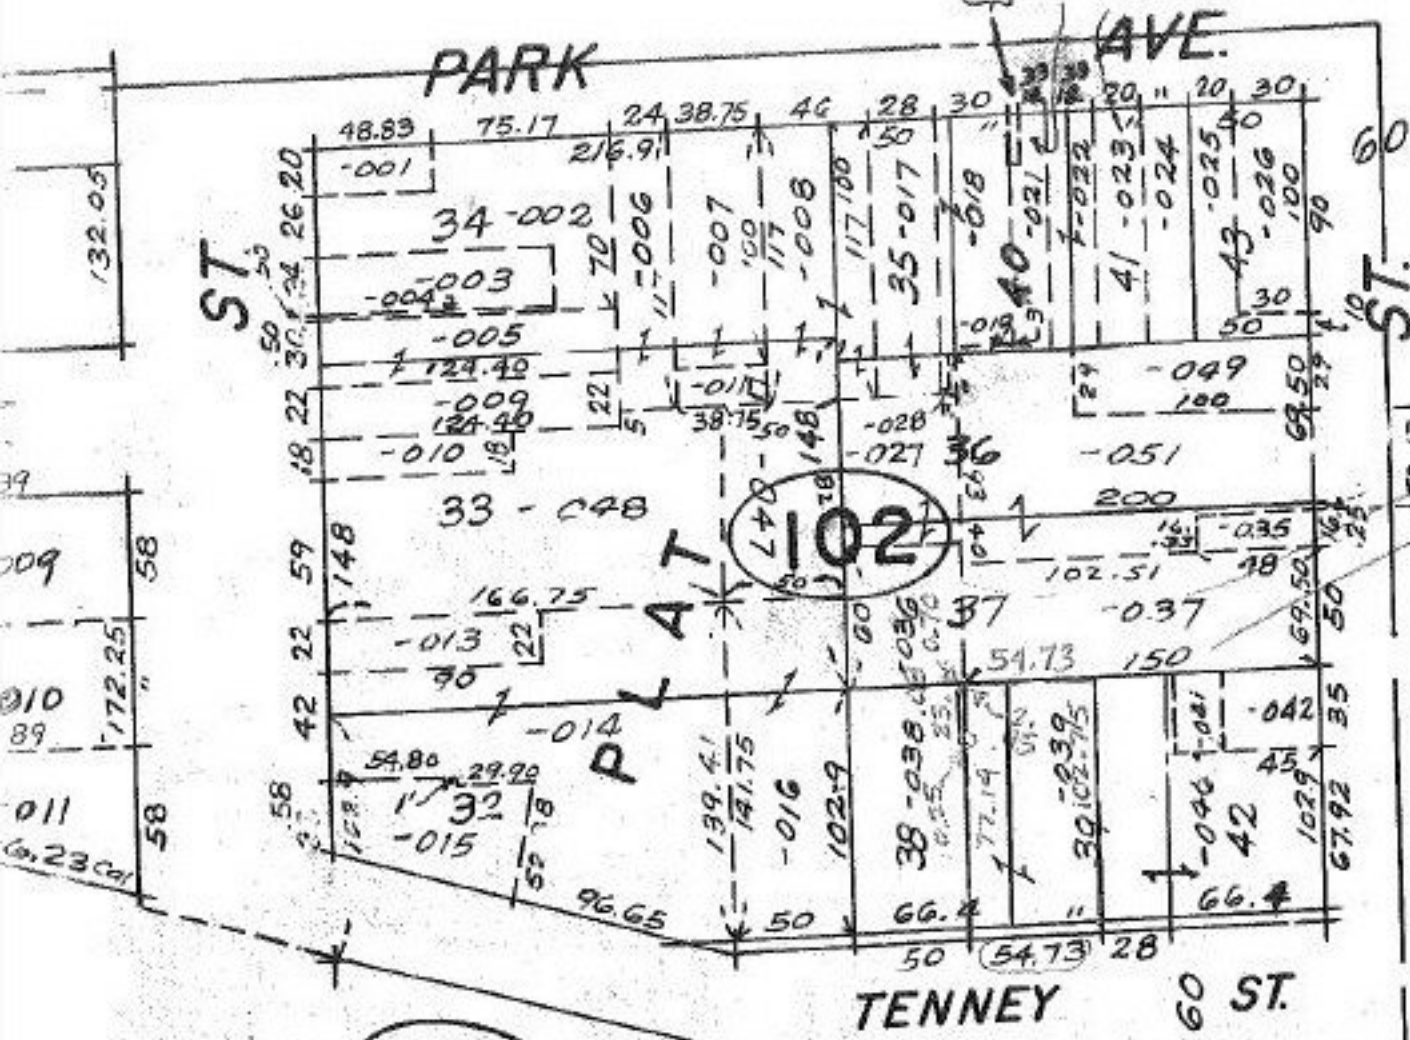

REFERENCE  
DEED  
1388/331

0.70  
2.95  
54.73  
23.08  
0.25  
77.14  
\*  
DETAIL NOT TO SCALE  
54.73

# MAP CORRECTION

#16560  
APPROVED  
LORAIN CO.  
MAP DEPT.

DATE 1-21-86  
PAGE 5-00-024 A  
BY T. McMain  
VOID  
3-31-86