


9571.16

-003
99.75A

33

-015
79.15A

972.84

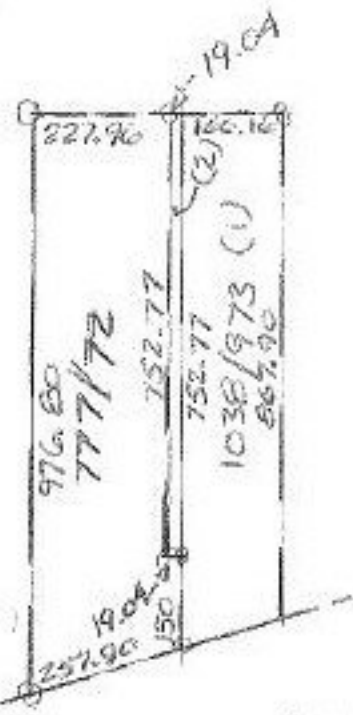

1431.54


-007
58.08A

1584.68

690.63

413.16

DETAIL - 009
TO BE USED
WHEN DENYING
PARCELS ON UNLVAR DO.
NOT INK DETAIL
ON TAX MAP.

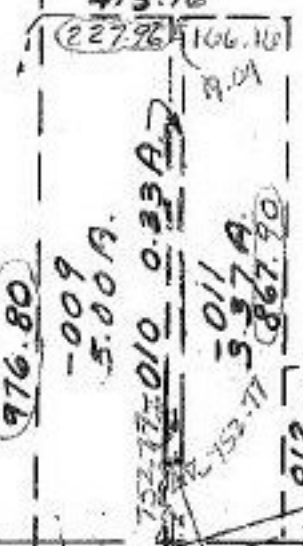

CENTER RIDGE



MAP
CORRECTION

#16562
APPROVED
EORAIN CO.
MAP DEPT.

DATE 1-22-86
PAGE 7-B
BY T. McMain
4-1-86

RIDGEVILLE TWP

SCALE 1" = 400'