


SEE 4-00-017-F-0.11A

SEE 4-00-017-F

-033

0.11A

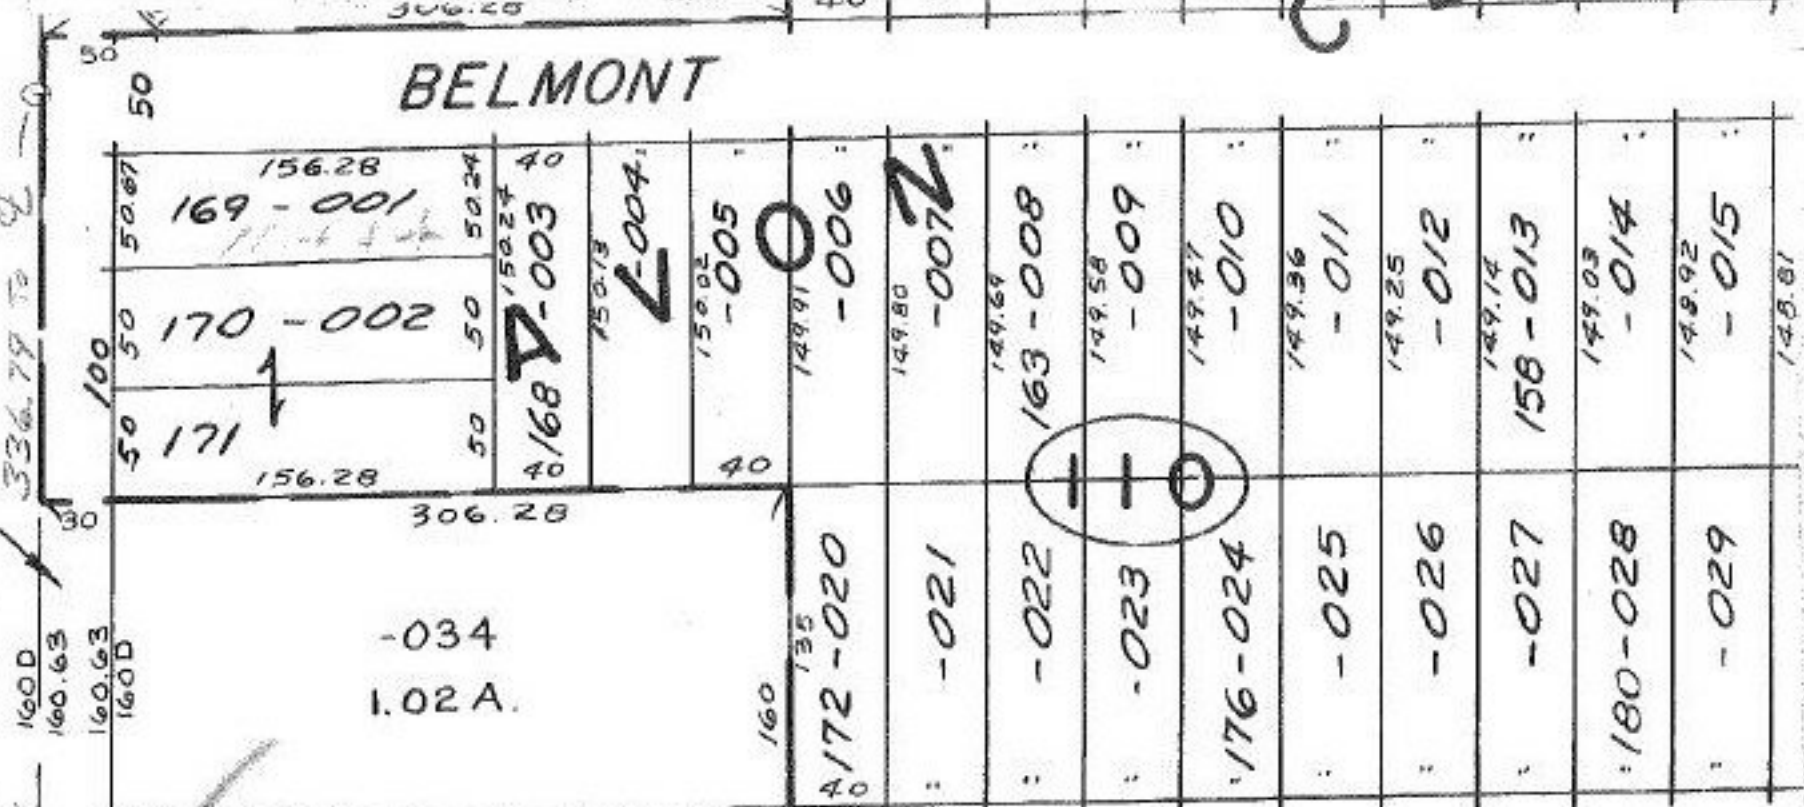

1600
160.63
160.63
160D

-034
1.02 A.

0.24 A.

329.79

332.79

335.79

0.38 A.

528.38

545.65

16

90 WD

-019 = 001
9.76 A. 10.00A

#16567

APPROVED
LORAIN CO.
MAP DEPT.

DATE 1-29-86

PAGE 4.00.017.6

BY T. McMain

VOID

113

3-27-86 -017
20.40 A.