


Pt. -027
~~Pt. 58.60A.~~
Pt. 61.03 A.

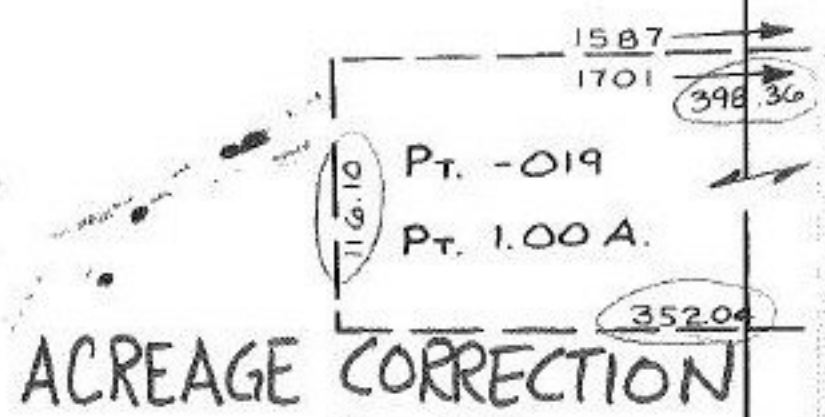

ACREAGE CORRECTION

#16574
APPROVED,
LORAIN CO.
MAP DEPT.
DATE 1-29-86
PAGE 12-00-043-A
BY T. McMain
VOID

4-15-86

* NOTE - DIMENSIONS ON THIS PAGE REGARDING THE ACREAGE CORRECTION WERE PREVIOUSLY ADDED TO MAP & DO NOT NEED TO BE SHOWN ON THIS MAP. ONLY THE CHANGE IN ACREAGE NEEDS TO BE DRAWN ON THE TAX MAP.

SEE SURVEY - KLEINOEDER · SCHMIDT · & Assoc.
CL. 1:1,000,000

