


6-1-87  
-019

#1659  
**APPROVED**  
**LORAIN CO.**  
**MAP DEPT.**  
DATE 4-15-68  
04-00-004-E  
BY *D. Maynard*

7-15-86 BMB

1079.35  
56.601

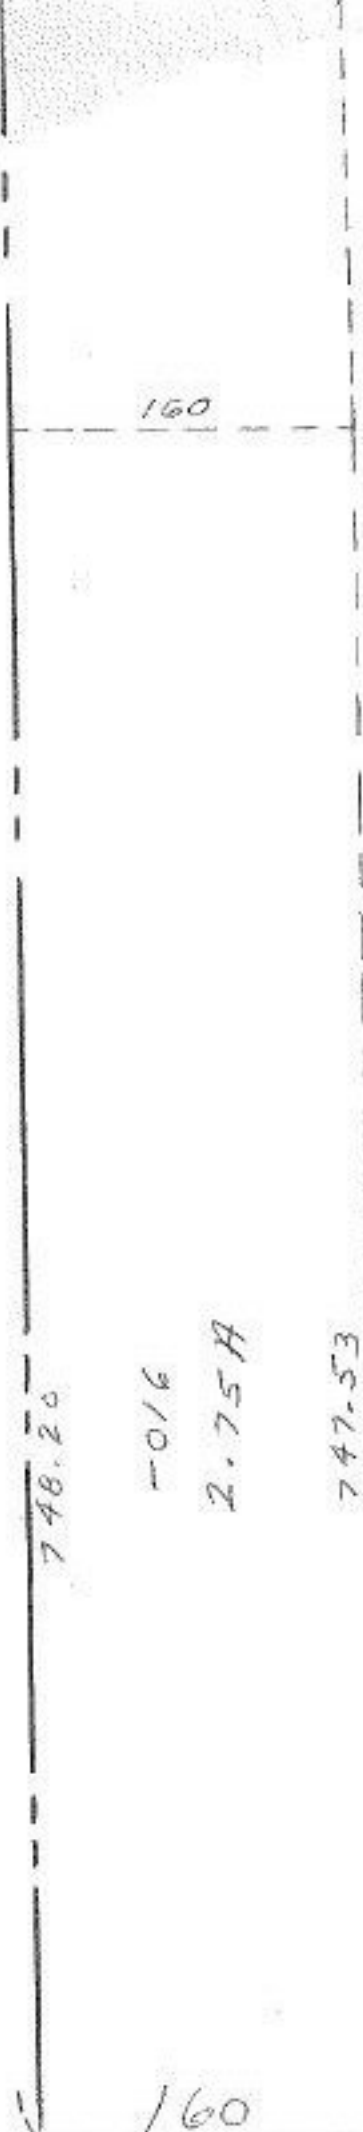

~~015~~  
~~16.29A.~~

-017  
13.54A.



748.20

-016

2.75A

747.53

160

221.92

251.36

**DONE 5-4-68**  
**FRANK COLBERT.**