


SEE 9-00-087-A

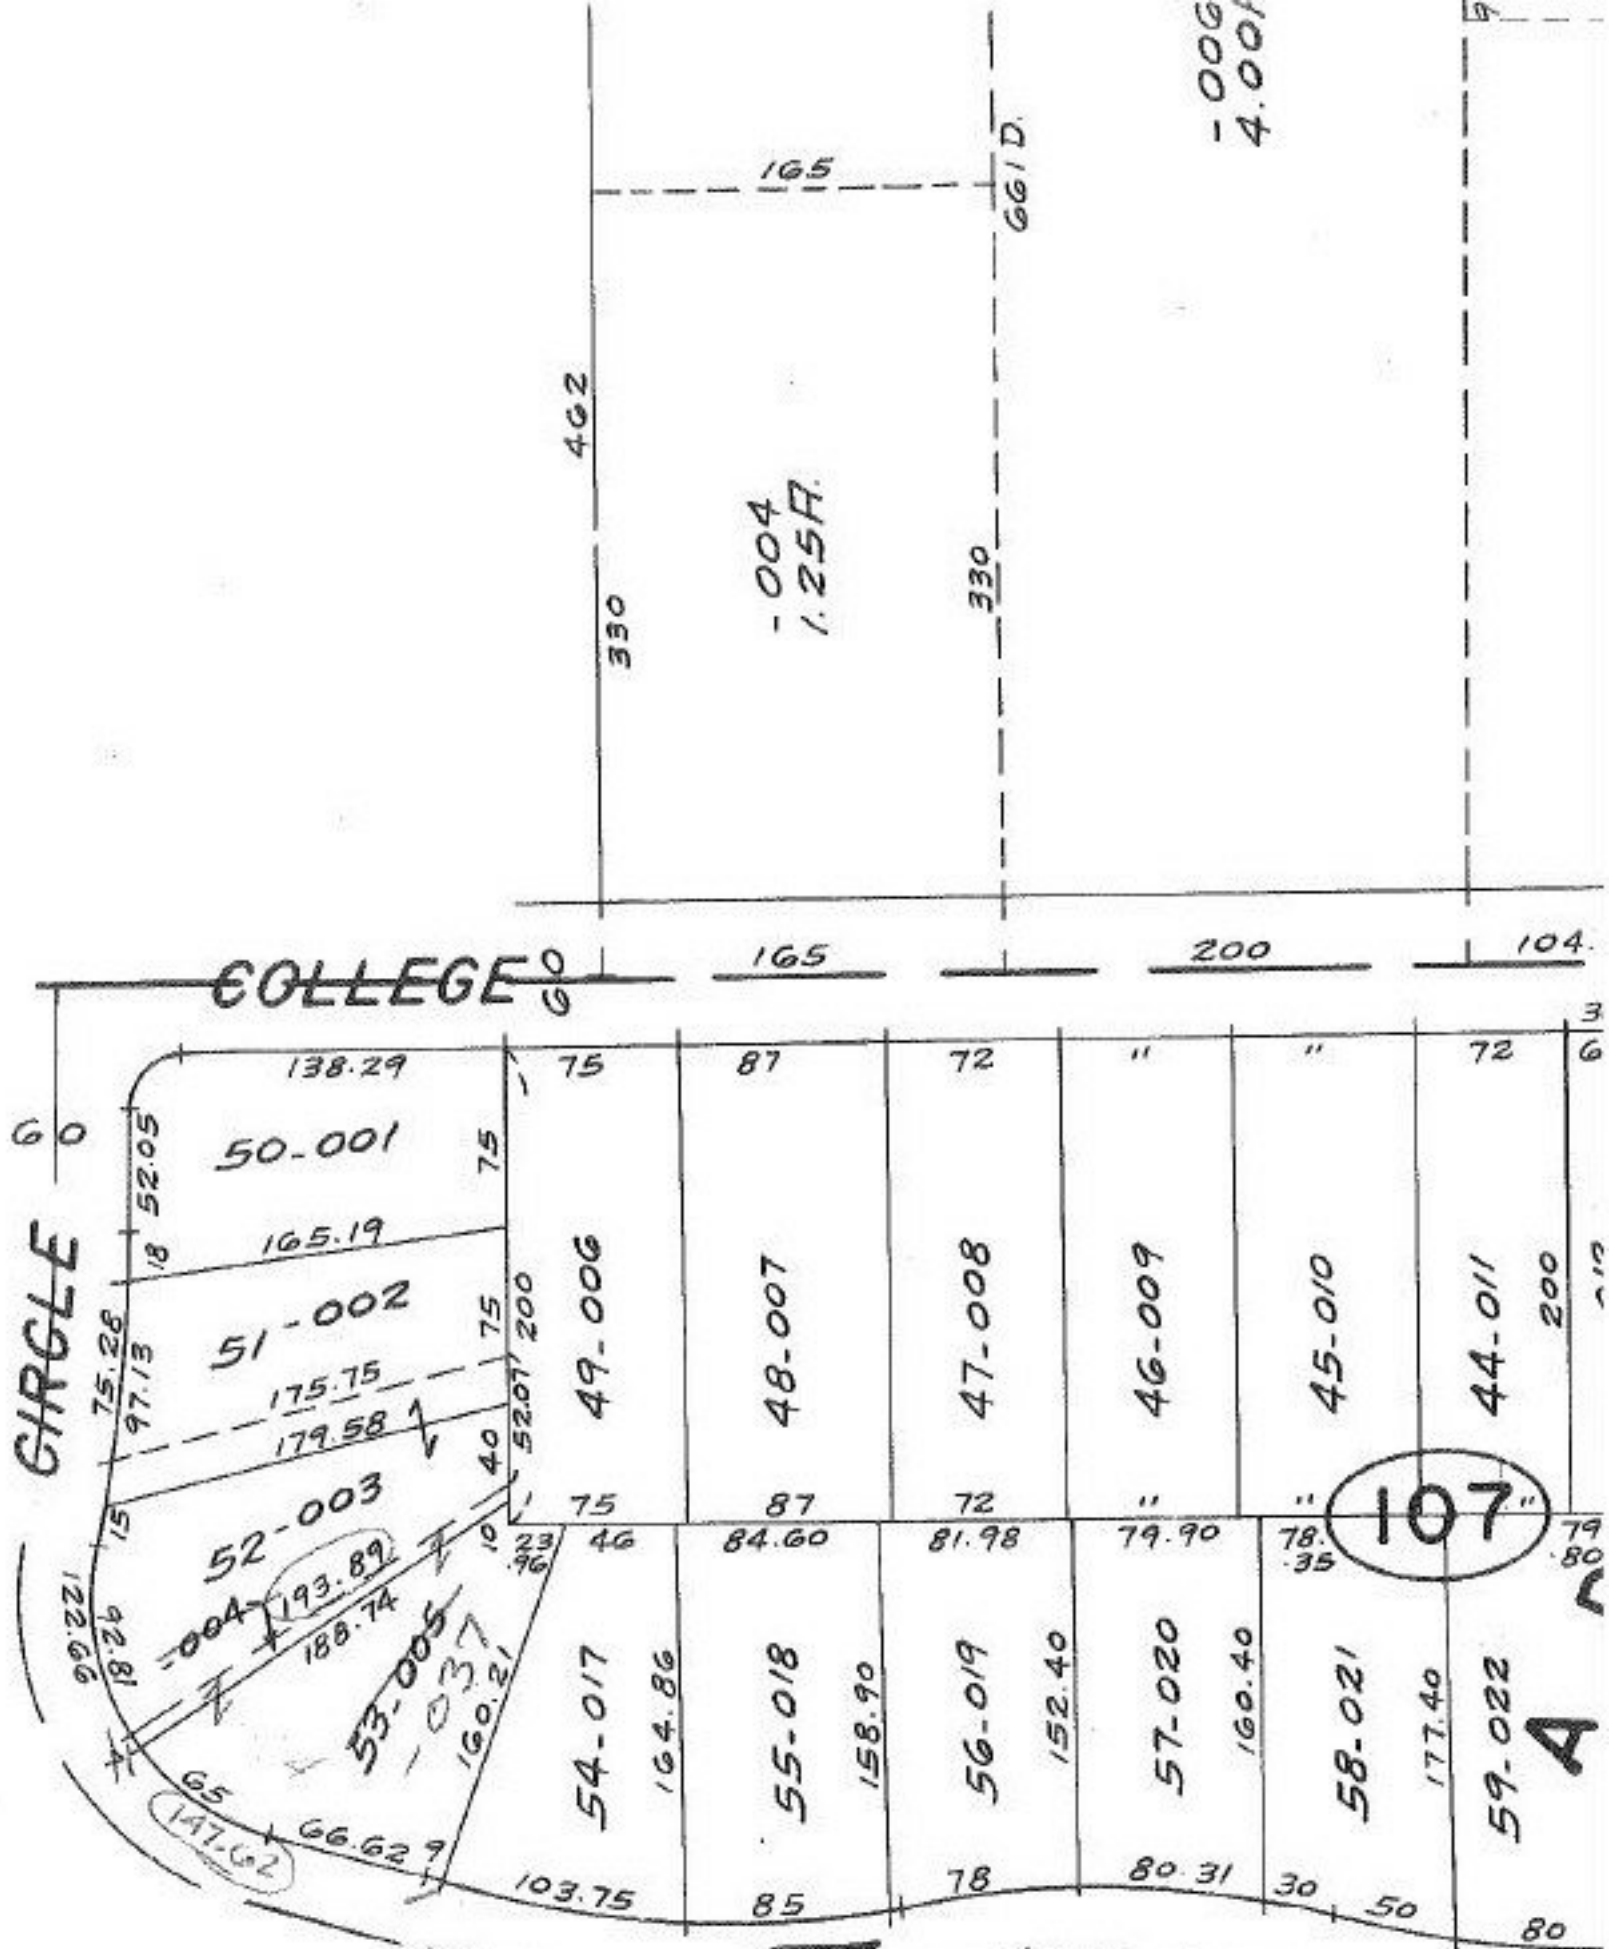

COMBINATION

#16594

APPROVED
LORAIN CO.
MAP DEPT.
DATE 2-18-86
PAGE 9-00-087-B
BY T. McNamee
VOID AFTER

ARK

4-8-86

CA