


(LIBERTY AVE.)

SEE DETAIL

RD. RL

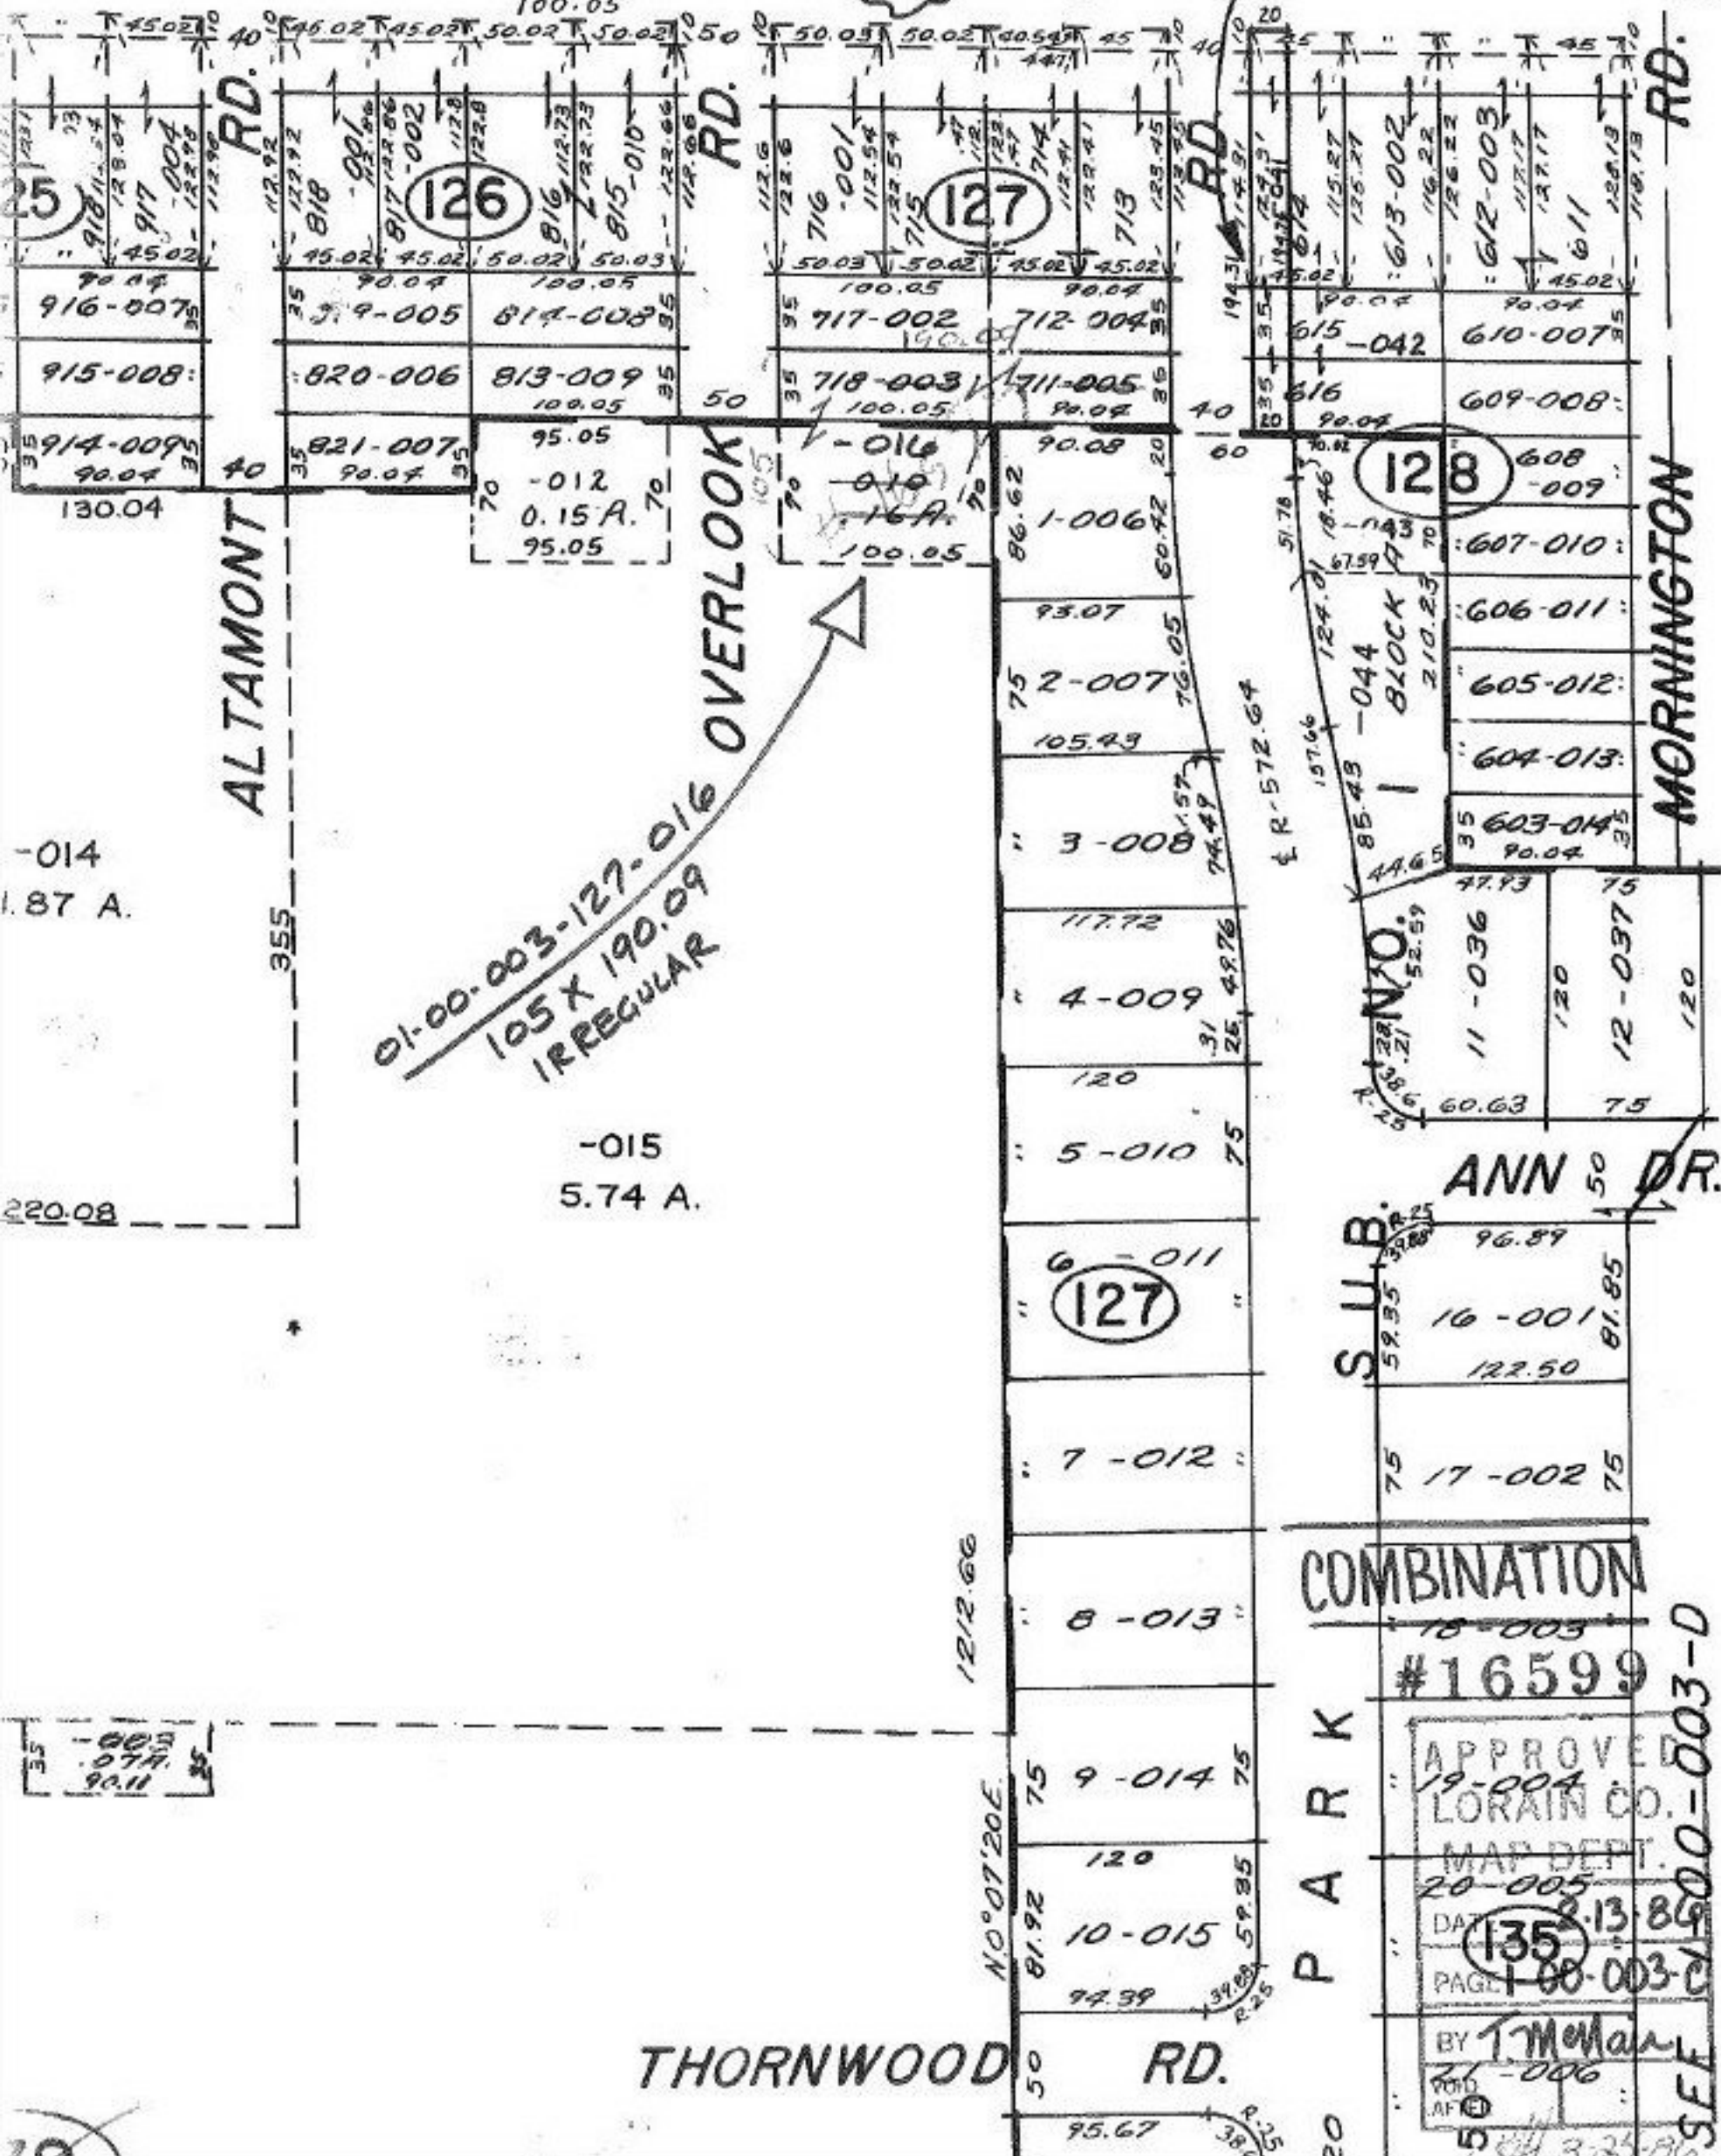

ALTAMONT RD.

MORNINGTON RD.

OVERLOOK

01-00-003-127-016  
 105 X 190.09  
 IRREGULAR

-015  
 5.74 A.

COMBINATION

#16599

APPROVED  
 19-004  
 LORAIN CO.  
 MAP DEPT.

20-005  
 DATE 3-13-86  
 PAGE 1-00-003-C

BY T. McMan  
 21-006  
 3-25-86

THORNWOOD RD.

PARK

SEE