

473.22
474.60

RD. 9

RD. 60

667.93 TO CL


Pt-097
Pt. 4.00A

276.16

143.04

SEE SURVEY
LAUNDON SIMON, CIVIL
E.L. 12 INF.

-190
34.32 A.

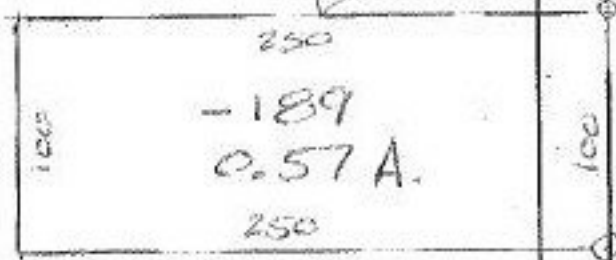

~~129~~
~~34.89 A.~~

#16601

APPROVED LORAIN CO. MAP DEPT.	
DATE 2.21.86	
PAGE 10.00.013 IF	
BY T. McNeil	
VOID AFTER	

4-3-86