
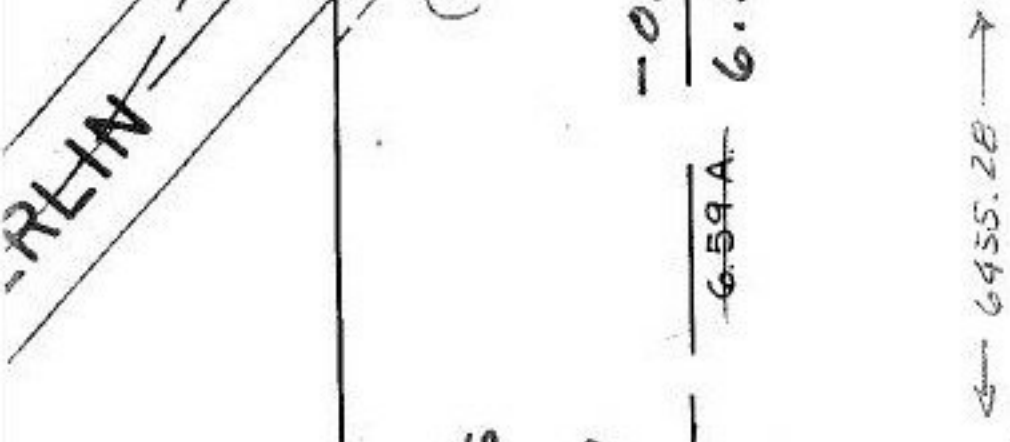



PT. -086
PT. 51.29 A.

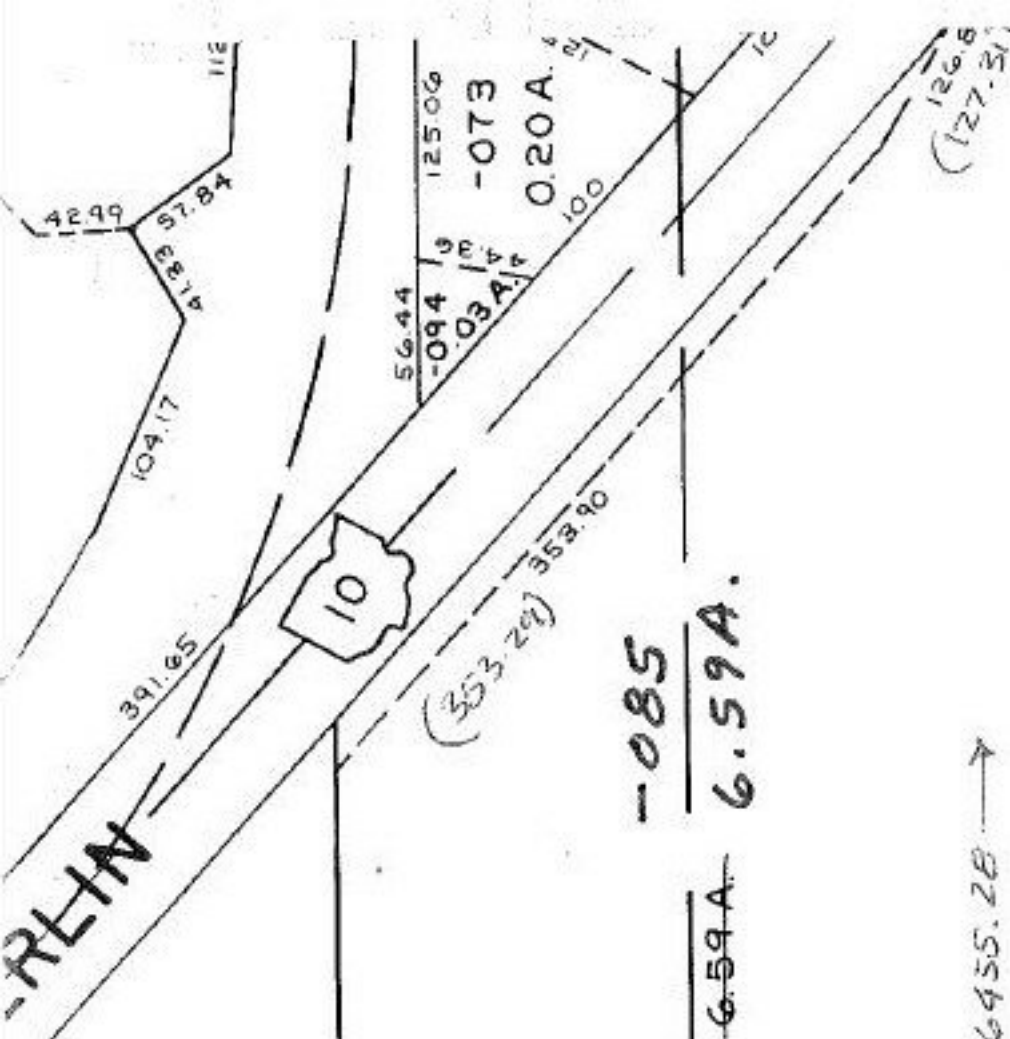

D U C # 10014
12-1-86

APPROVED
LORAIN CO.
MAP DEPT.
DATE 11-17-86
PAGE 10 of 13
BY [Signature]
VOID AFTER 1/8/614

POND

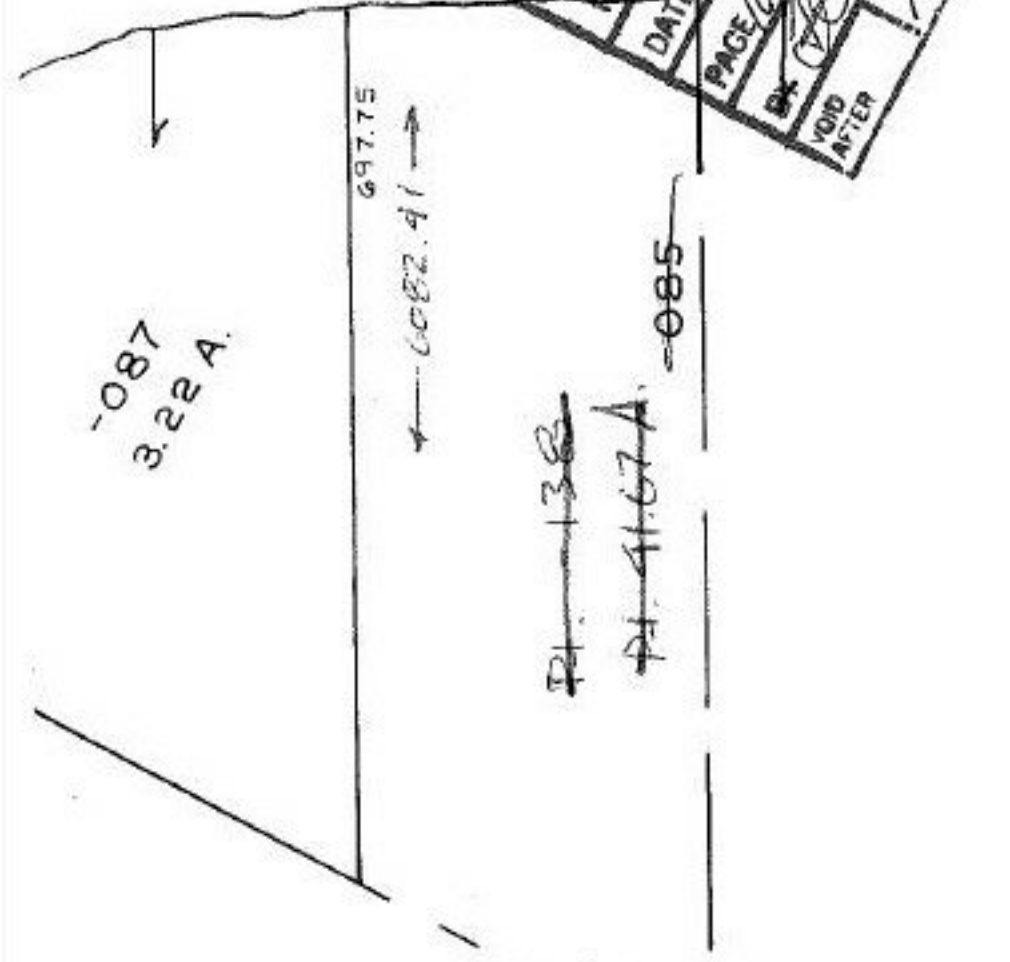

-087
3.22 A.