


A HERVANE

ESTATES  
VOL.

30 PG. 6

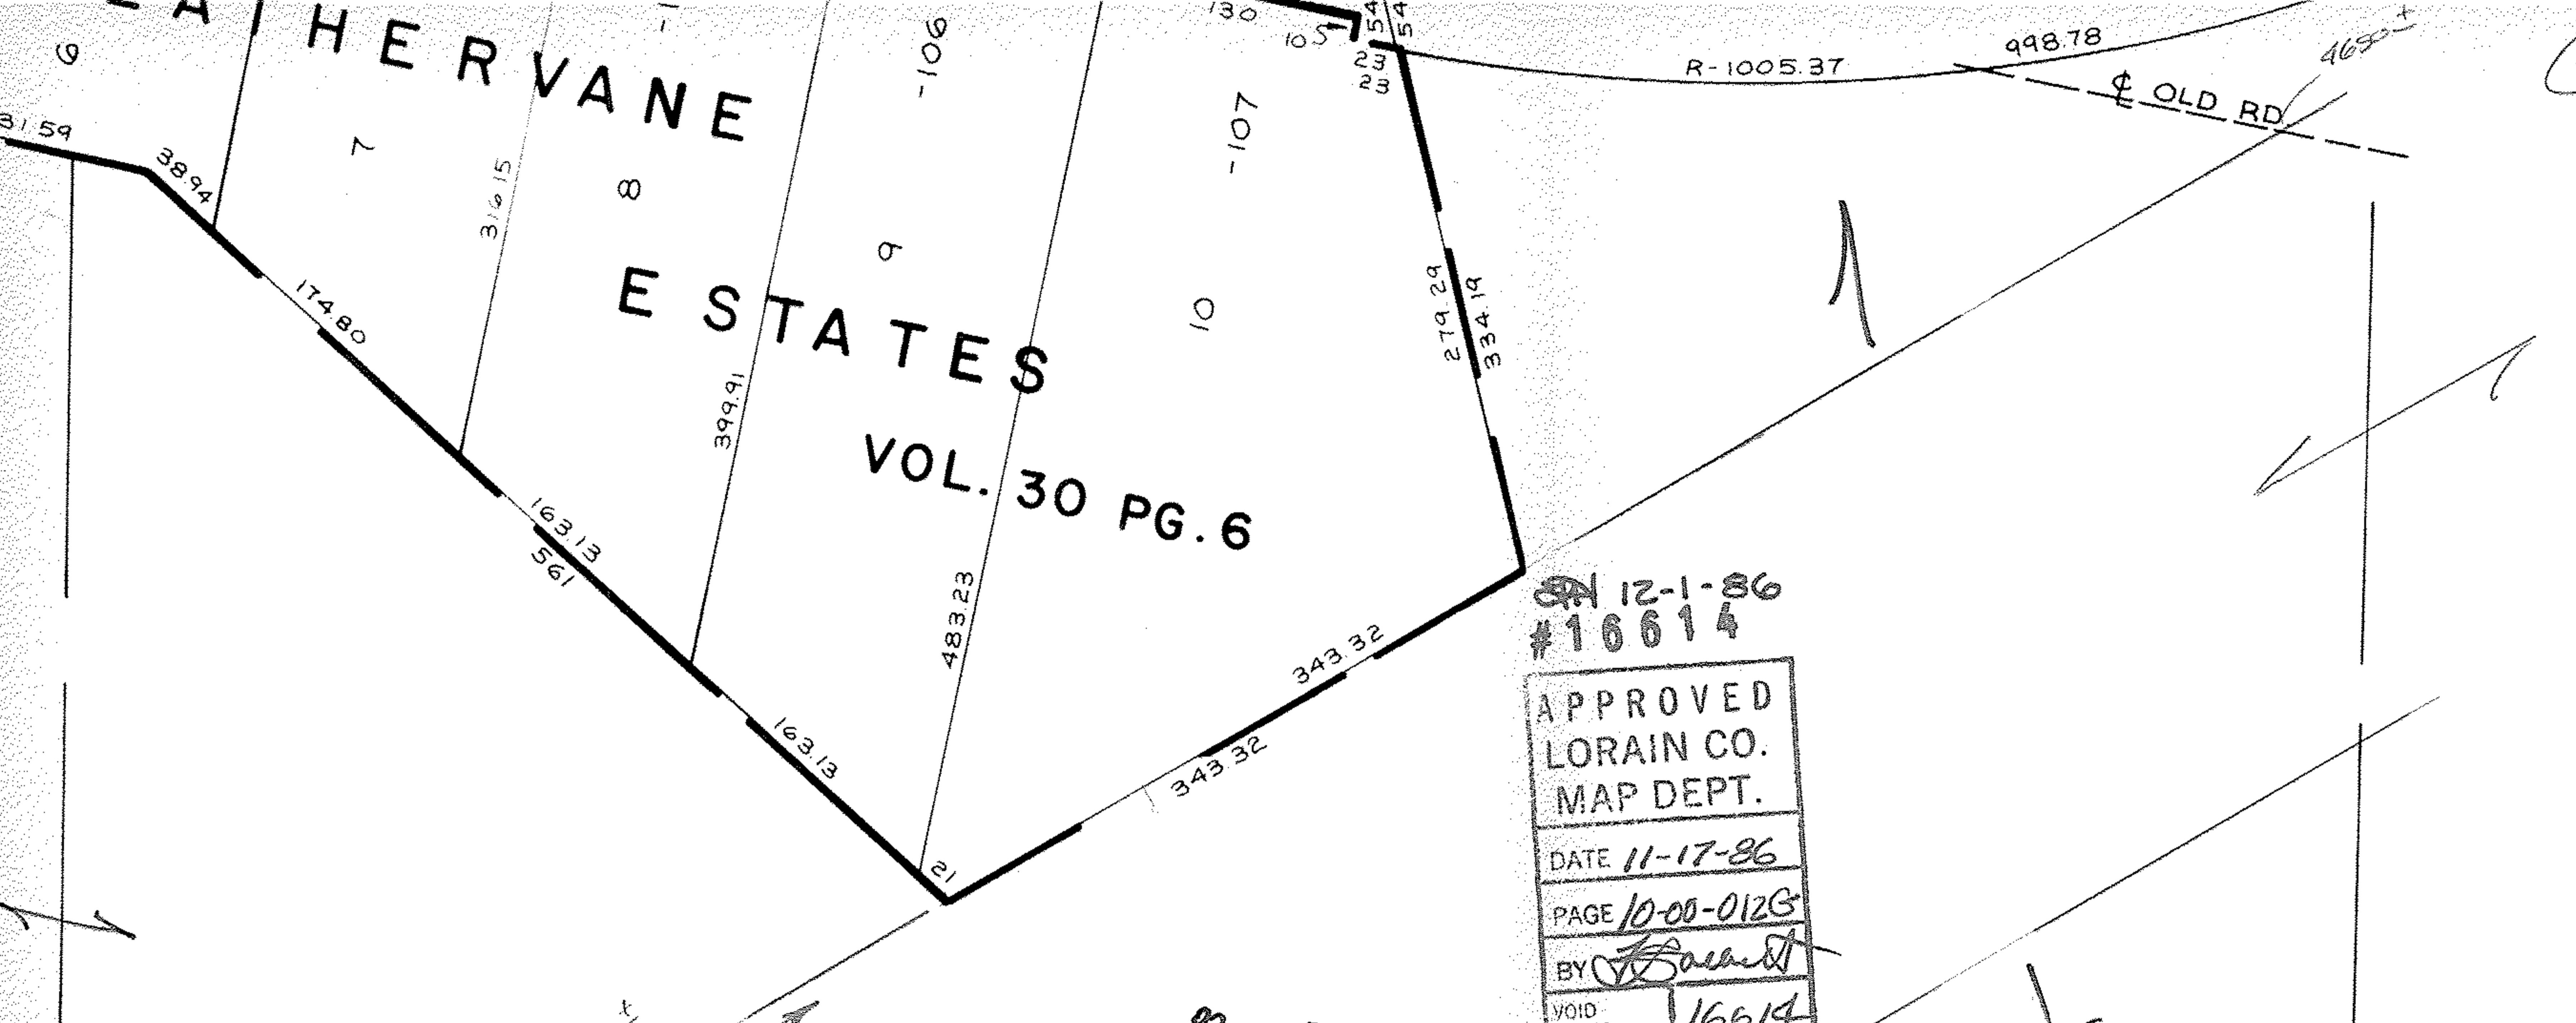

PT - 138  
A1.61R.  
PT

#16614

PT - 074  
PT 115.42 A.

PT - 139  
PT 215.95 A.  
209.36 A

H