


SEE 12-A

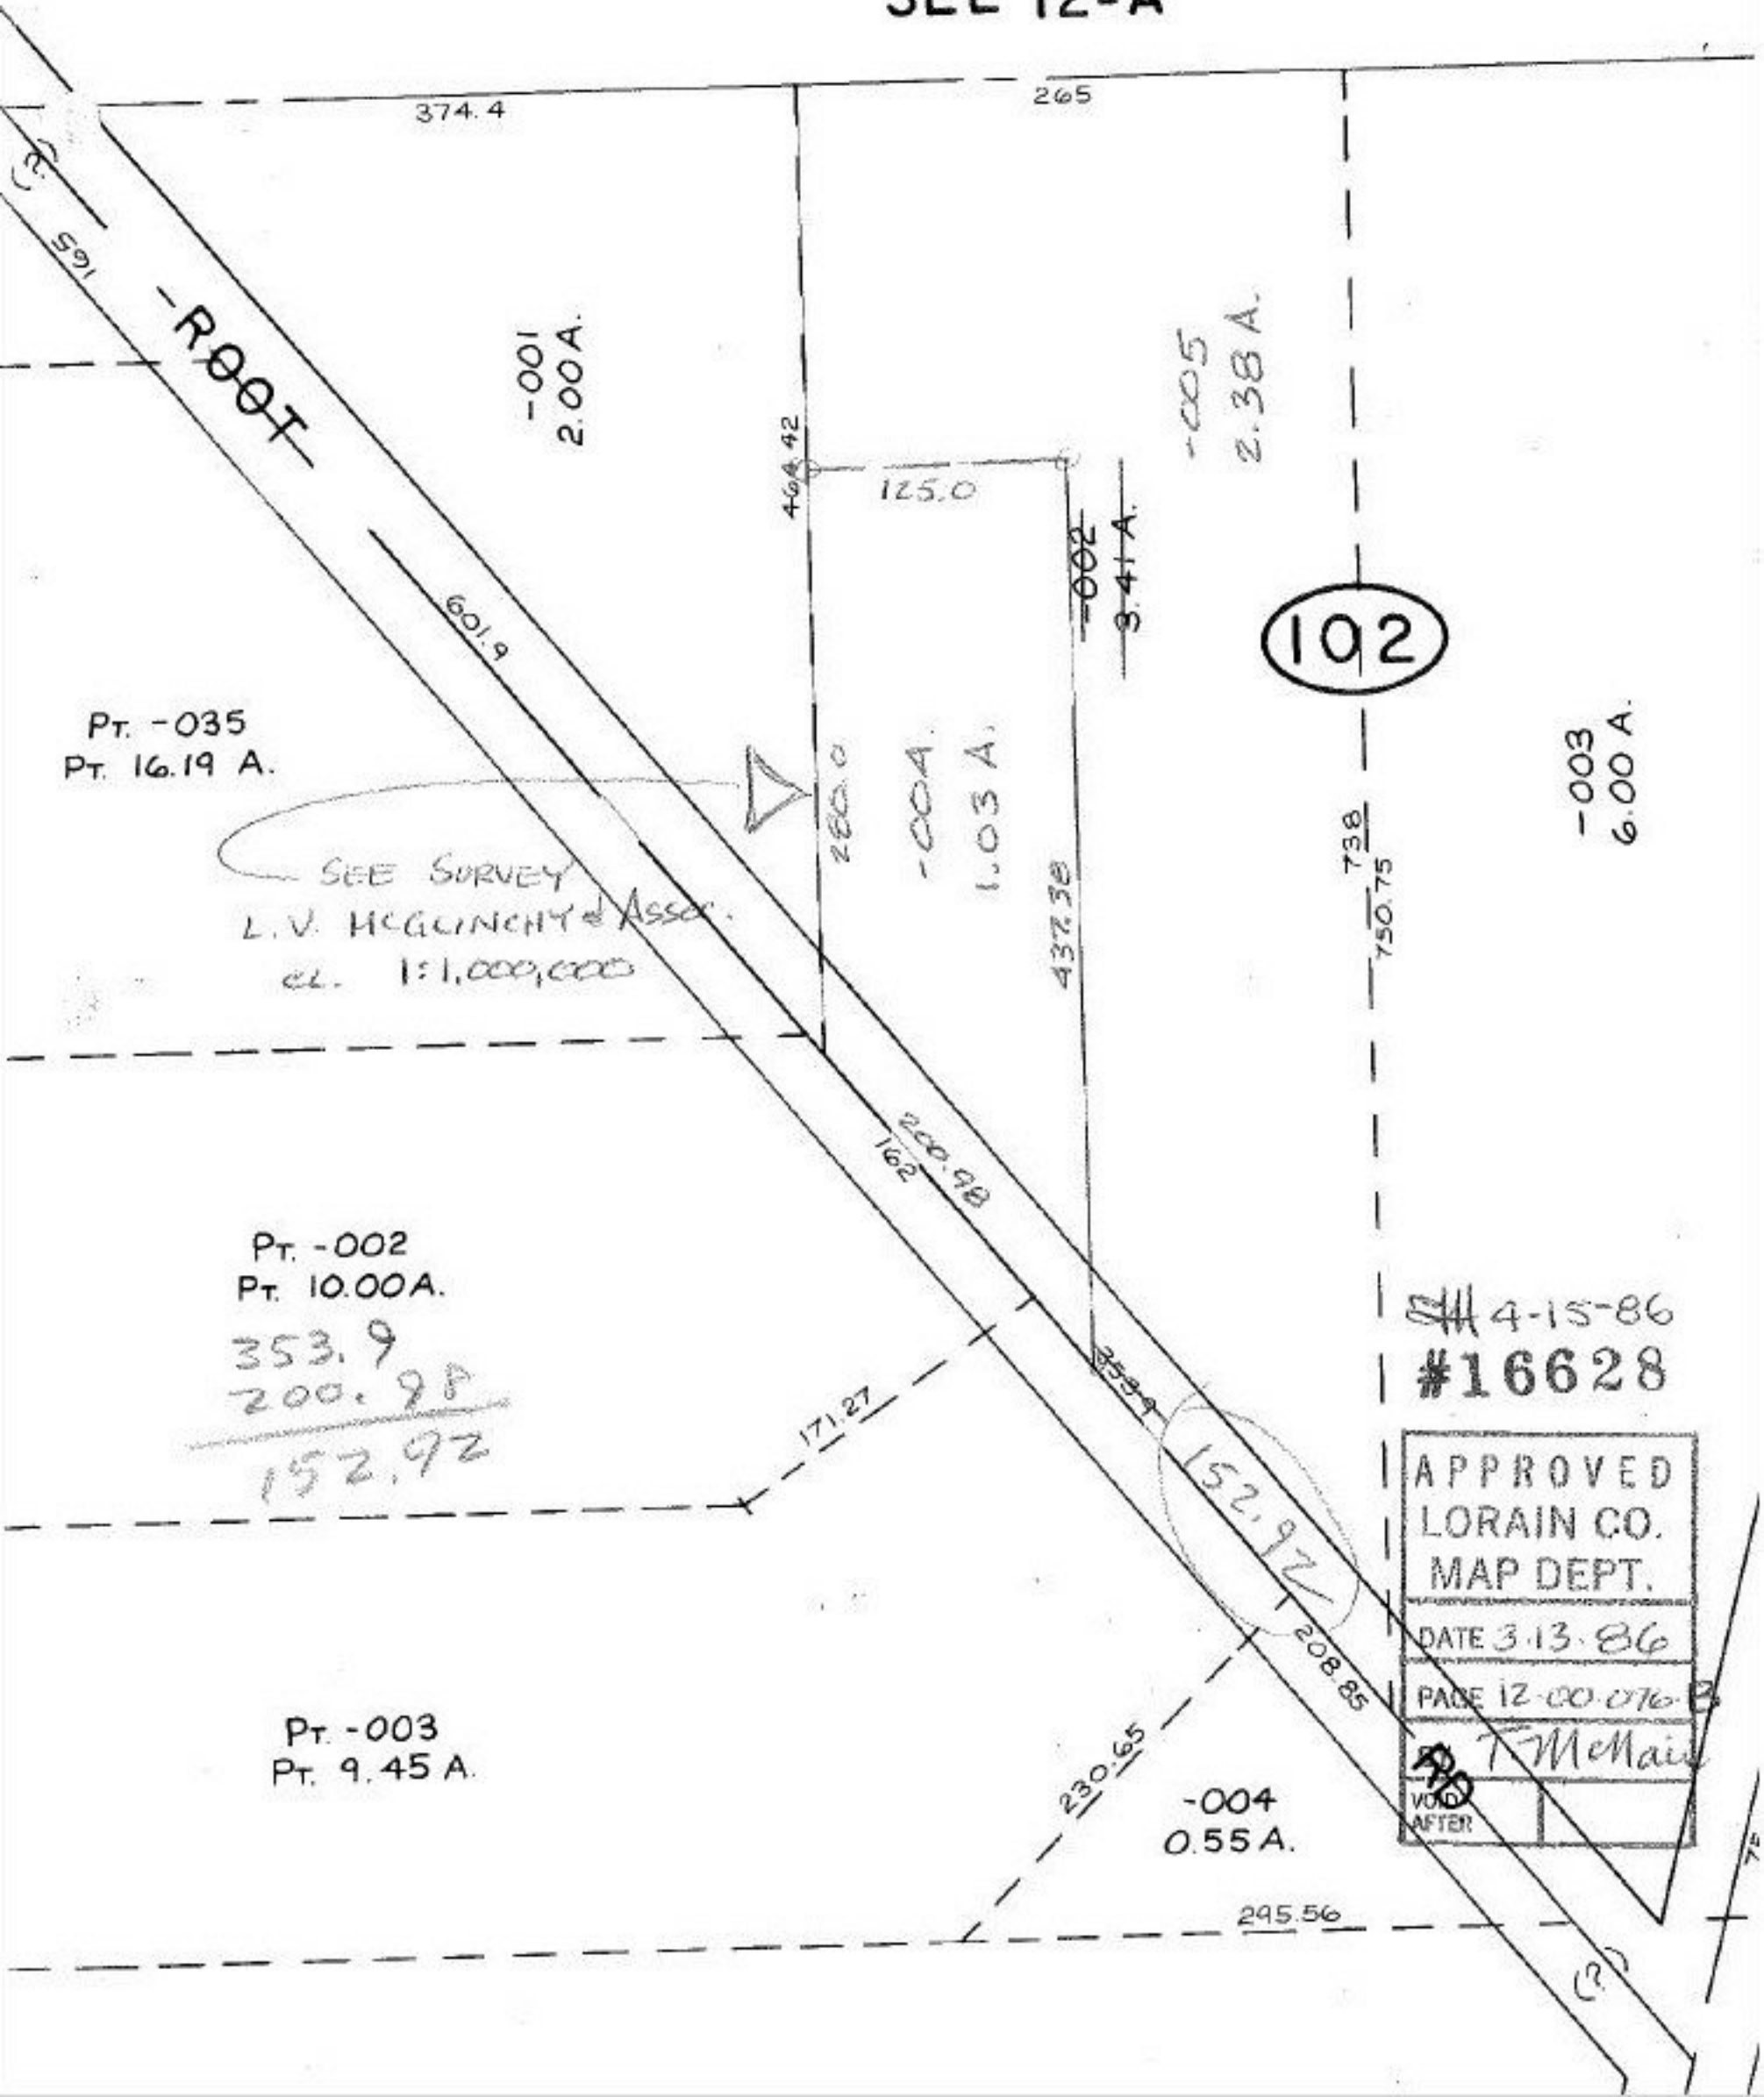

374.4

265

-ROOT

-001  
2.00 A.

-005  
2.38 A.

102

-003  
6.00 A.

Pt. -035  
Pt. 16.19 A.

SEE SURVEY  
L.V. McQUINCHY & Assoc.  
CL. 1:1,000,000

Pt. -002  
Pt. 10.00 A.

353.9  
200.98  

---

152.92

Pt. -003  
Pt. 9.45 A.

4-15-86  
#16628

|                  |
|------------------|
| APPROVED         |
| LORAIN CO.       |
| MAP DEPT.        |
| DATE 3-13-86     |
| PAGE 12-00-076-B |
| T. McMain        |
| VOID AFTER       |

200.98  
162

171.27

152.92

208.85

230.65

-004  
0.55 A.

295.56

738  
750.75

464.42

125.0

-002  
3.41 A.

437.38

280.0

-004  
1.03 A.