


100 WD
-020
20x30x35.93
TRI

-035
20x28.39x20
TRI

SURVEYED BY R.D. KELLER
CL. 1:17857

-033
0.11A.

SEE 4-00-017-F

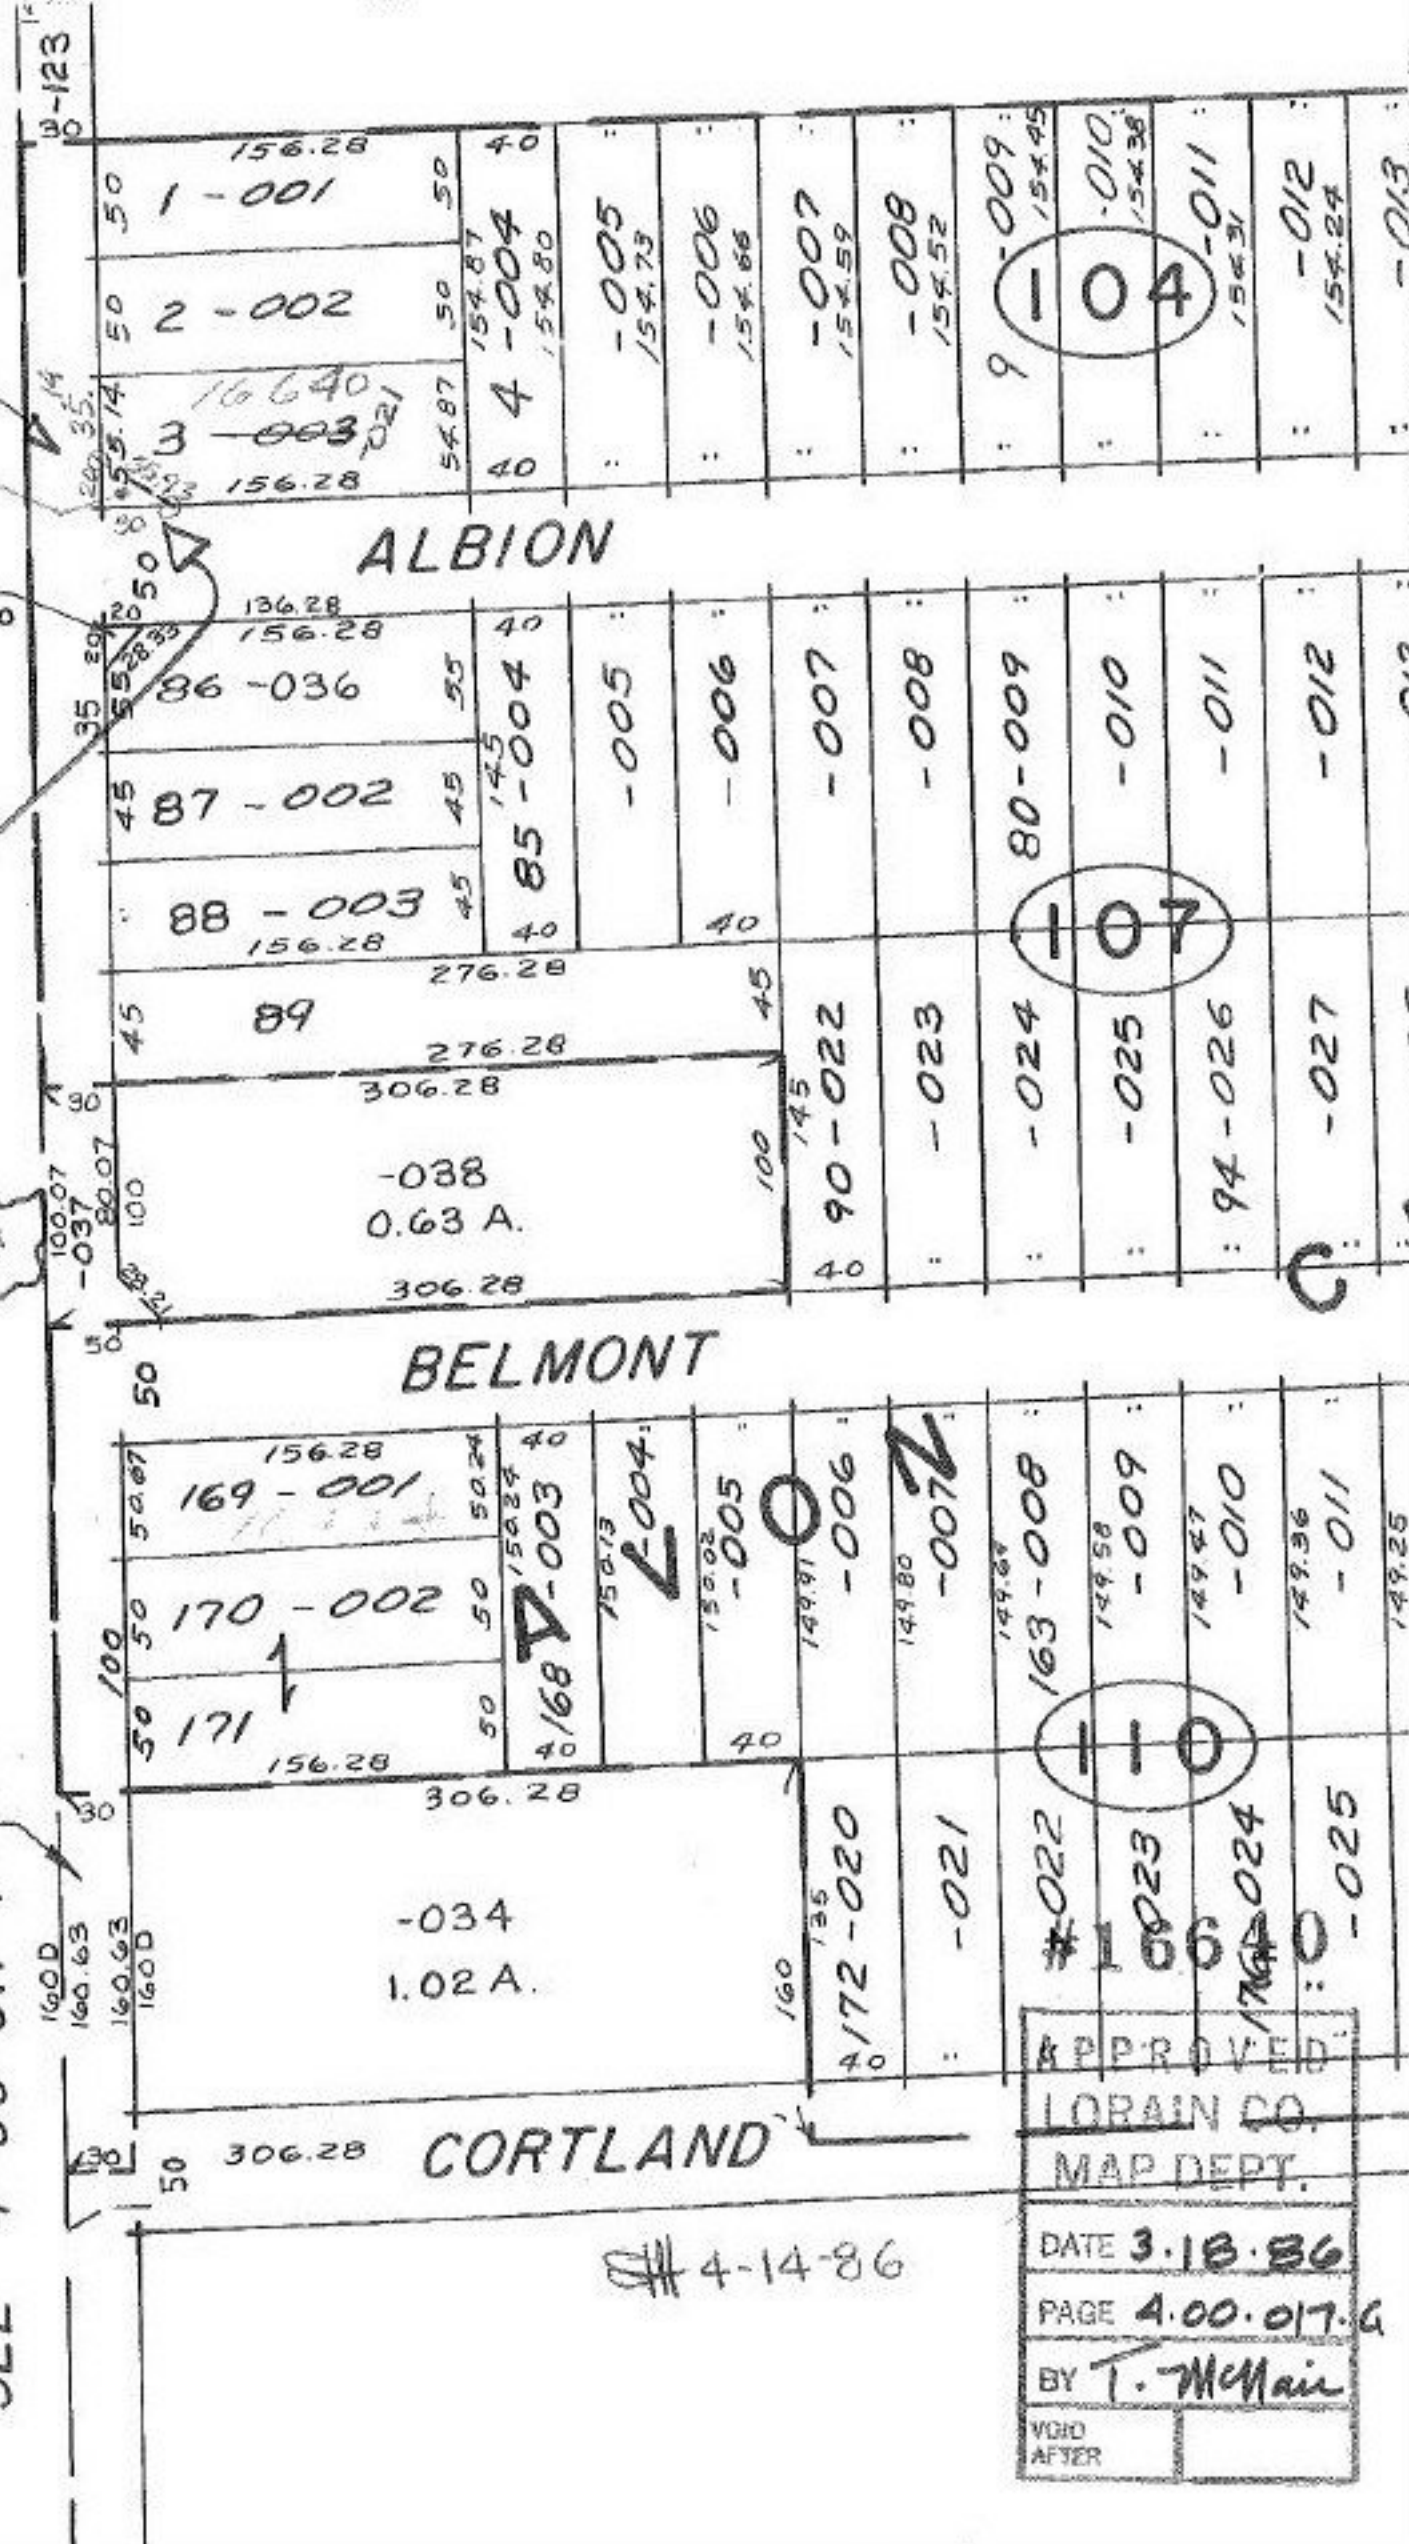

4-14-86

APPROVED	
LORAIN CO. MAP DEPT.	
DATE	3.18.86
PAGE	4.00.017-G
BY	T. McMain
VOID AFTER	