

SEE 15-F


520-28-520-28

~~030~~
~~8.44 A.~~
-043
10.17 A.

AC. CORR. PER SURVEY.
KLEINOEDER. SCHMIDT & ASSOC.
CL. 1:1,000,000

557.63

392.03

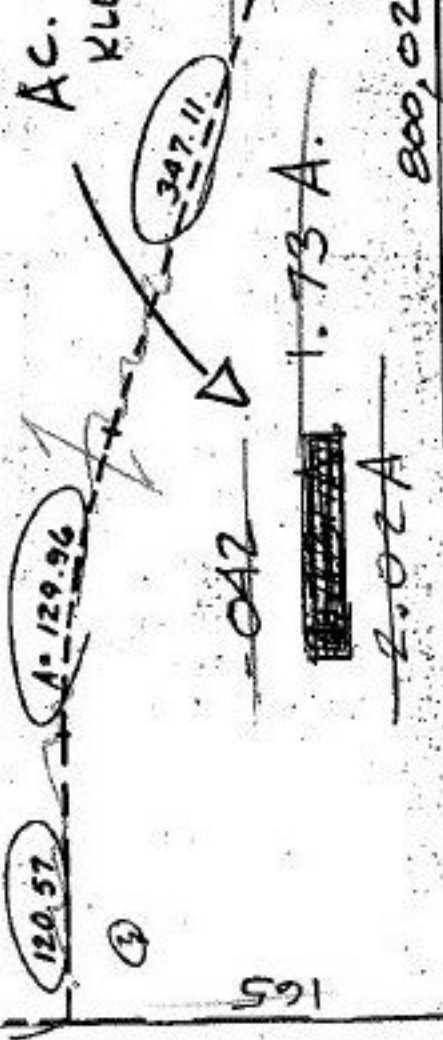

~~7-25-86~~

COMBINATION

APPROVED	
LORAIN CO.	
MAP DEPT.	
DATE 3-5-86	
RANGE 15.00.083-B	
BY T. McMain	
VOID	AFTER

166572

APPROVED	
LORAIN CO.	
MAP DEPT.	
DATE 3.25.86	
RANGE 15.00.083-B	
BY T. McMain	
VOID	AFTER

Handwritten notes and scribbles at the bottom of the page.