

-004
40.00A.


-001
69.00A.

SEE PARCEL SPLIT MAP
JOHN POZYWAK
(1:333,333)

40

-006
94.61A.

~~-004~~
~~90.62A~~

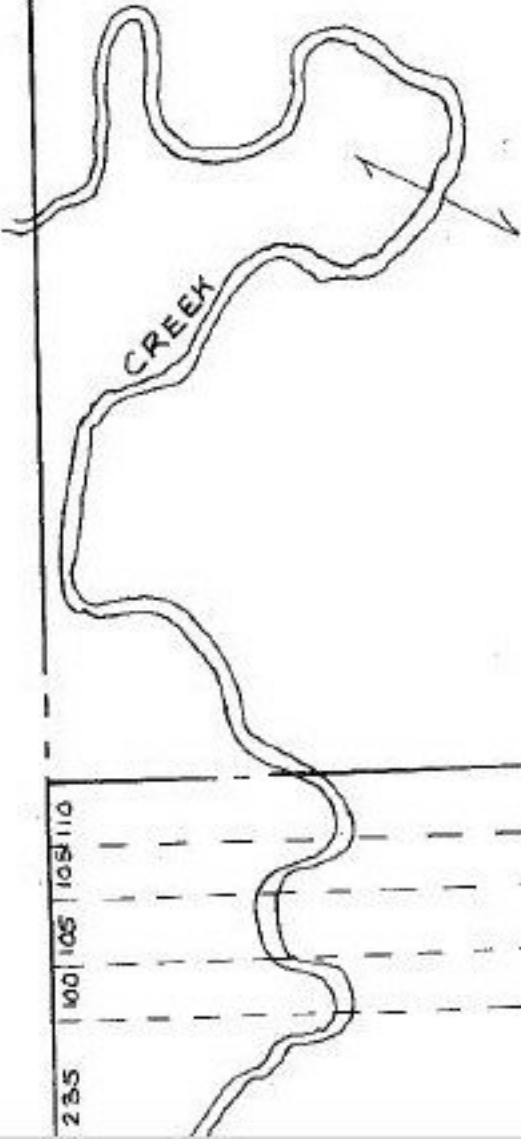

#16665

APPROVED
LORAIN CO.
MAP DEPT.

DATE 3-31-86

PAGE 15-A

BY T. McMan

VOID
AFTER

7-25-86

2733.48

2735.02

2738.17

2740.52

2742.85

2748.32

300
-003
1.38A
300

249.18
700
-005
4.01A.
700

264
264
-006
1.54A

250
-005
1.00A.
250

DIAGONAL

939.75

250
250
250
250

363
-008
1.02A.
-009
1.01A.
363

MON.

235
100
105
105
110

235
100
100
100
100

435.60