


SEE 7-00-025-B

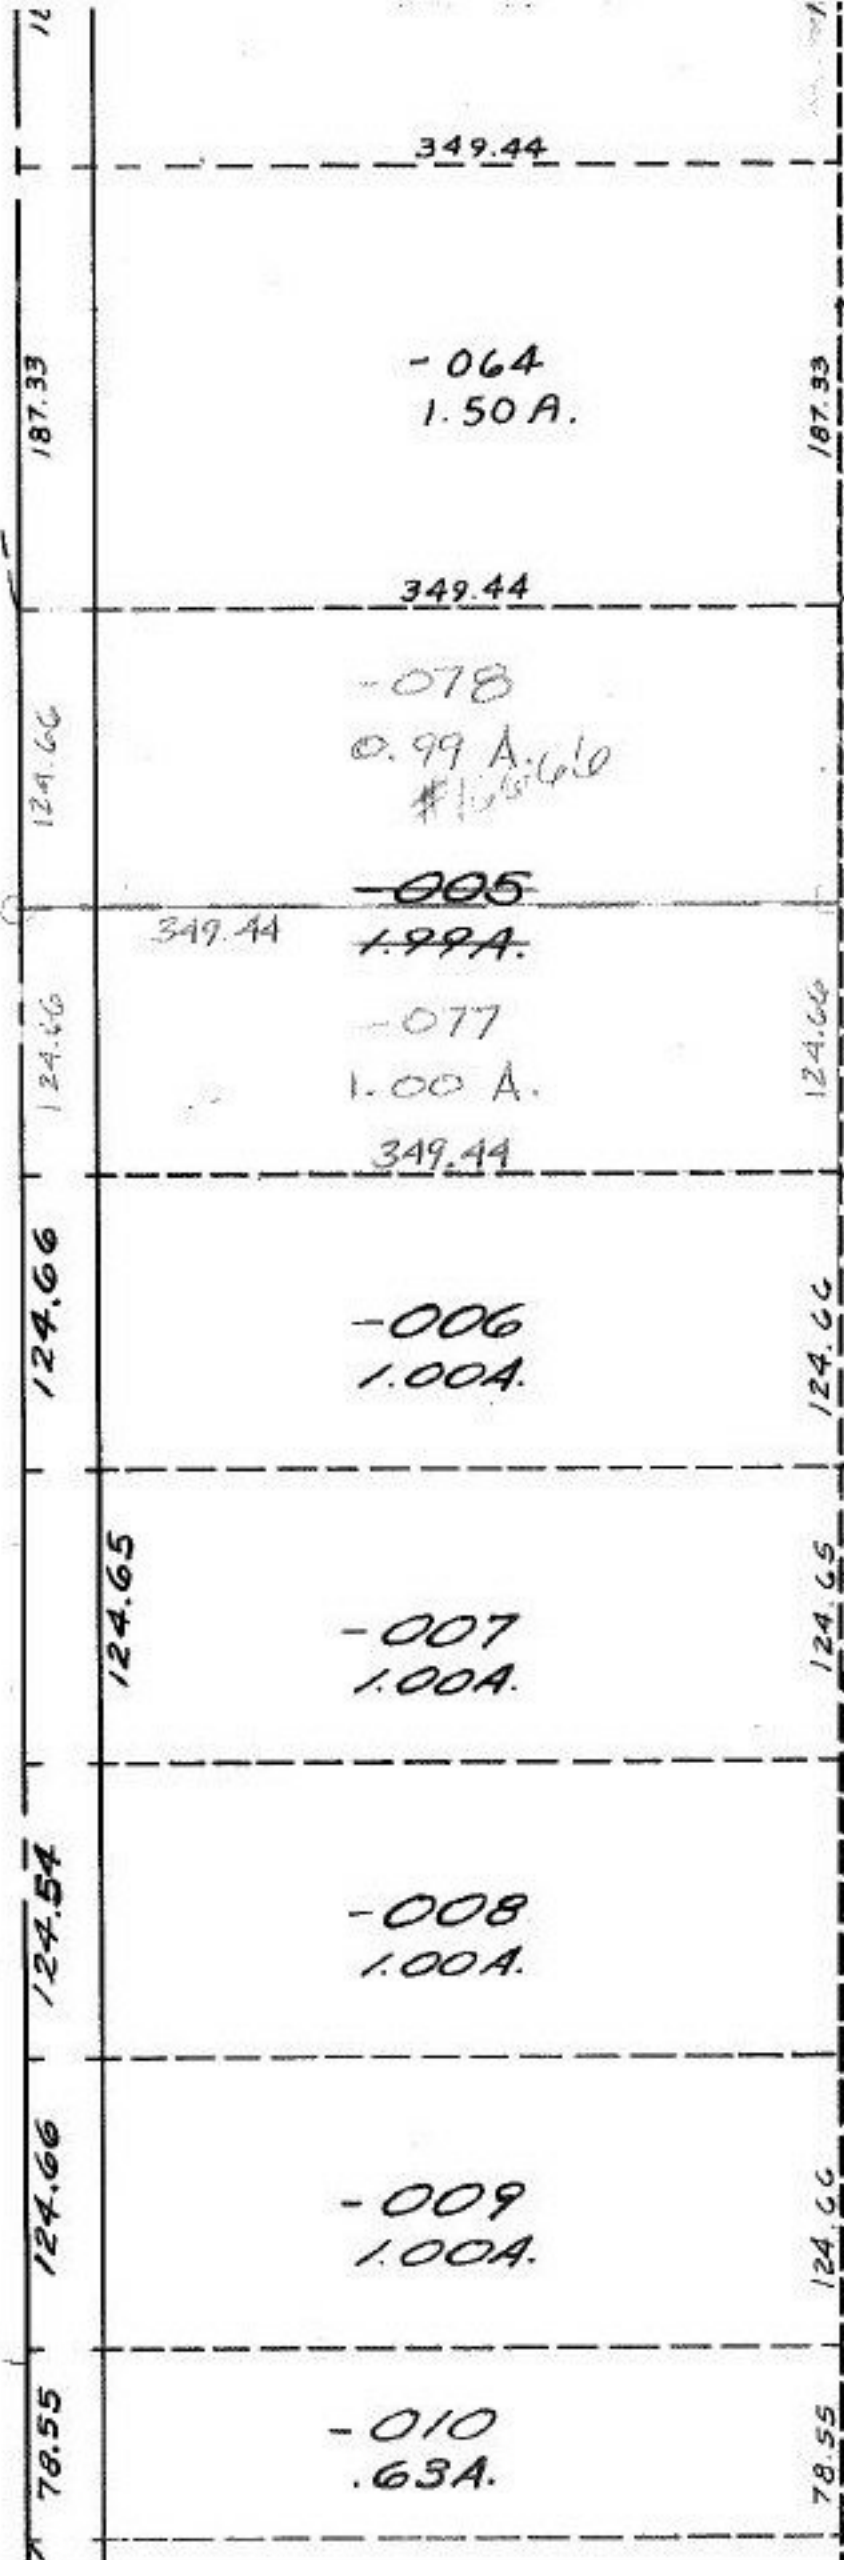

SURVEYED BY
 T.W. GAUNDON, 1947
 CL 1: INF

1528.45
 1578.06

-066
 12.81 A.

4-14-86

#16666

APPROVED	
LORAIN CO.	
MAP DEPT.	
DATE 4-1-86	
PAGE 700-024. A	
BY T. McHain	
VOID	
AFTER	