

5-27-51
2-02-001-101-1003
P

Pt. 02-03-006-110-001

OAKHILL FARMS SUB. P. 25
V. 19

839/274
Checks.

1668


APPROVED
LORAIN CO.
MAP DEPT.
DATE 4-15-68
2-02-001-A
BY D. Maynard

Pt -024
~~-003~~
~~468A~~
Pt. A. 04 A.



S. 2-29-86

SEE 2-03-006-B

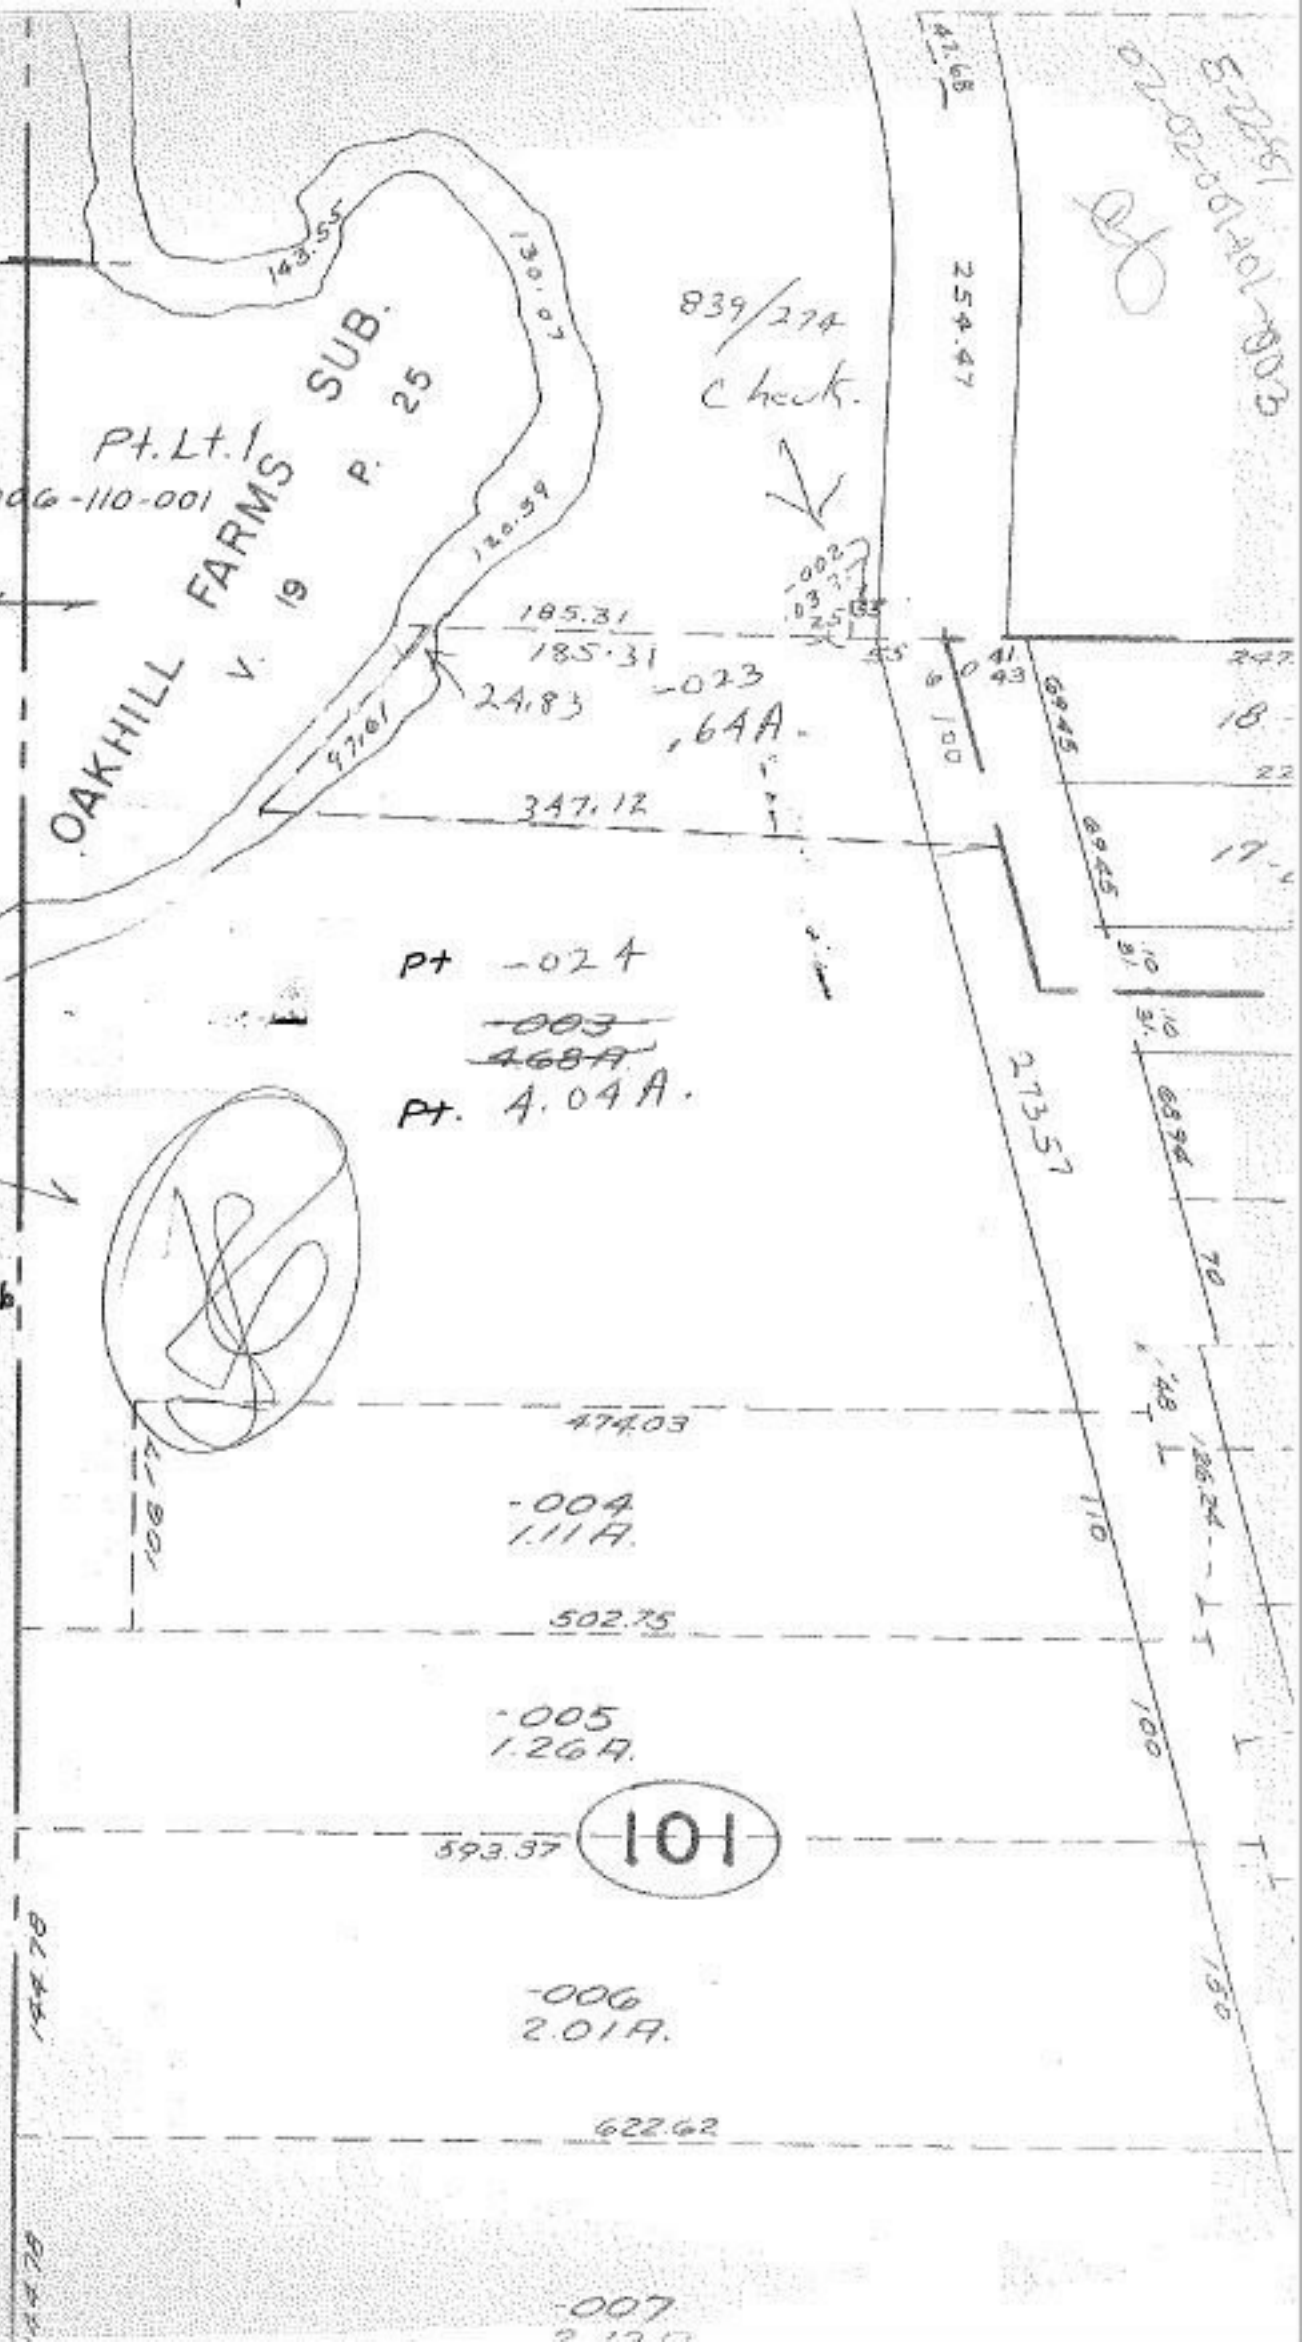

101

-006
2.01 A.

-005
1.26 A.

-004
1.11 A.

474.03

185.31
185.31

24.83

347.12

254.47

69.45

69.45

213.57

63.94

70

148 L

126.24

110

100

150

242

18

22

17

10

10

