

unc  
4-29-68  
LW Hall

1-001  
SUB

2  
R  
W  
-012  
S  
717.14


3  
-003  
A  
R  
-013  
599.73  
256.60  
328.88

110

04

69

111

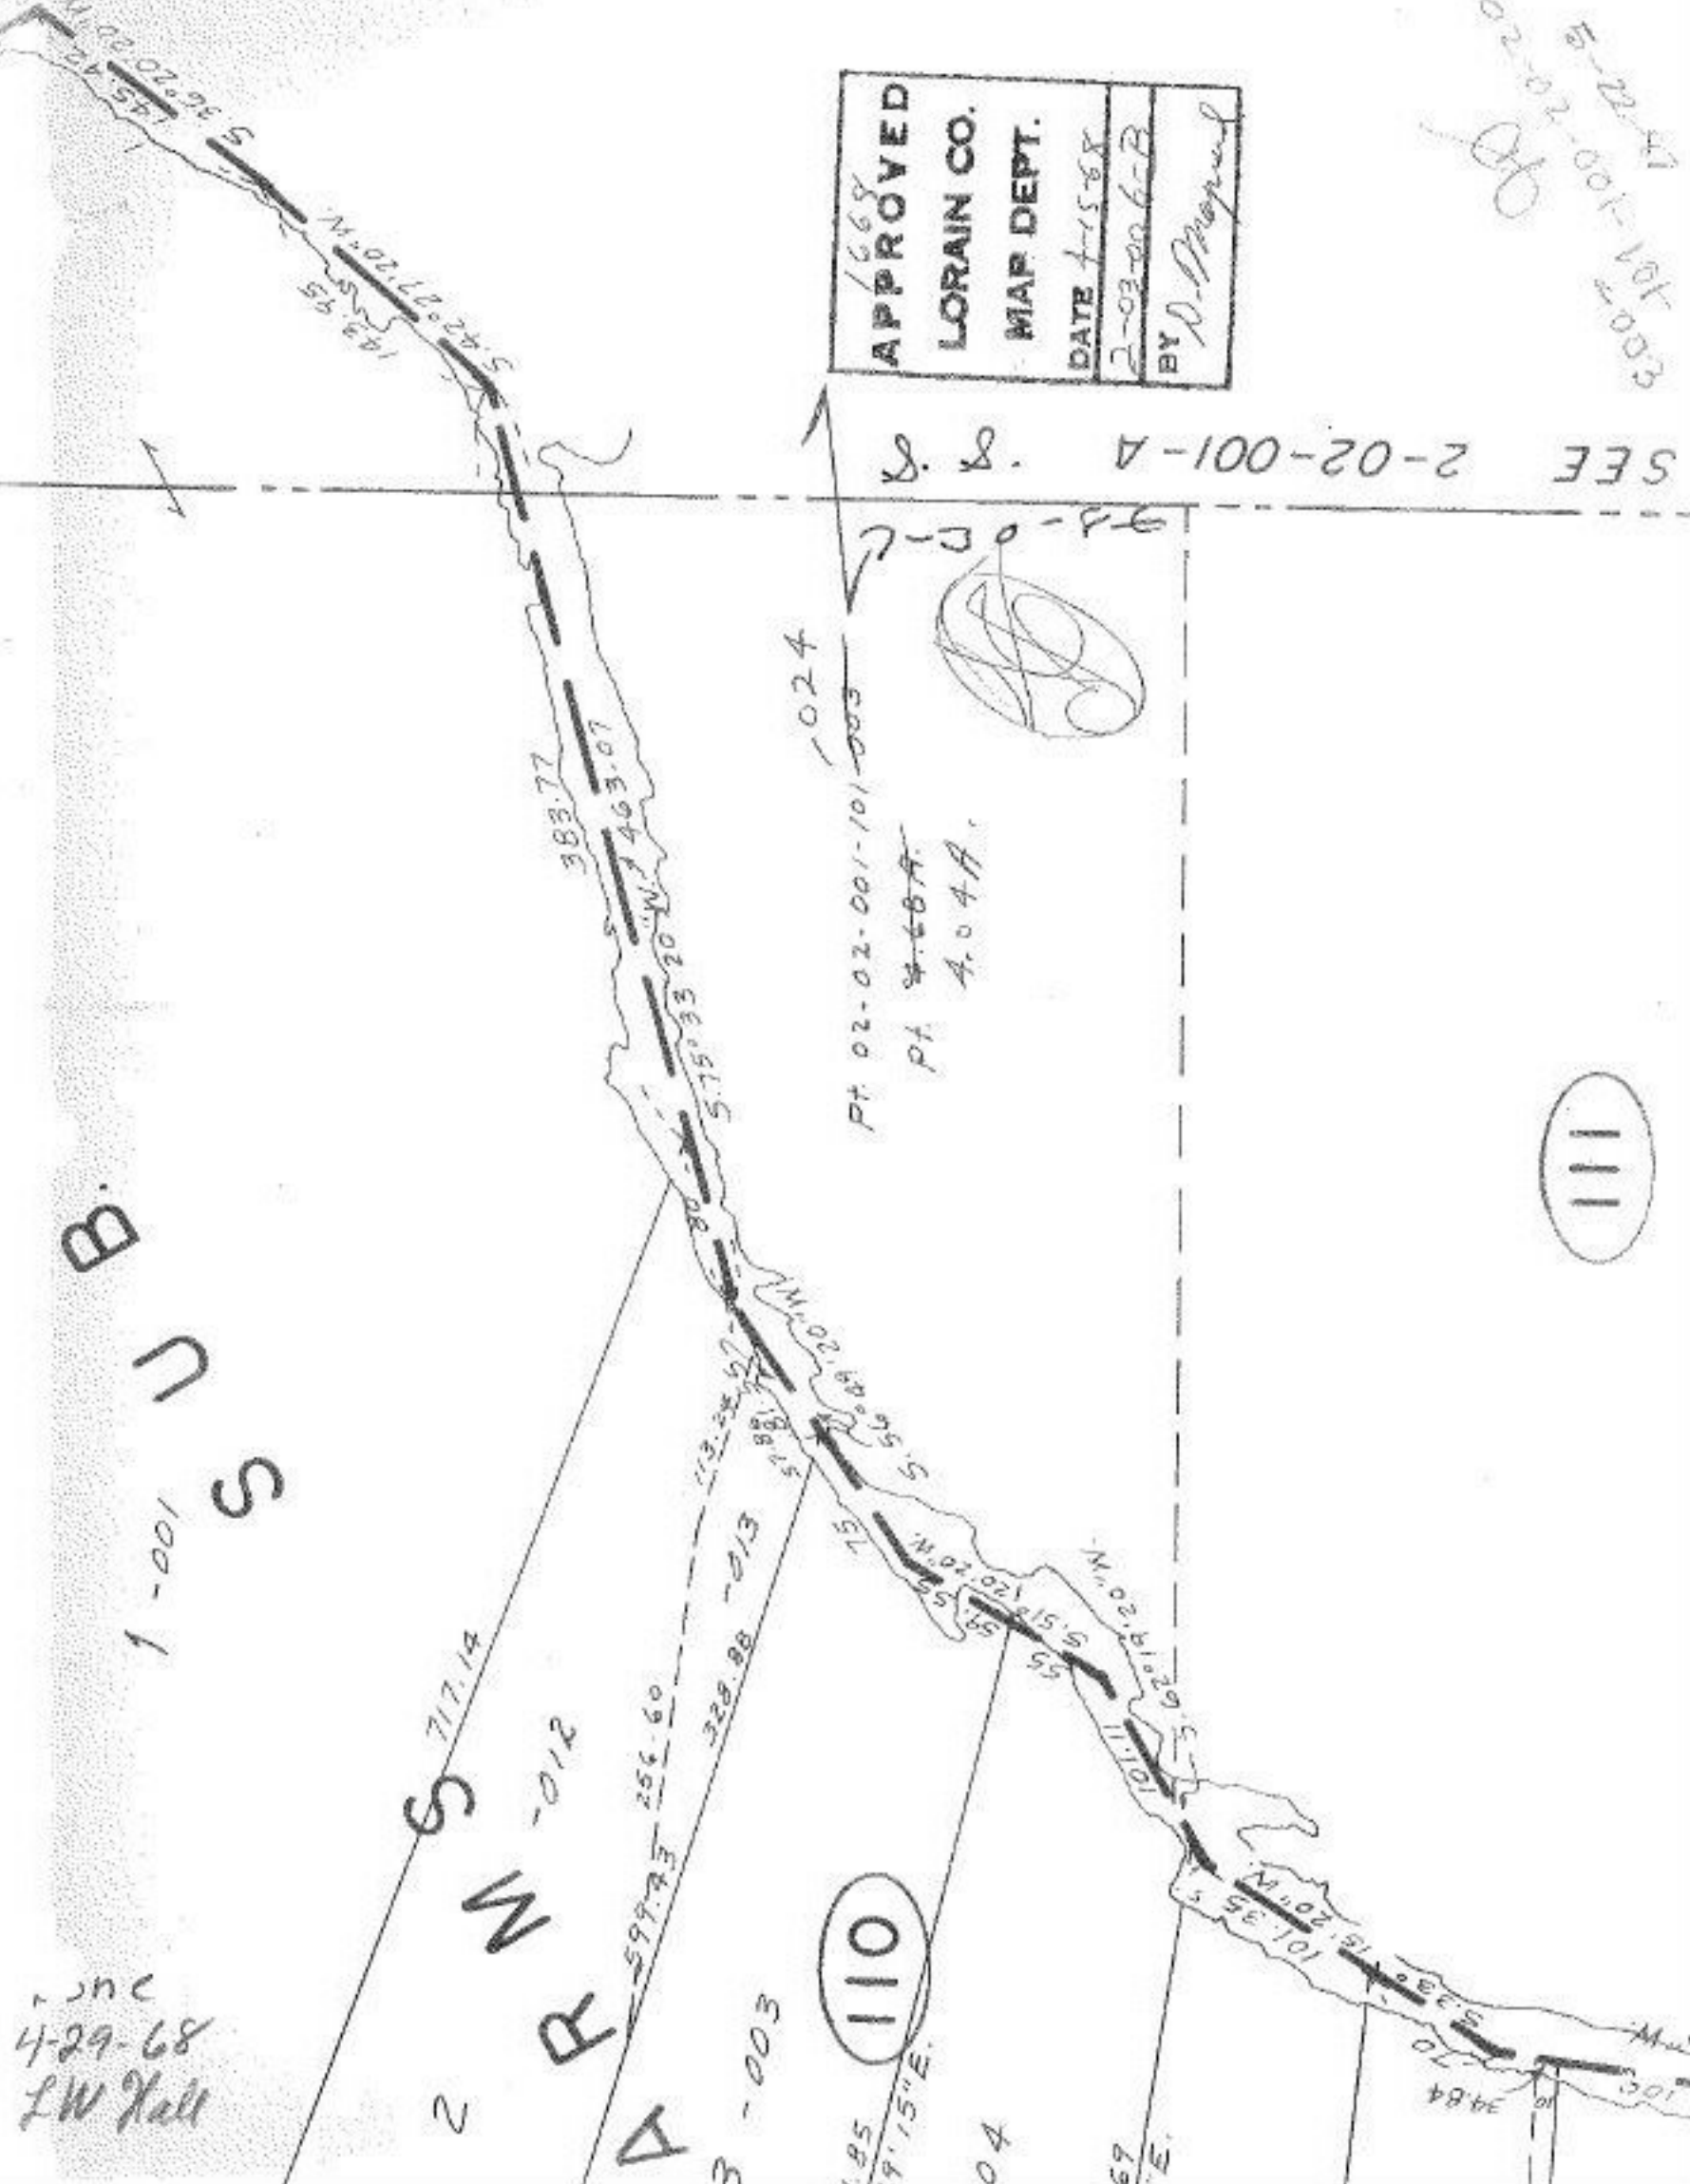

APPROVED
LORAIN CO.
MAP DEPT.
DATE 4-15-68
BY D. D. Proquest

SEE 2-02-001-A

Pt 02-02-001-101-003

Pt 4-68A  
A.04A

Handwritten signature

Handwritten notes and numbers: 2-02-001-101-003-101-003-101-003-101-003