


# DEED CHECK

- only -

11-00-025-000-009

1173/475

\* SCHILD, DONALD W. ETAL 4-29-77 1173/475  
 MAP AGREES WITH DIMENSIONS ON ABOVE DEED.  
 DEED SUBMITTED FOR CHECK ON 4/15/86 DID NOT  
 AGREE w/ MAP OR DEED

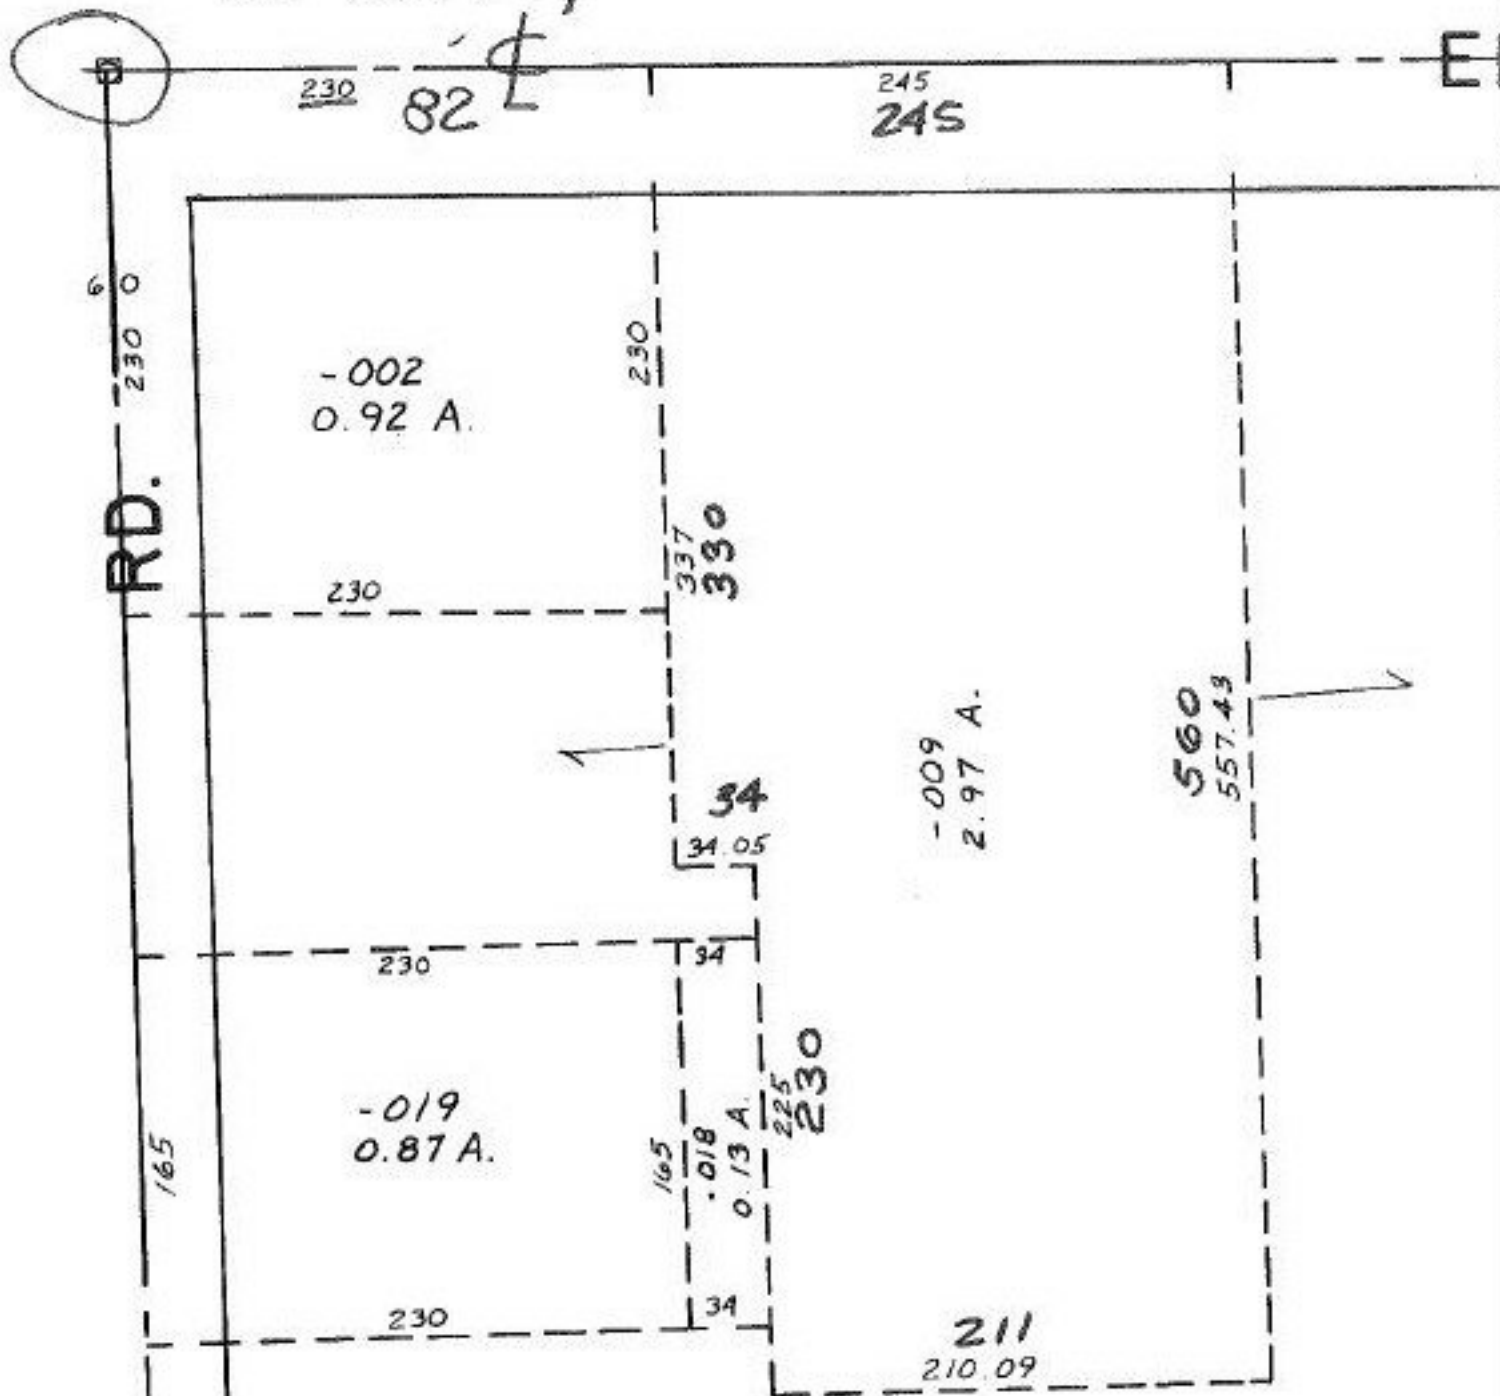

Distances ~~on~~ on Deed Do  
 Not agree with TAX MAP

No Acreages on Deed #16687

11-00-025-A

4-15-86

T. M.

APPROVED LORAIN CO. MAP DEPT.	
DATE 4-15-86	
PAGE 11-00-025-A	
BY C. FRANCIS	
VOID AFTER	