

405


90

70.70

C=1:55555.55556

C=1:18867.92453

Survey By:  
Charles Waryu  
Reg. Surveyor.  
069  
5.29 A.

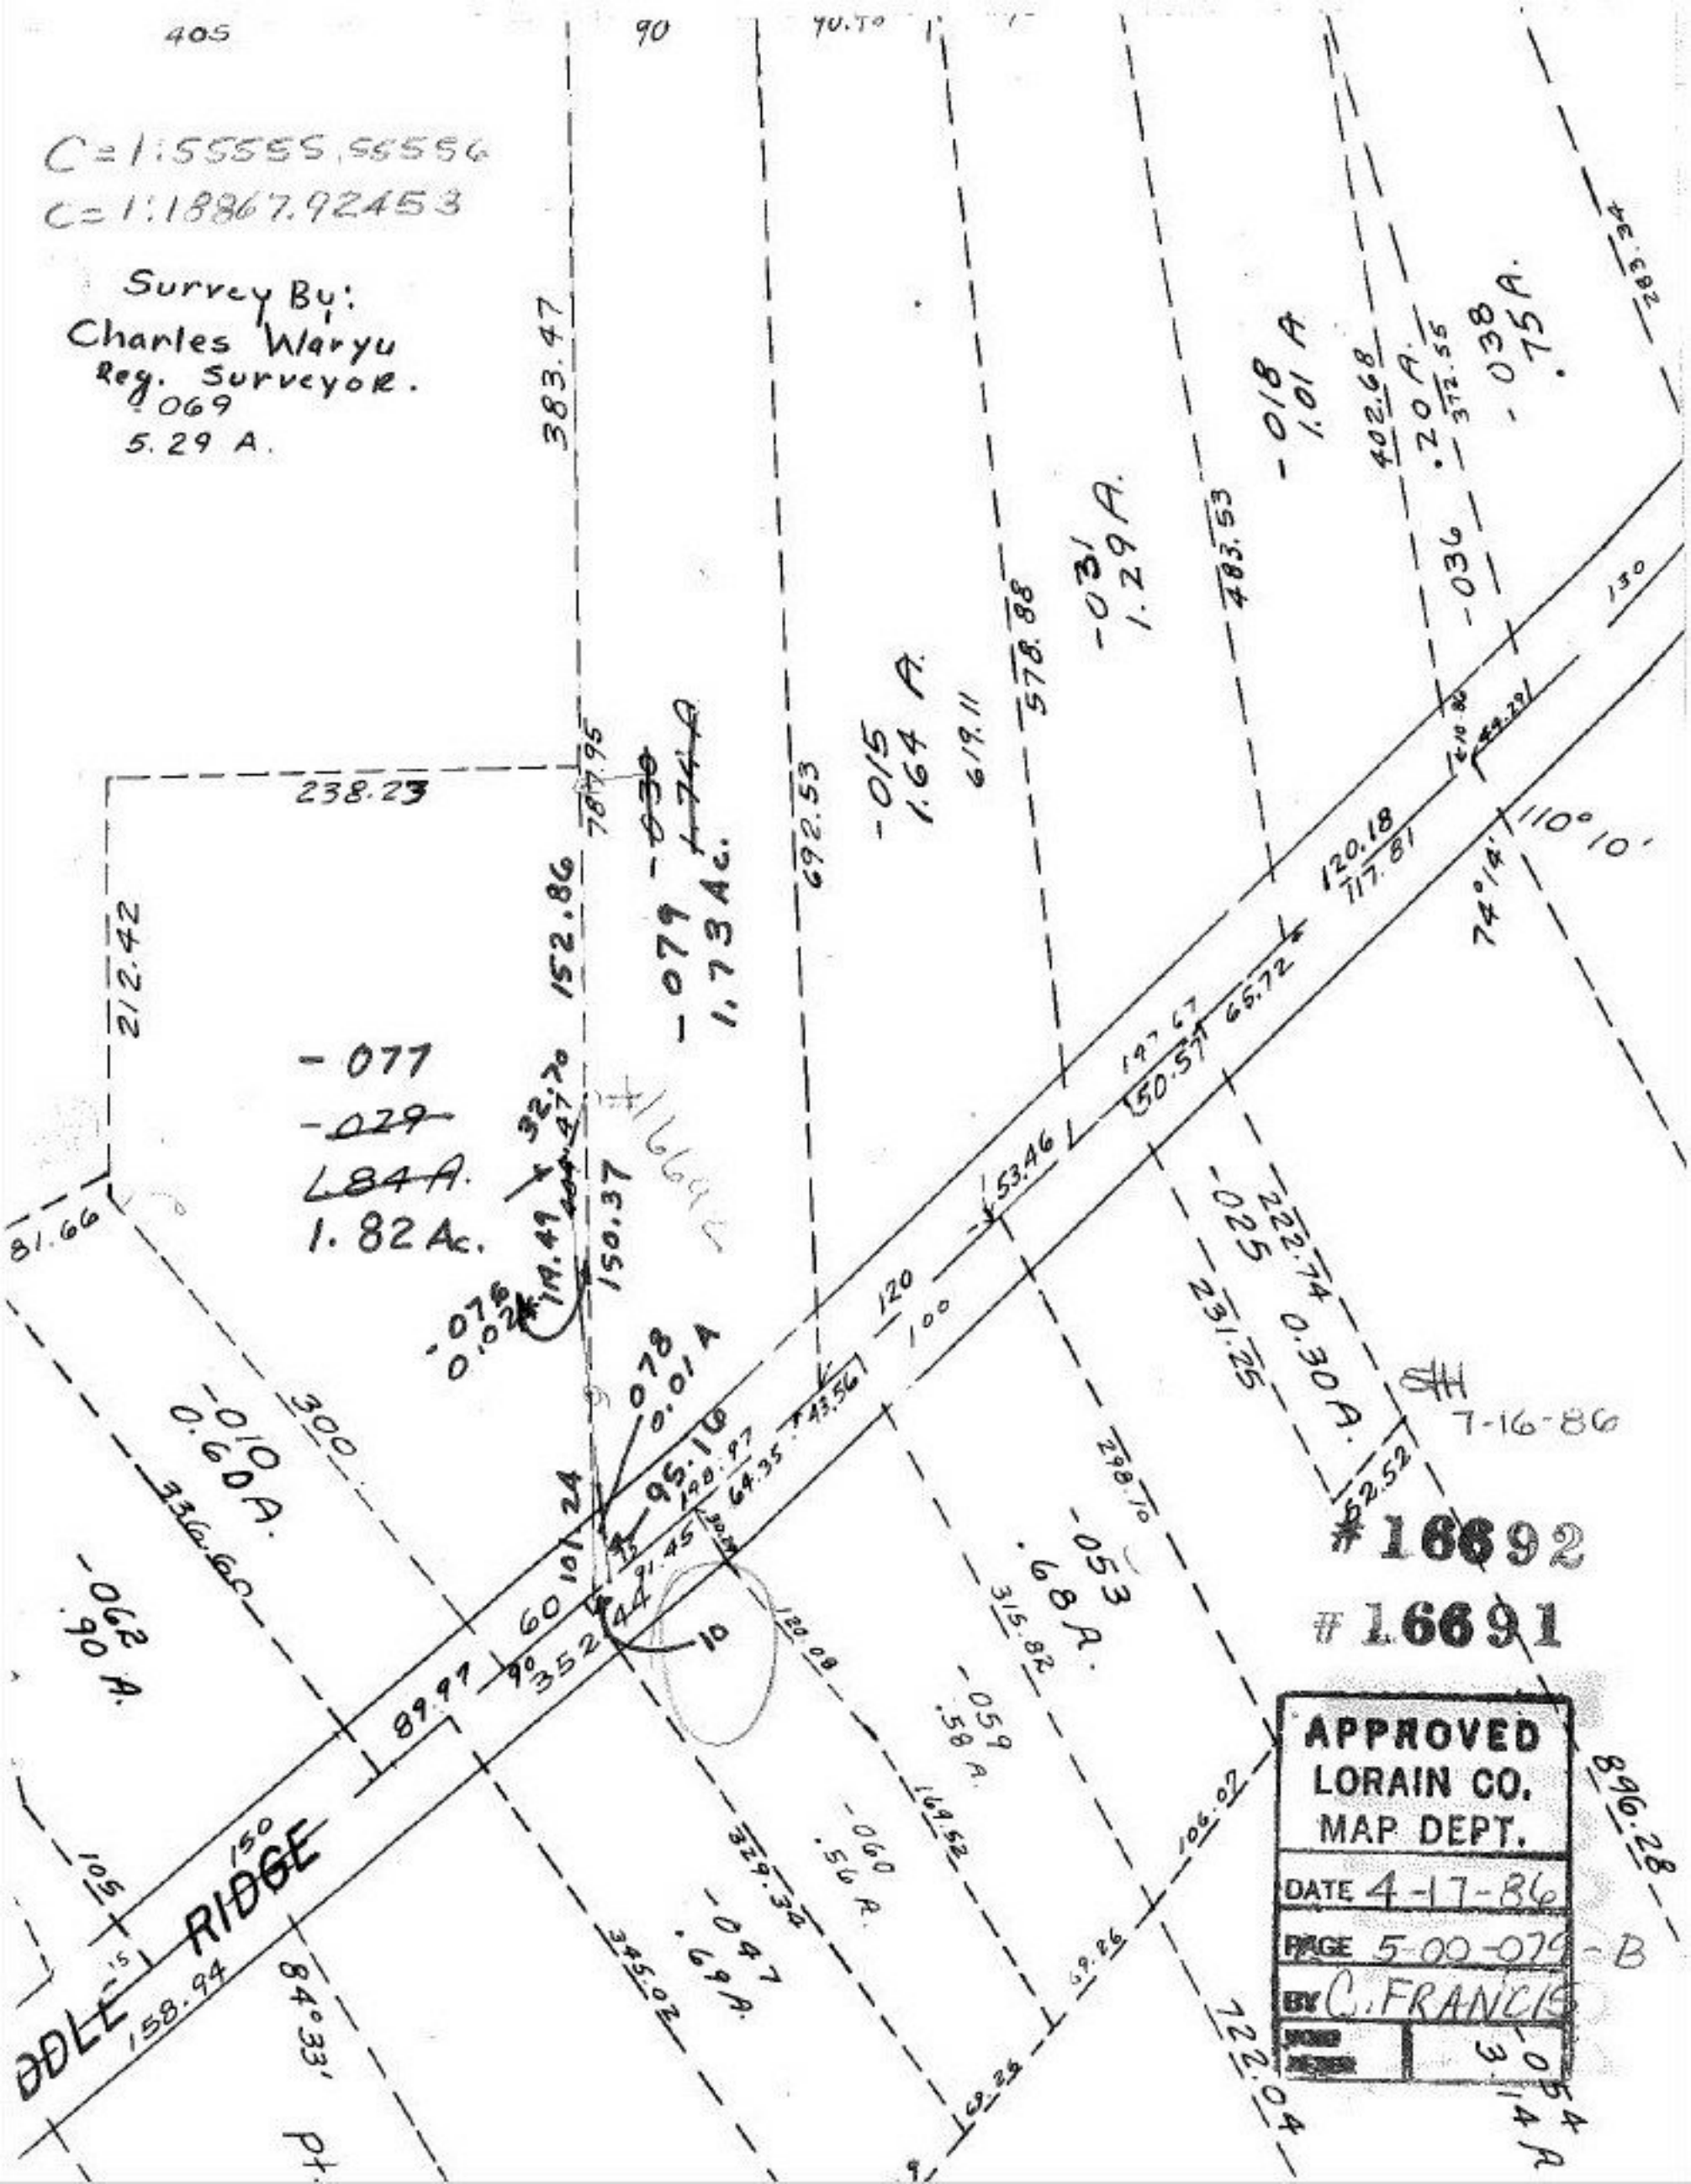

- 077

- 029

1.84 A.

1.82 Ac.

- 079 - 030  
1.73 Ac.

- 015  
1.64 A.

- 031  
1.29 A.

- 018  
1.01 A.

- 038  
0.75 A.

- 010  
0.60 A.

- 062  
0.90 A.

- 078  
0.01 A

- 053  
0.8 A.

# 16692

# 16691

APPROVED  
LORAIN CO.  
MAP DEPT.  
DATE 4-17-86  
PAGE 5-00-079-B  
BY C. FRANCIS

RIDGE

ADLT

84°33' PT.

7-16-86

896.28

054  
3.14 A