


Prior
Deed-
C=1:1NF

AC. CORR. REK. SURVEYED
DEED BY: C. E. PENFOUND
REG. SURVEYOR 6/30/56

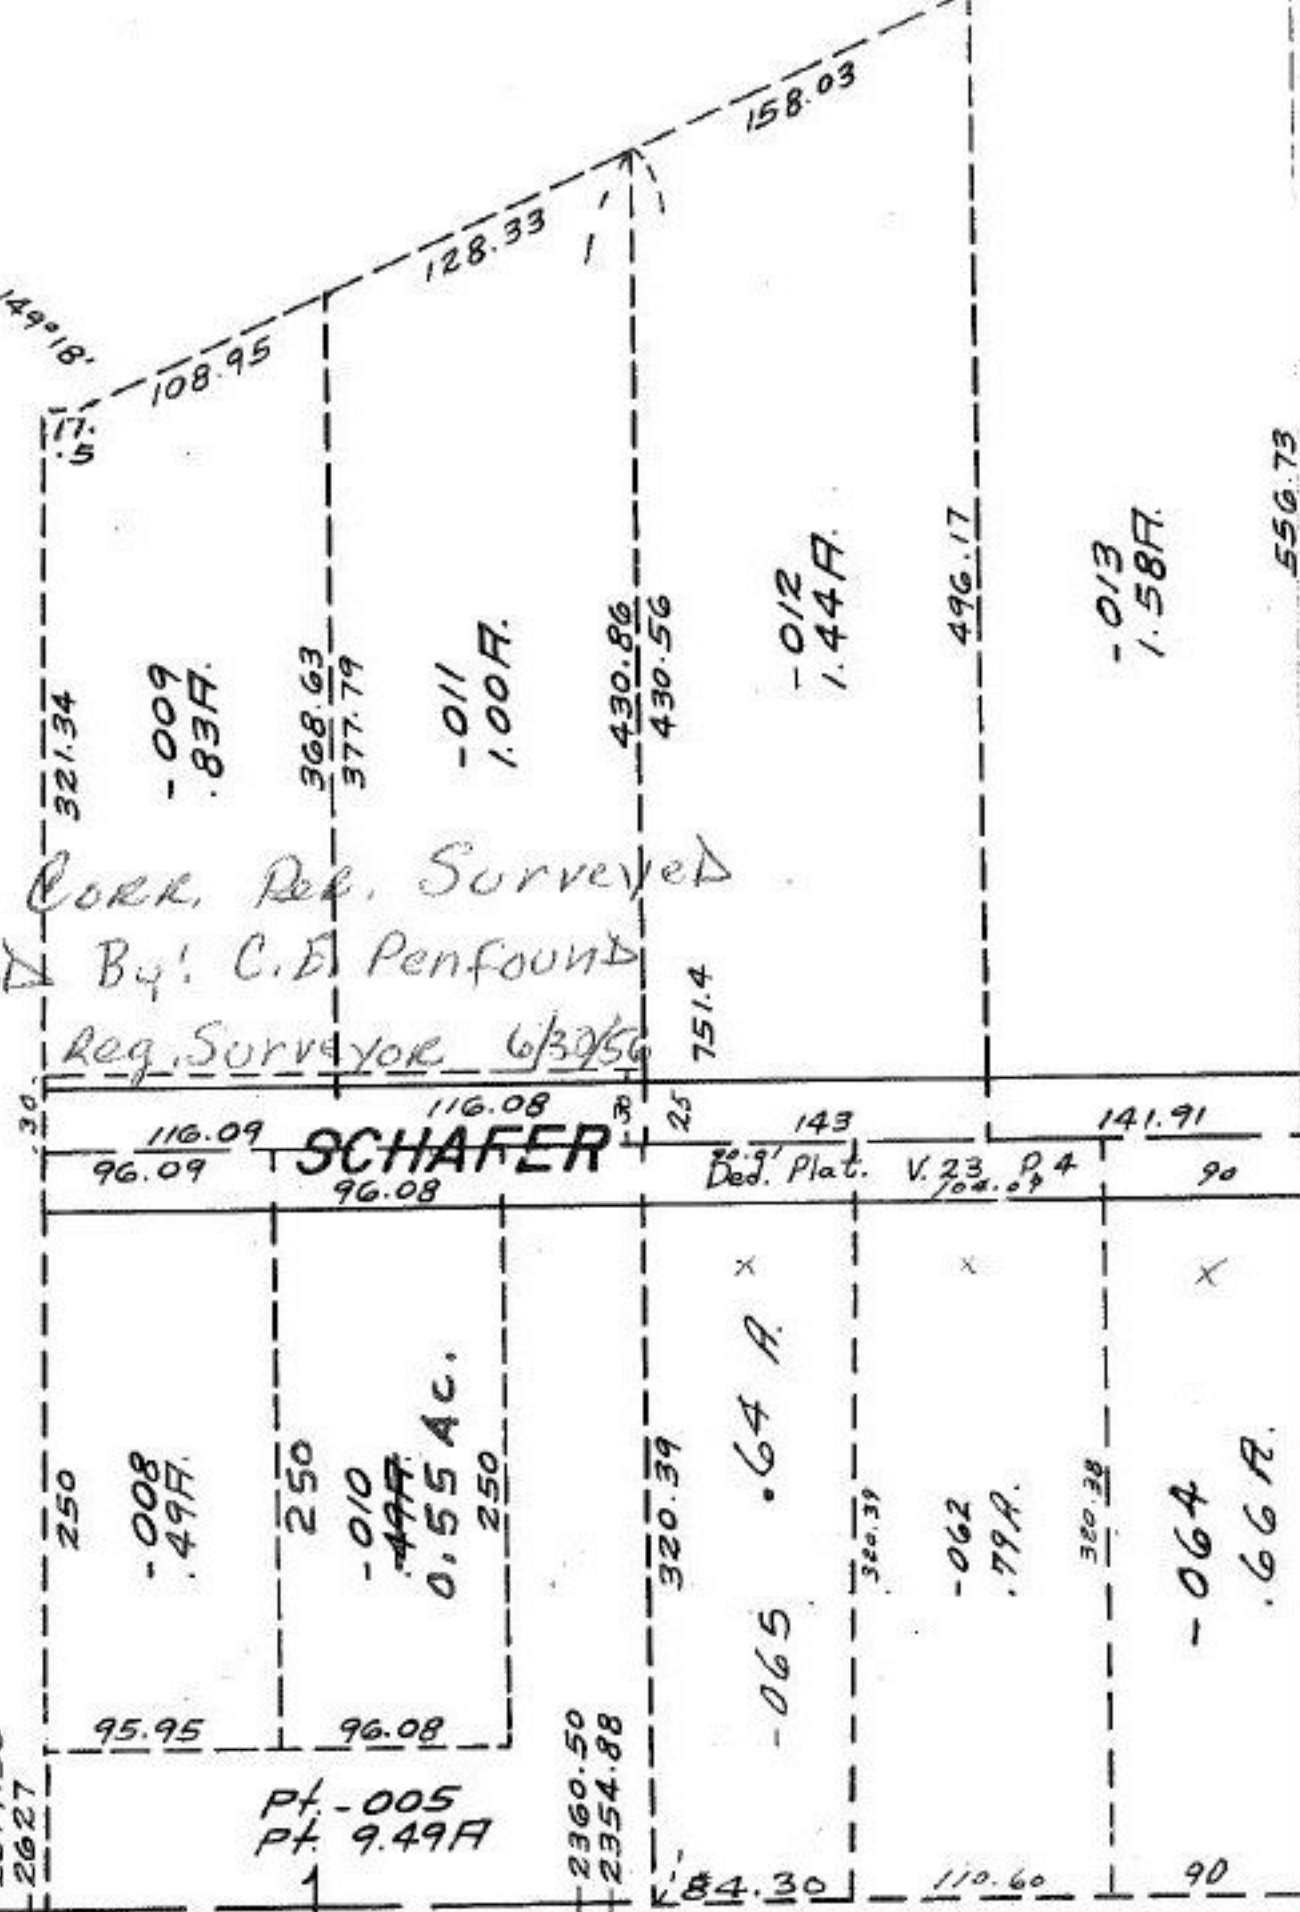

7-17-86

16700 SEE 7-

APPROVED
LORAIN CO.
MAP DEPT.
DATE 4-21-86
PAGE 7-00-028-A
C. FRANCIS

RIDGEVILLE

SCALE: 1" = 100'

028-A