


-016
4.75 A.

220.60

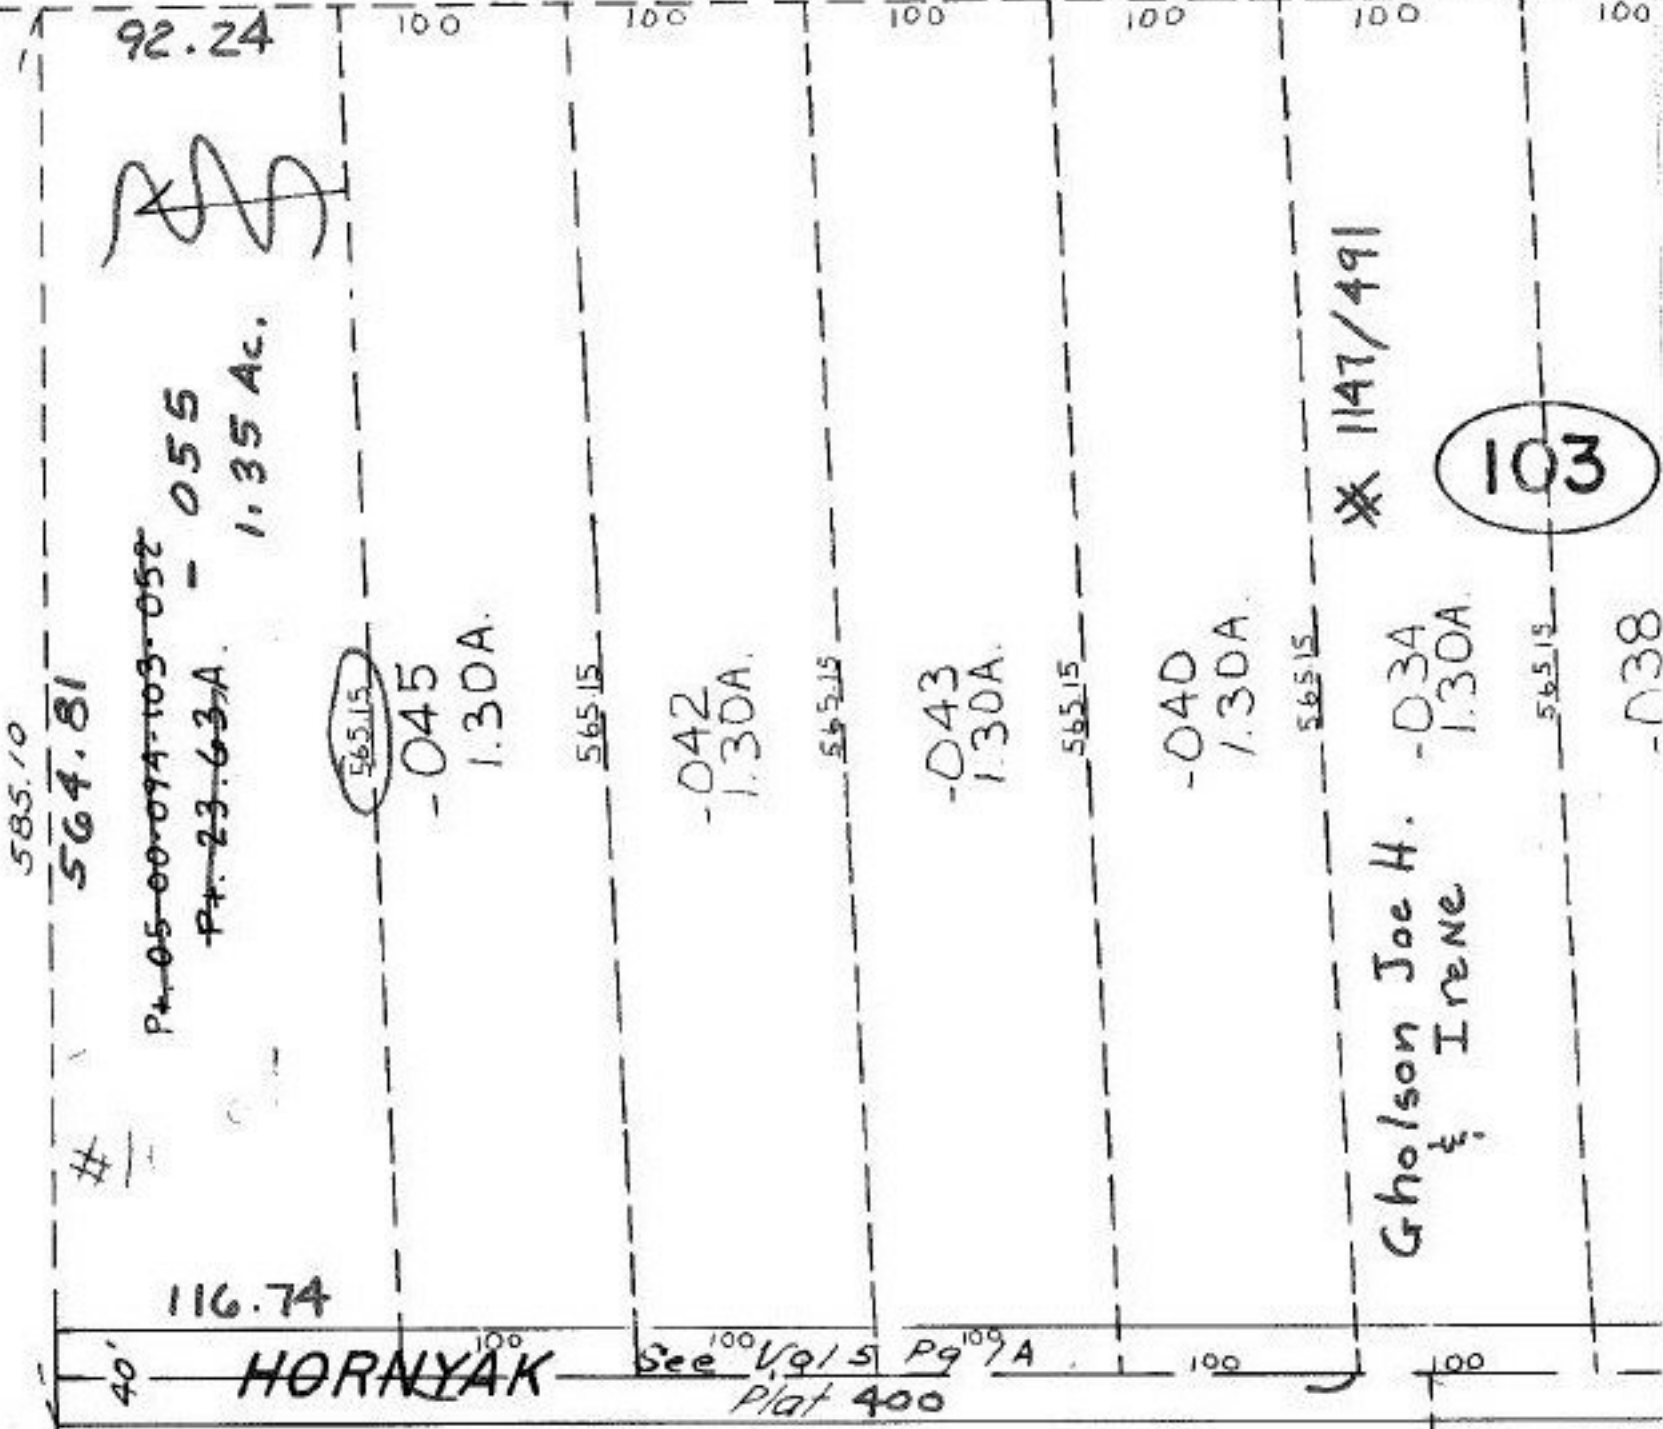

Prior D.R. 1105/13
 Deed Surveyed
 BY: Arnold Koepf
 Reg. Surveyor
 C=1: 52631.57895

-022
 4.00 A.

16701

APPROVED
LORAIN CO.
MAR 1986
DATE 4-22-86
FILE 500-094-103-052
BY C. FRANKIA
VOID
REISSUE

-023
 1.00 A.