

Prior D.R. 615/82
 Surveyed BY: K.S.A.
 C=1"=100'

SEE 6-2

BLVD.

Pt. -020 - 032
 Pt. 10.12A 10.13A

COMBINATION

-031
 0.05A

7-16-86


735.91
 88.35
 Pt. -033
 Pt. 6.63A
 109.78

16

102

335.44
 PAGE 6-10
 BY C. FRANKS
 VOID AFTER 10710

#16710

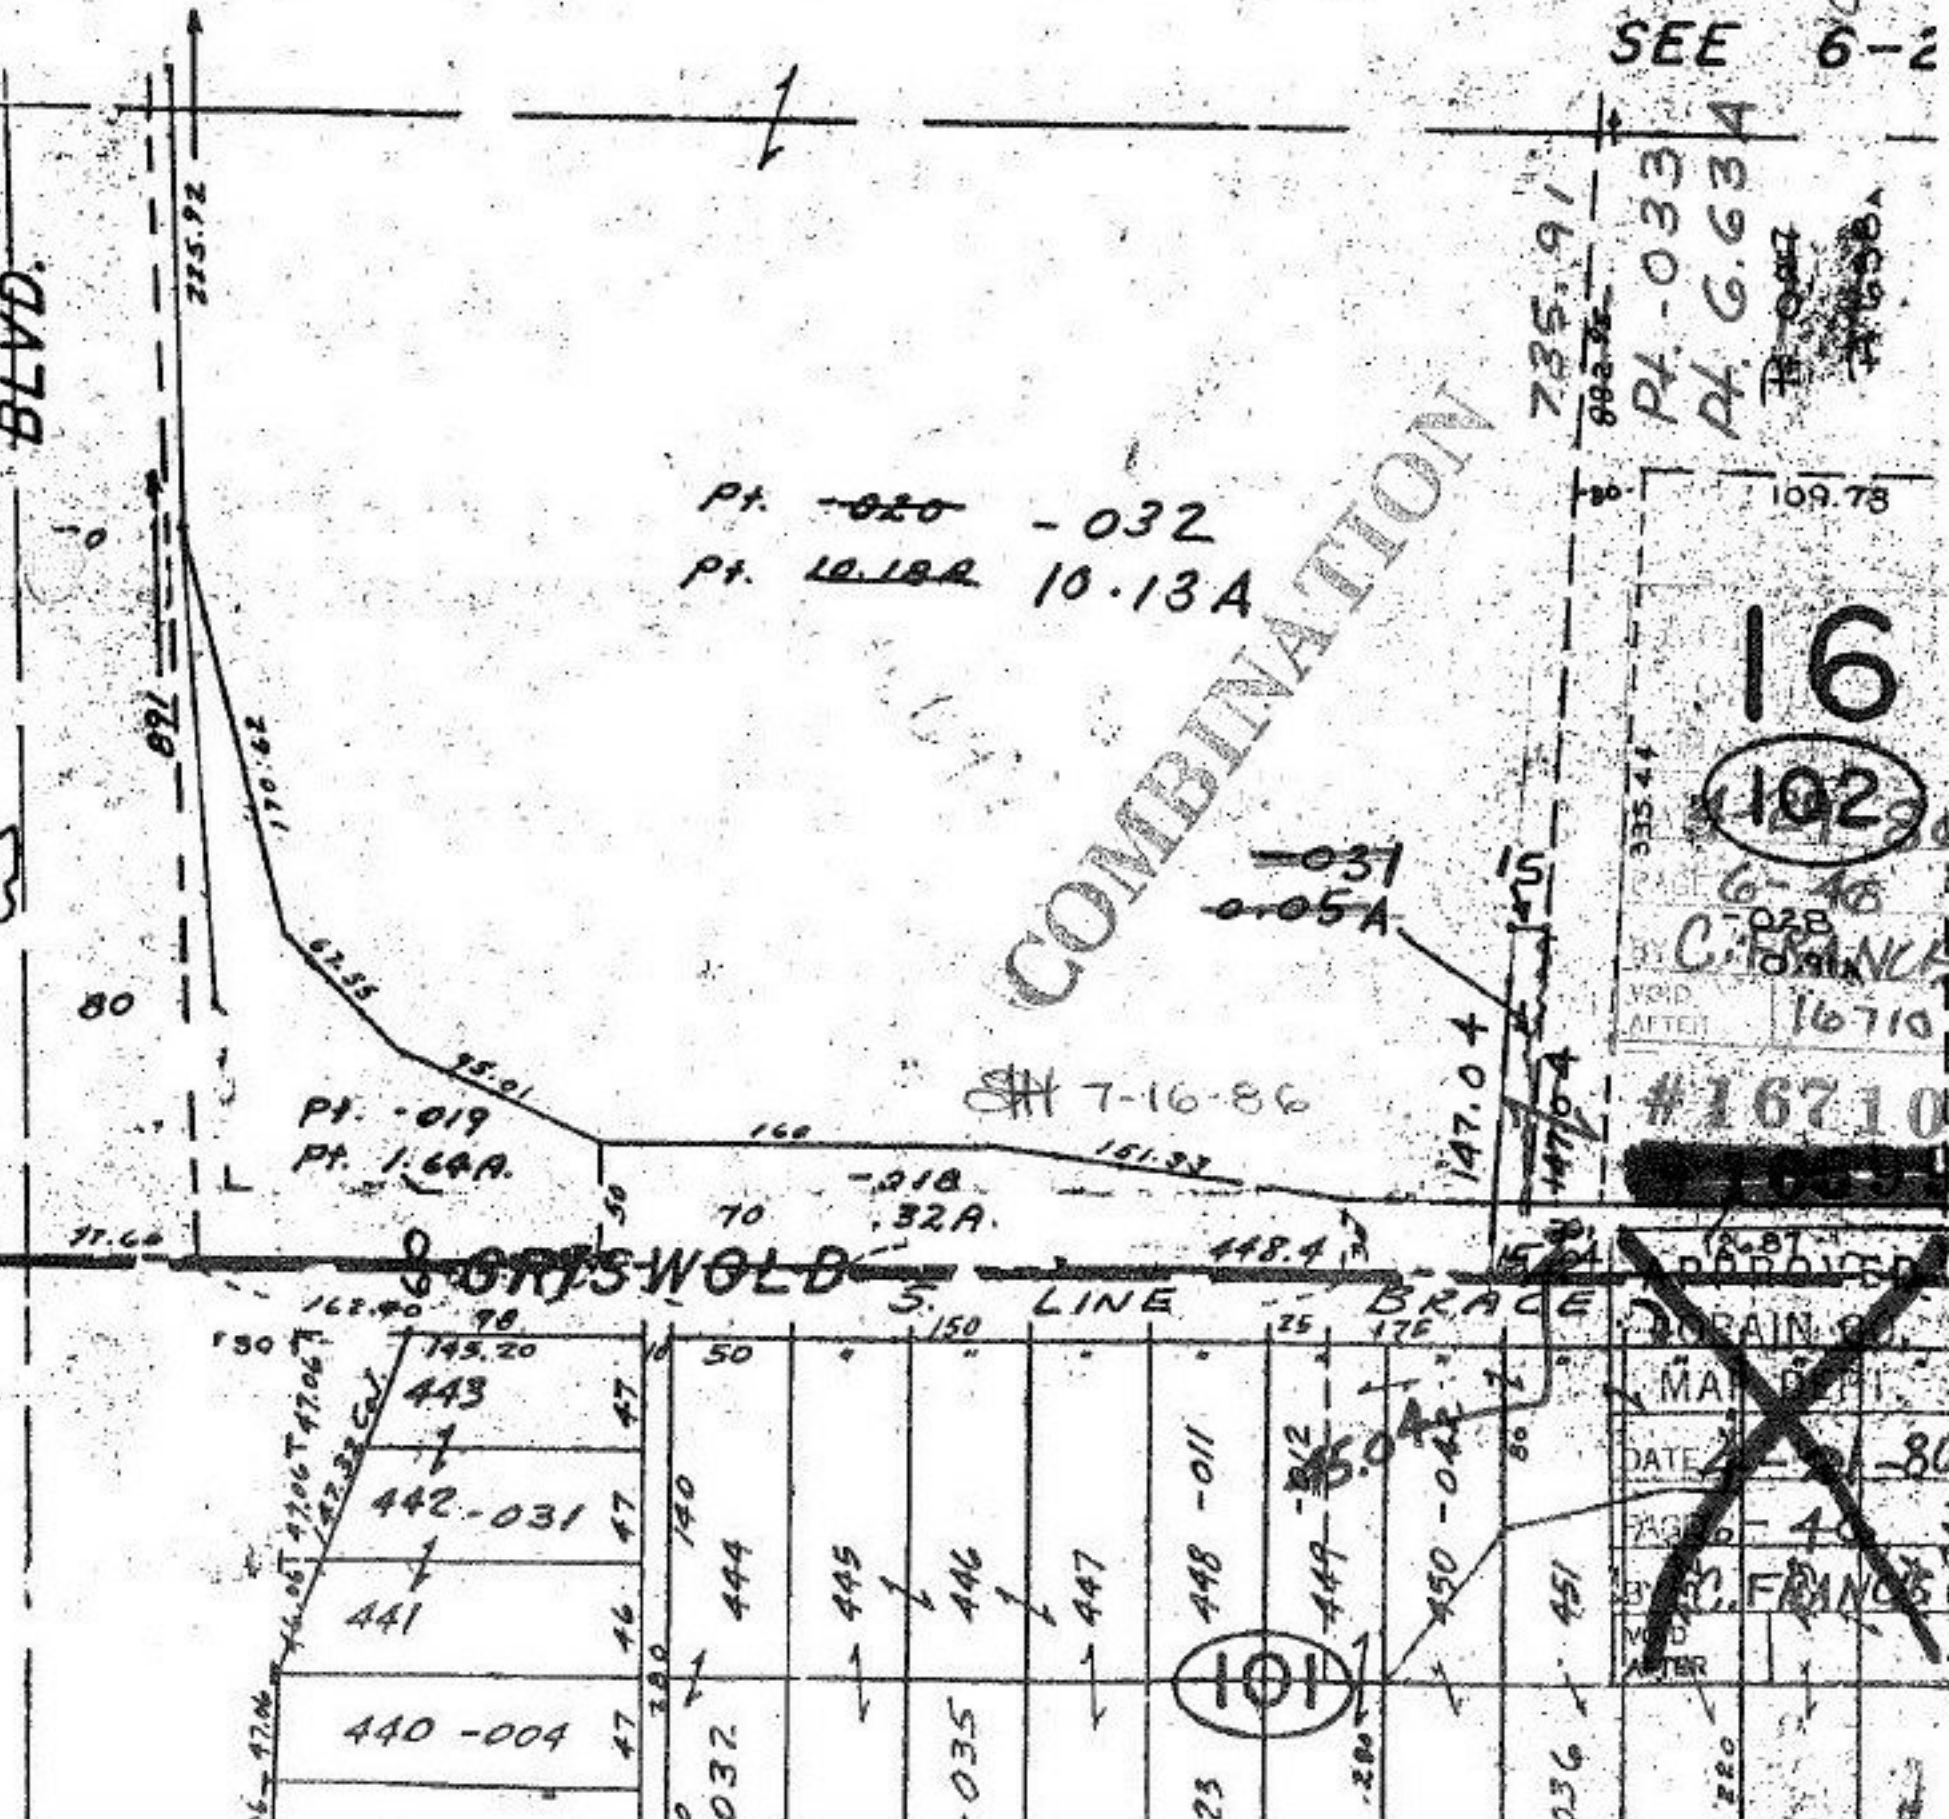

APPROVED
 M.A. FRANKS
 DATE 2-2-86
 PAGE 6-40
 BY M. FRANKS
 VOID AFTER