


102

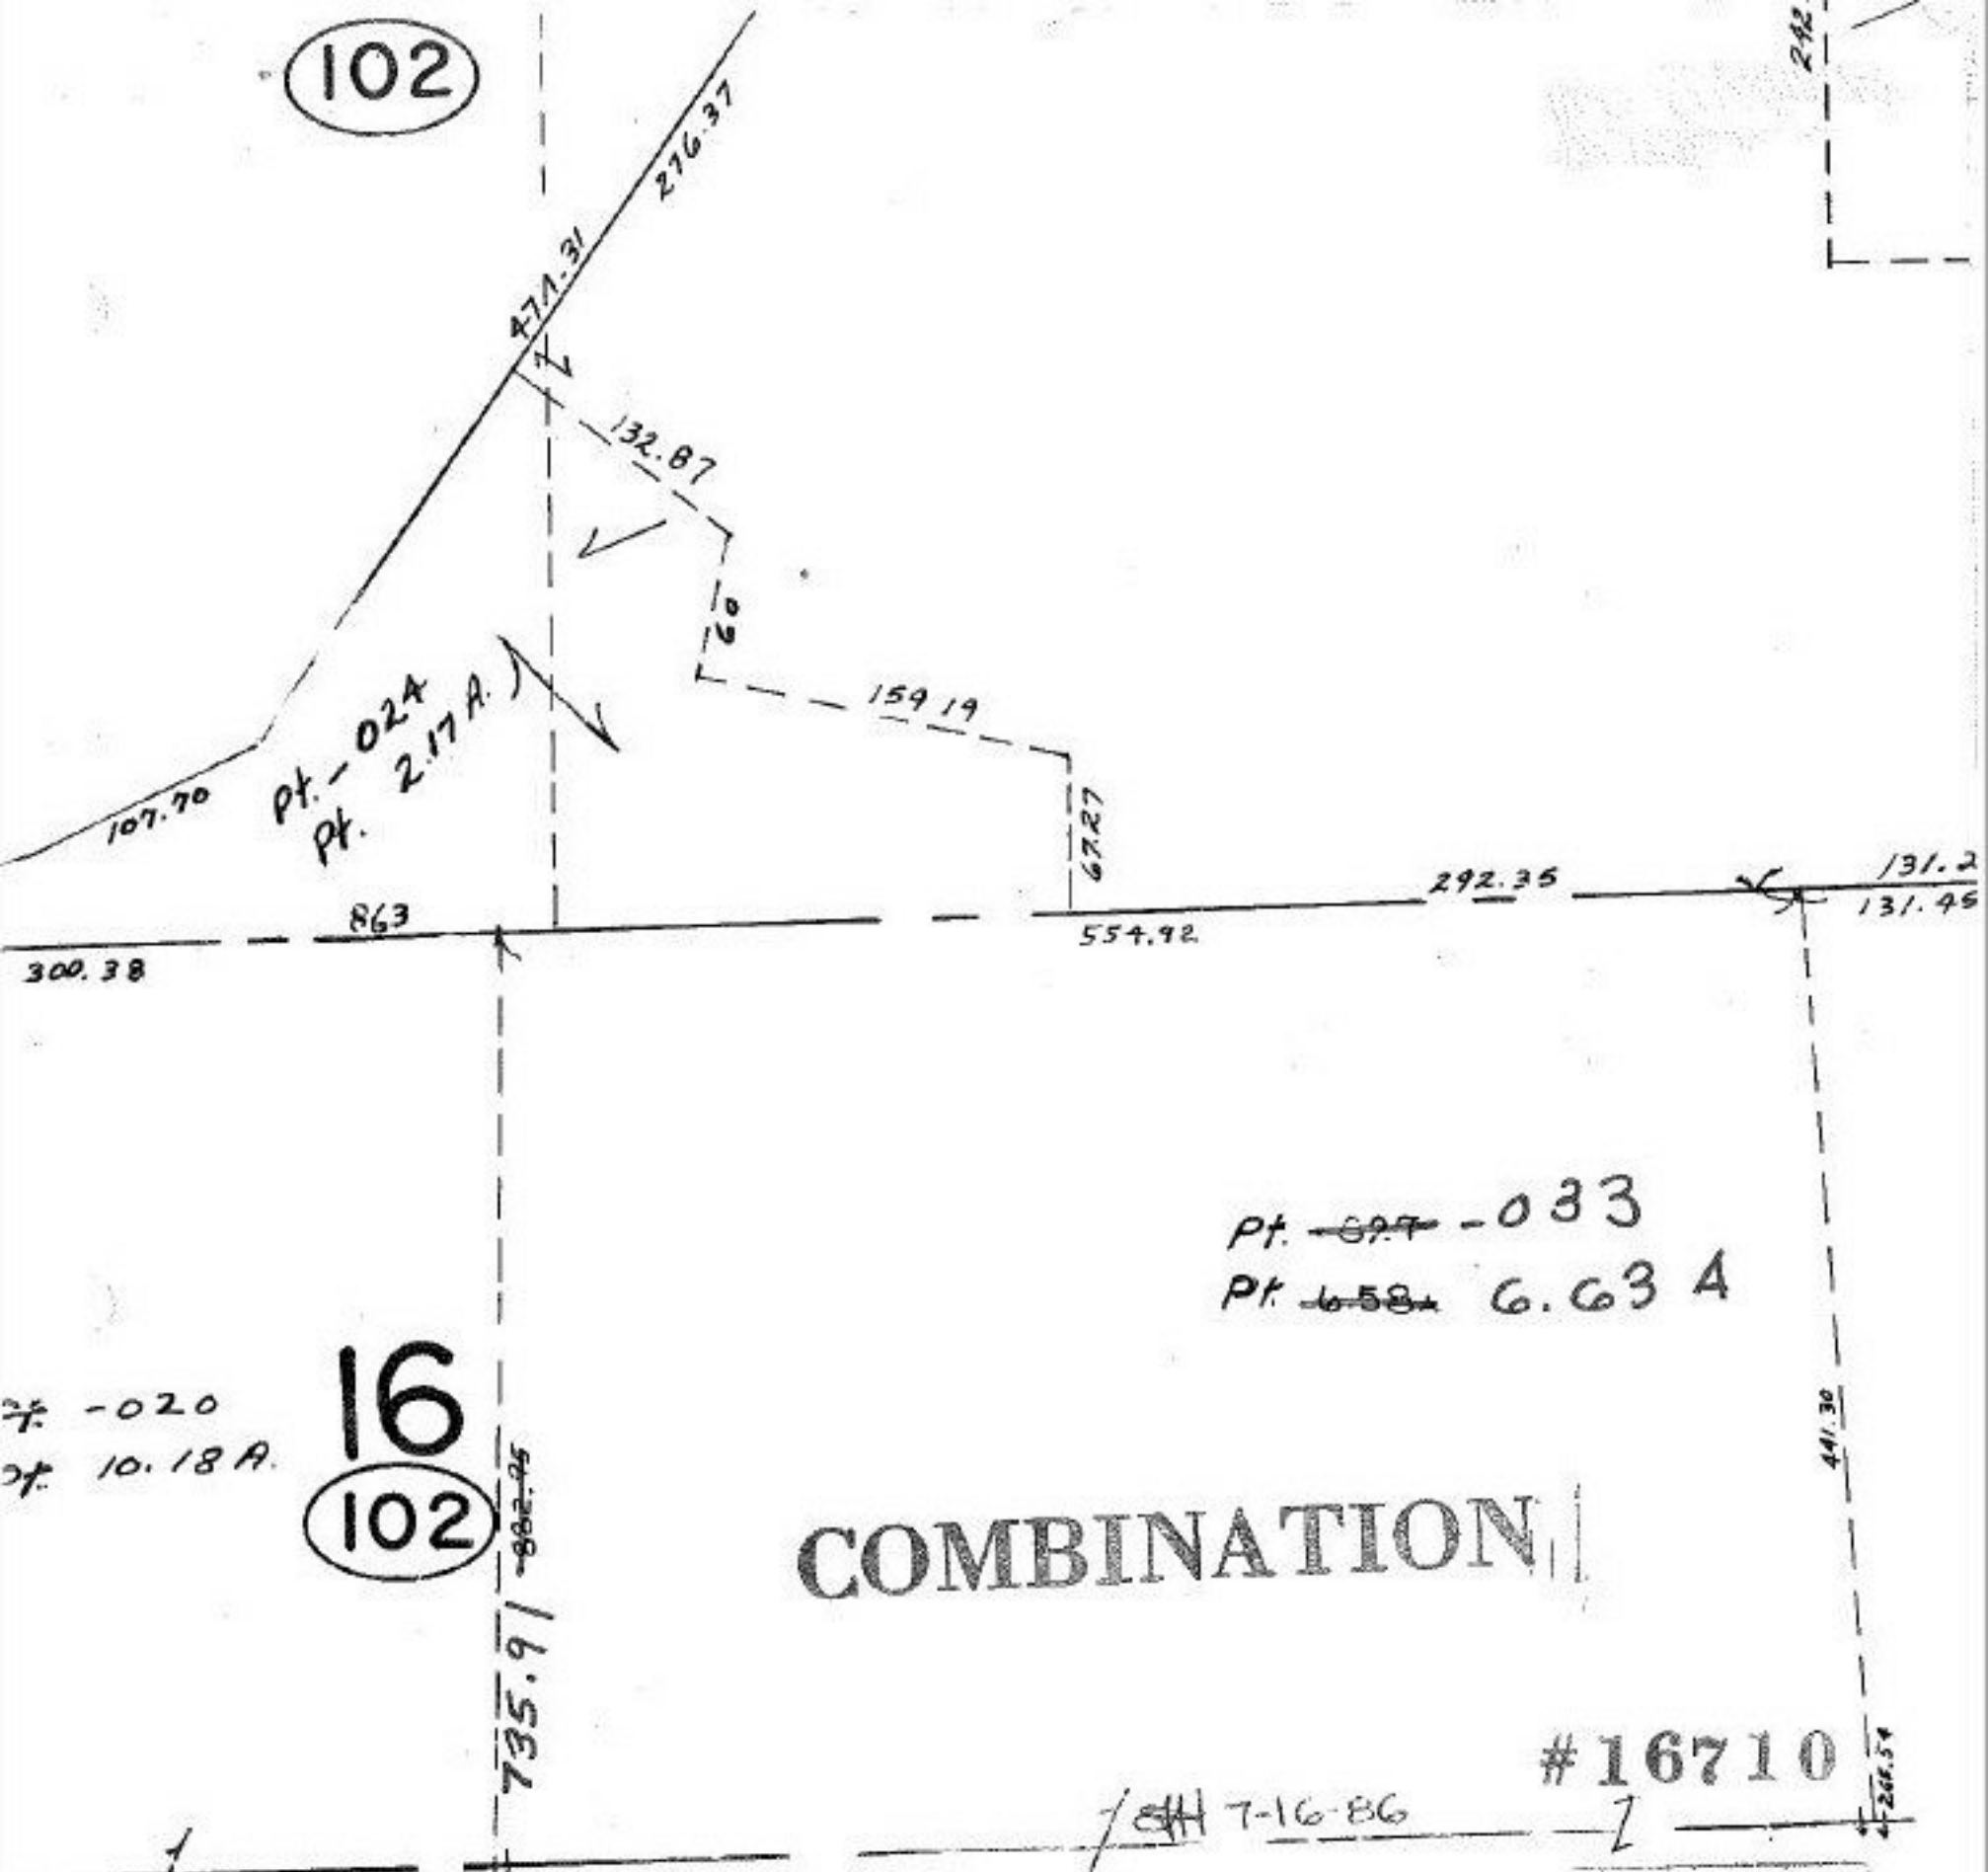

16  
102

COMBINATION

Pt. -033  
Pt. 6.58 6.63 A

# 16710

7-16-86

SEE 6-46

APPROVED	
LORAIN CO.	
MAP DEPT.	
DATE	4-29-86
PAGE	6-28
BY	C. FRANCIS
VOID AFTER	16710

BRACE TRACT E-LY PT. LOTS 12 & 13  
E. CENTER PT. LOT 15 CENTER PT. LOT 16