



Subdivision Line
 - SOLID -
 IN LARGEMENT
 1" = 50'

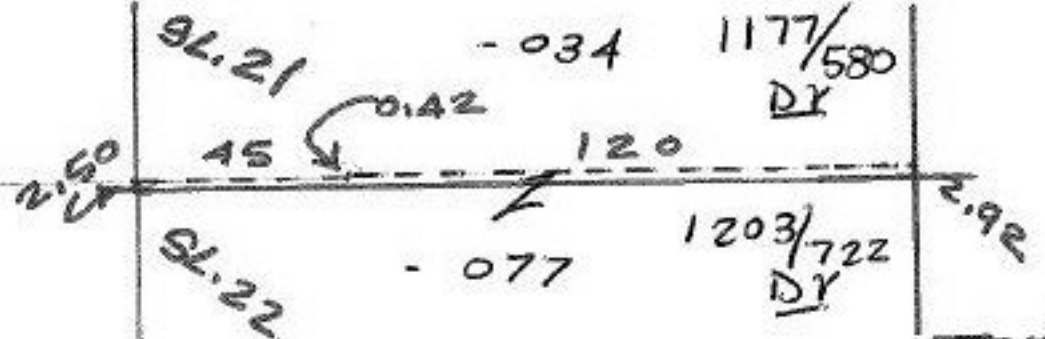

027-B

58

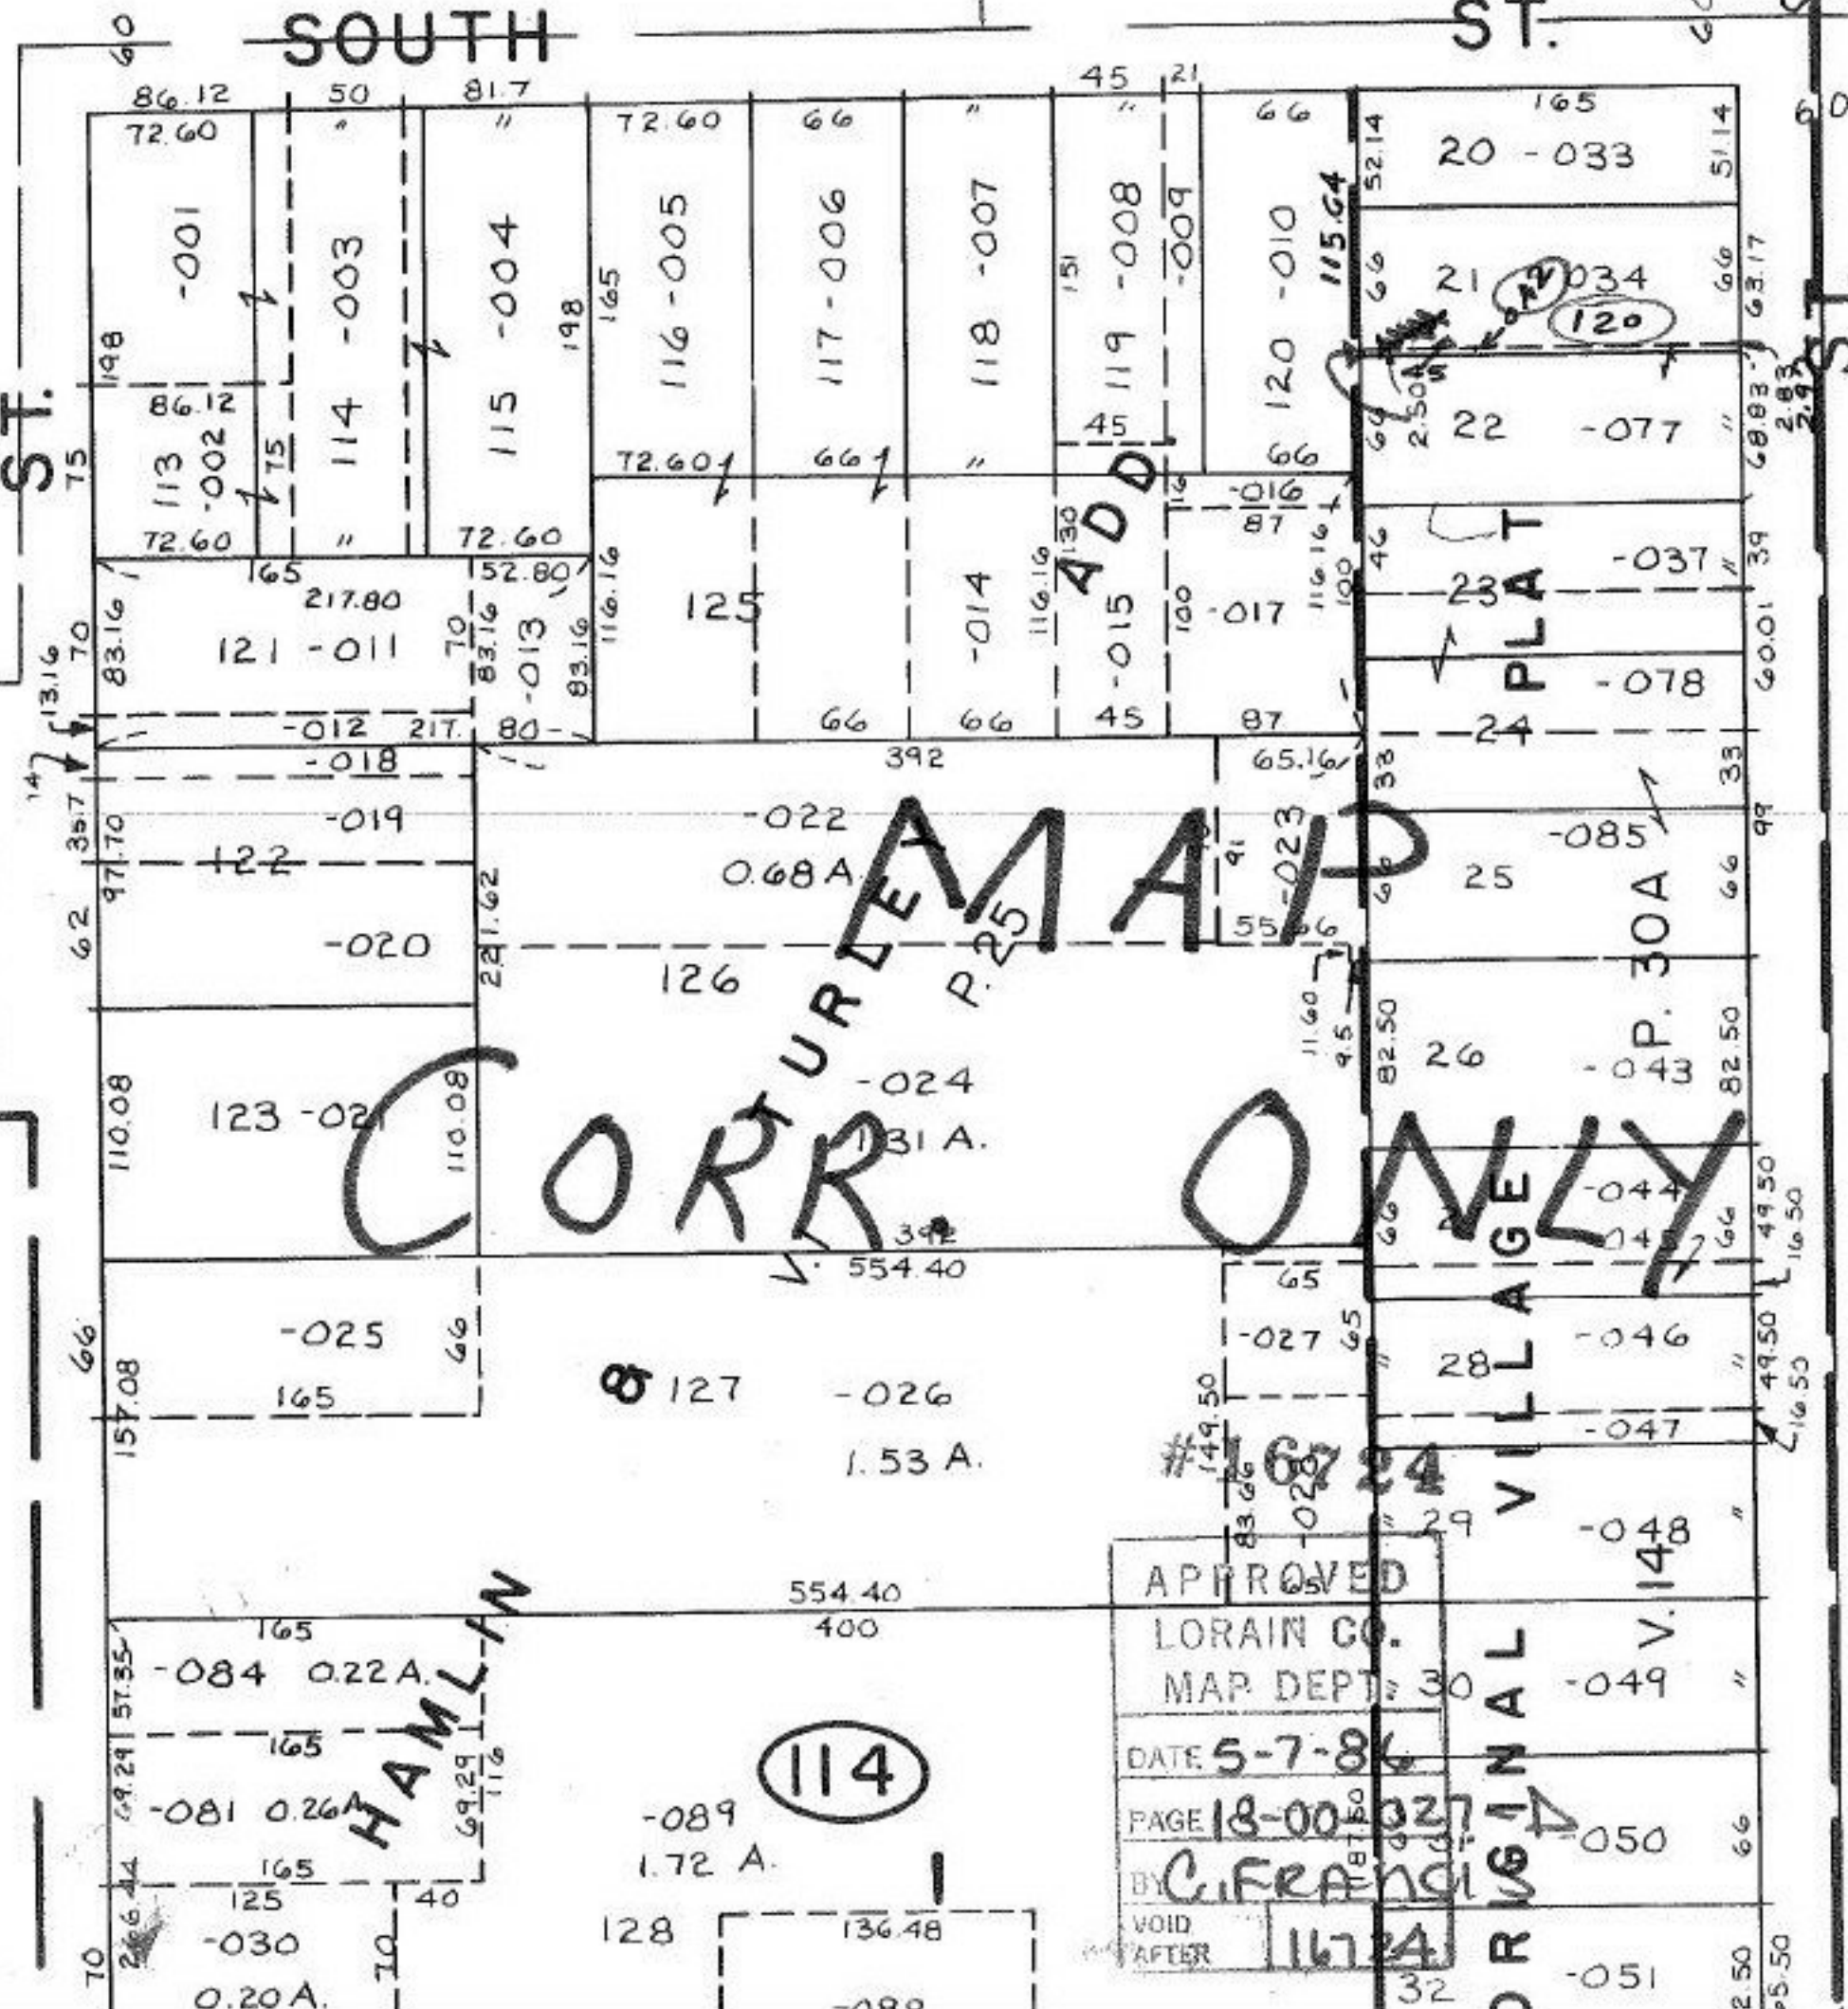

CORRUPTED MAP
ORIGINAL VILLAGE

APPROVED	
LORAIN CO.	
MAP DEPT.	30
DATE	5-7-86
PAGE	18-00-027
BY	C. FRANCIS
VOID AFTER	1674

114

HAMLIN