


SEE 12-00-043

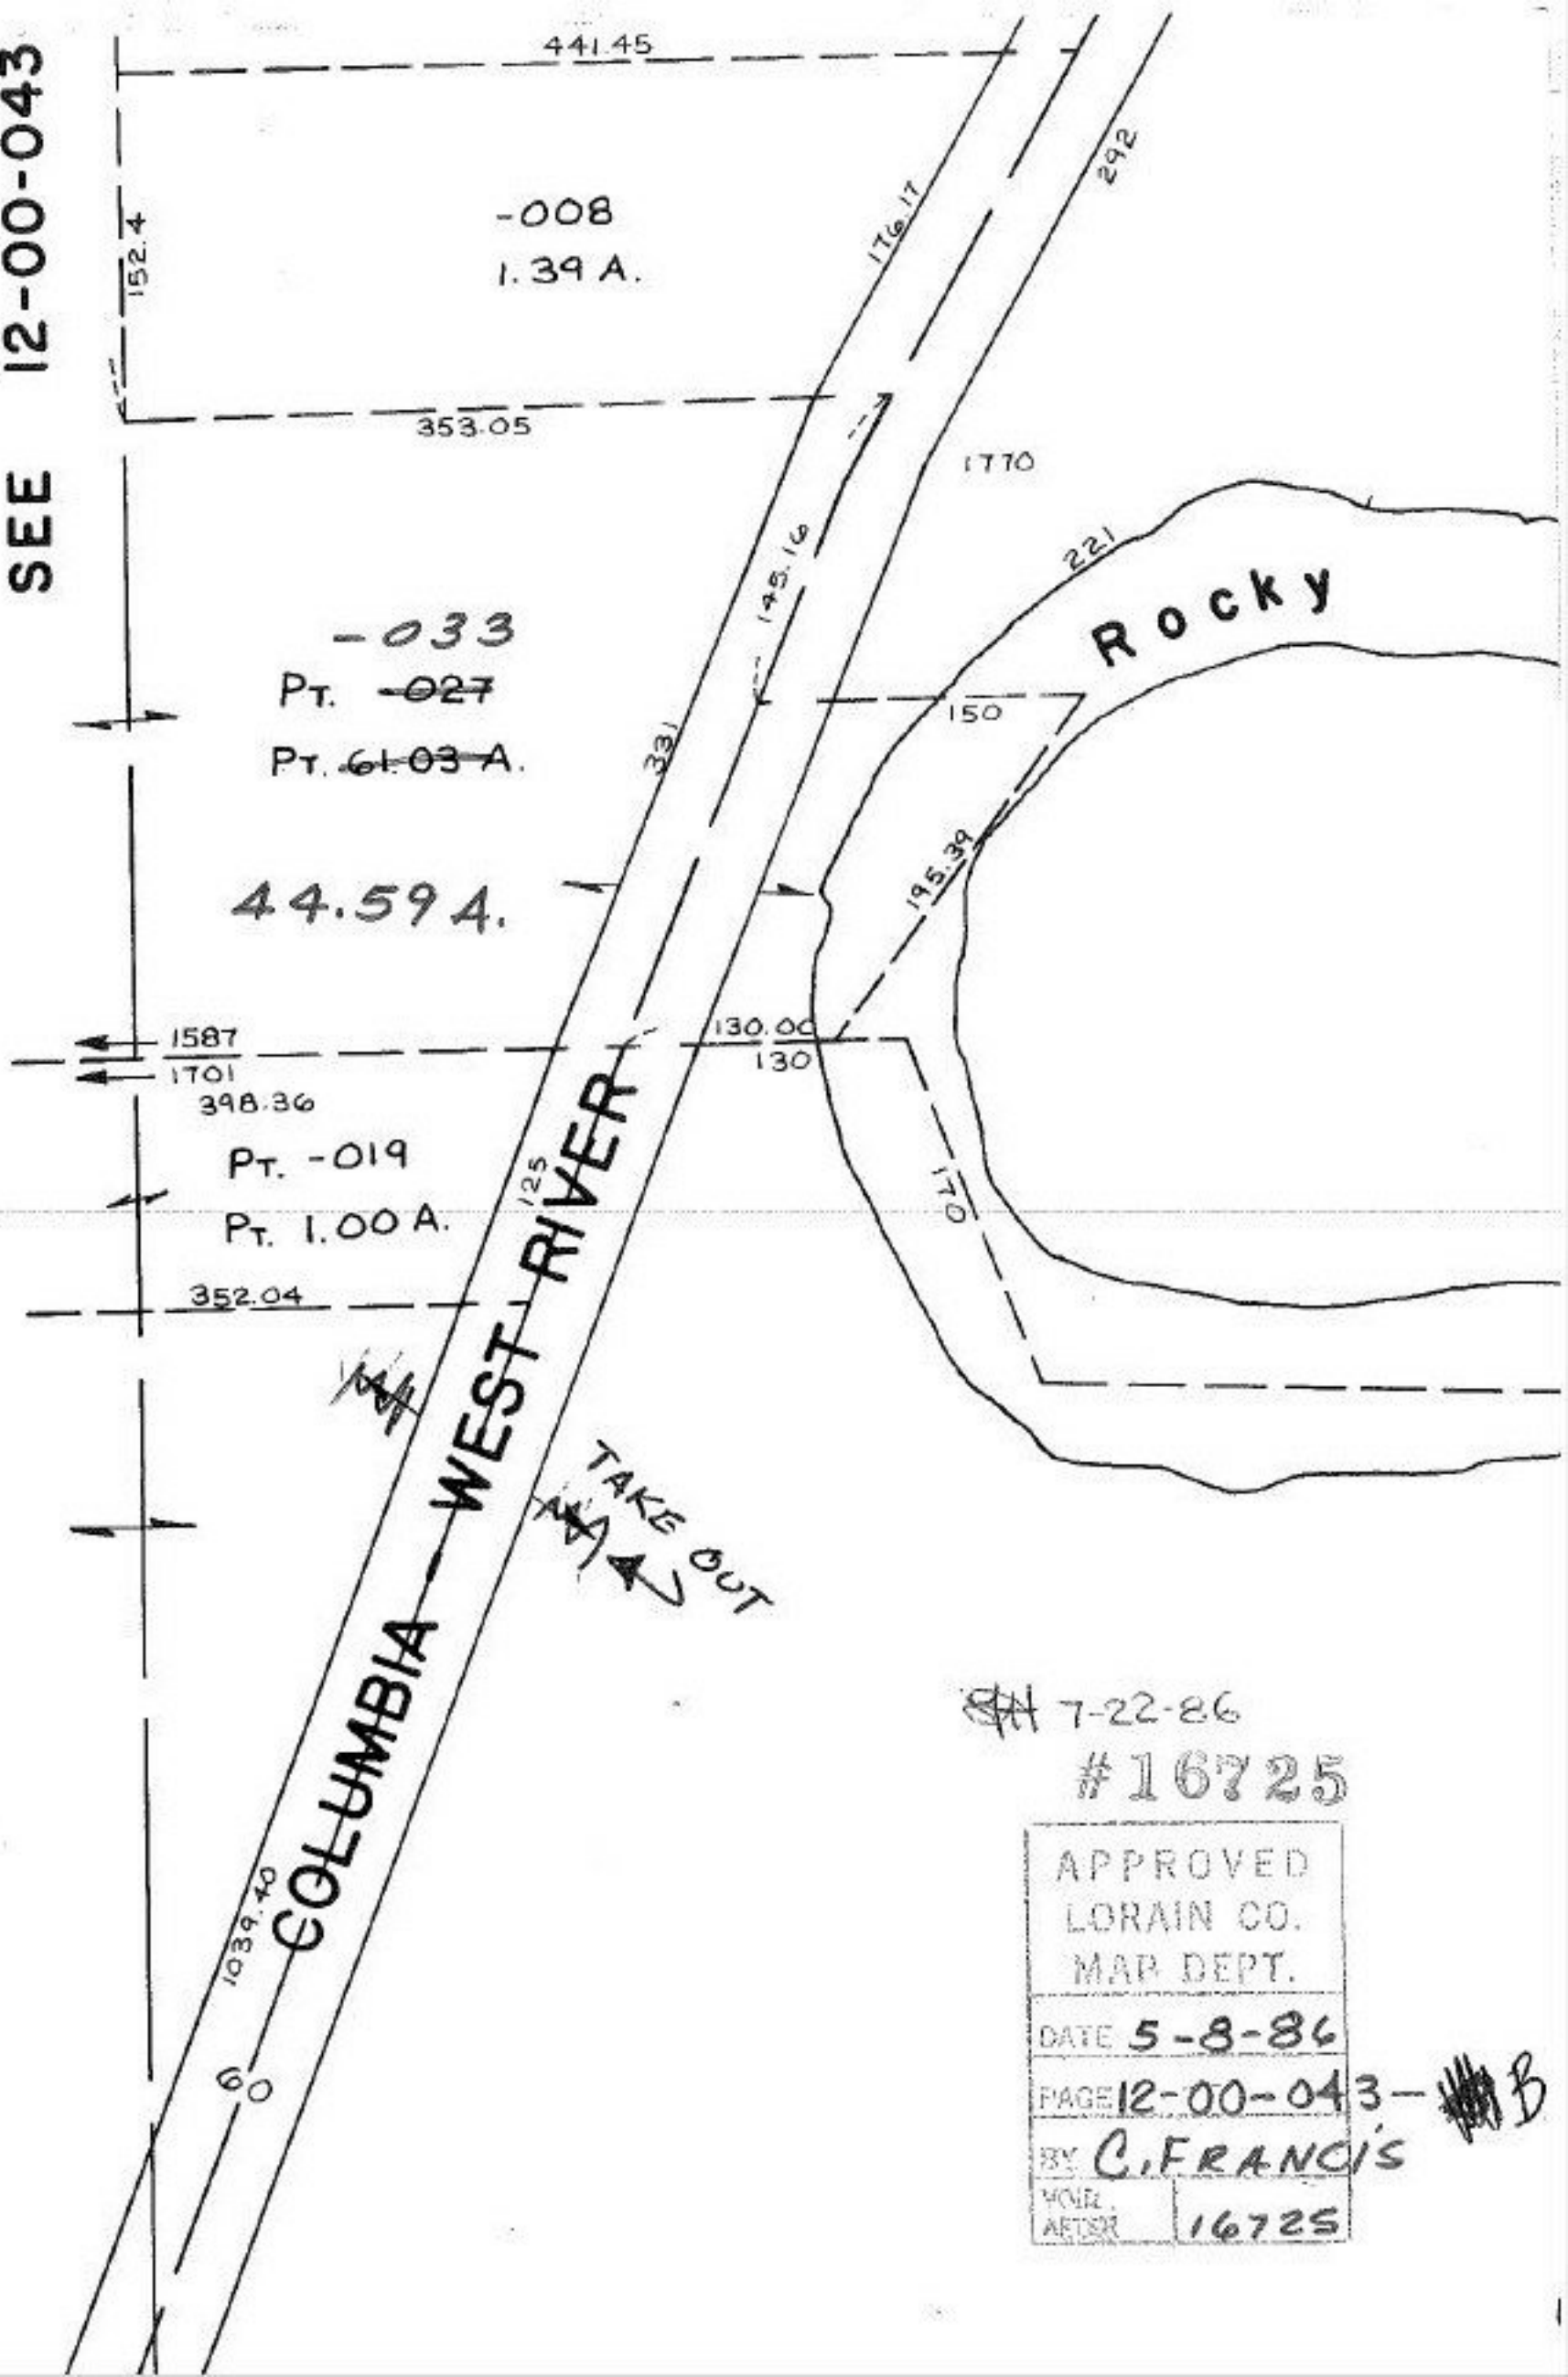

7-22-86

#16725

APPROVED
LORAIN CO.
MAP DEPT.

DATE 5-8-86

PAGE 12-00-043-

BY C. FRANCIS

YOUR
ACTOR 16725

~~1111~~ B