


45 Ac

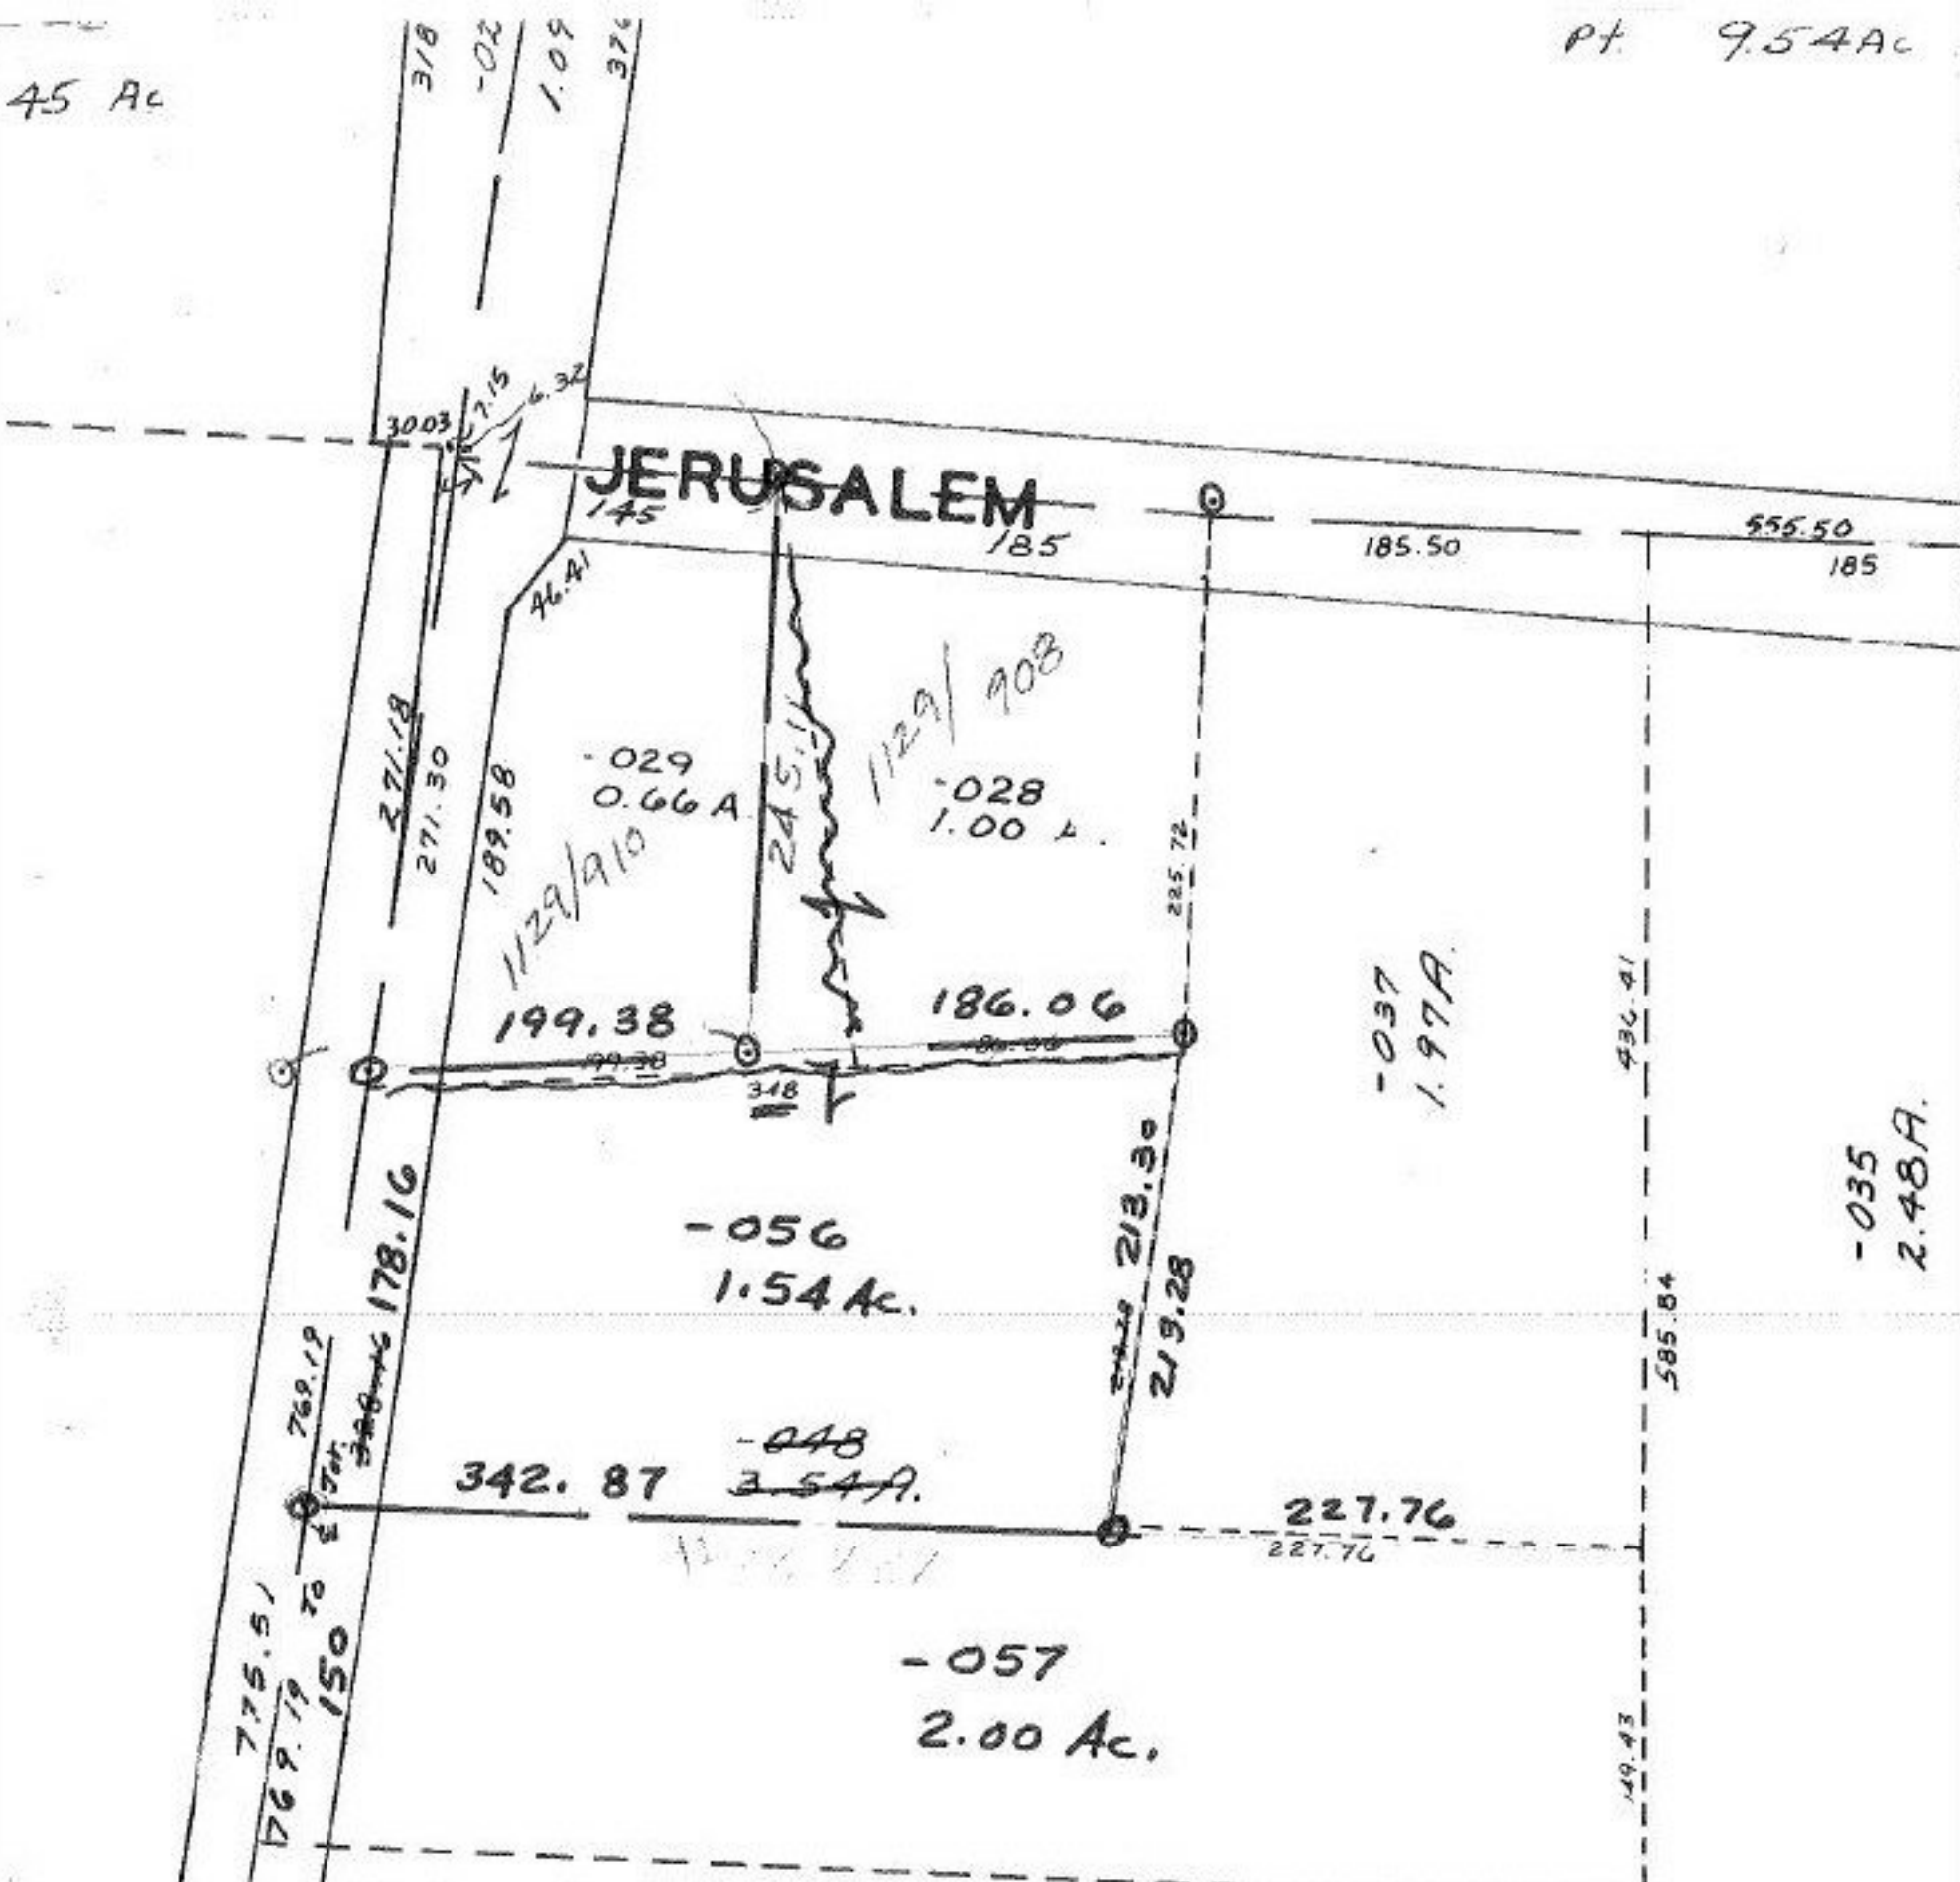

Prior Deed 1249/565
 Surveyed By: ARNOLD Koepf, Reg. Surveyor #16727
 C=1:90909. 2.70 A.

APPROVED	
LORAIN CO.	
MAP DEPT.	
DATE	5-29-86
PAGE	1-00-031-B
BY	C. FRANCIS
VOID AFTER	16727

7-14-86

-041
3.15 A.