

11-25-87

Ob-

4123.0 1848.55

-006
49.34 A.


3768.17

19

-005
1.00 A
504.22 C1
503.20
505.20

371.96
-007
8
566.48
312.34

-008
153.97 A.

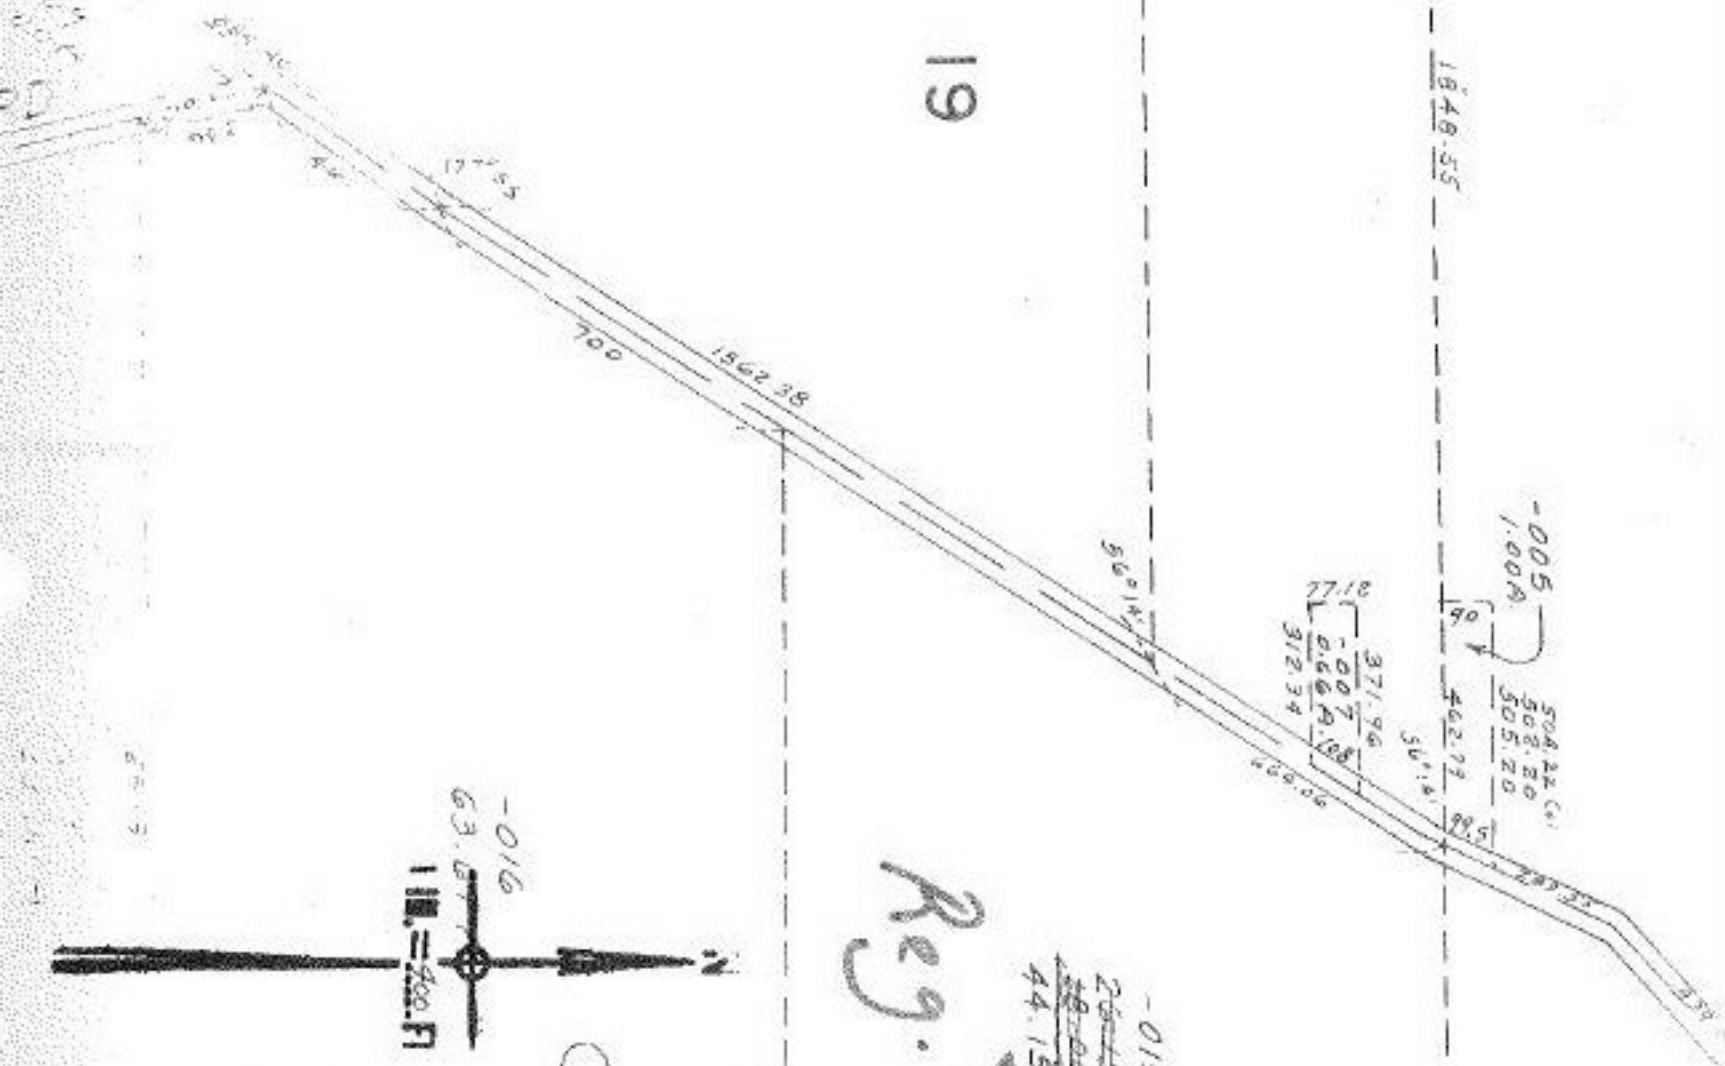

Reg. 7

-015
2615 A Dup #1
~~48-02 A~~
44.15 A - ~~Start~~

-016
63.87
1 in. = 200 ft

1674

APPROVED
LORAIN CO.
MAP DEPT.

DATE 4-18-68

10-F

BY
H. C. ...

DONE - 6/12/18
1954

-004
20.67 A.

W. K. ...