

1086.03 ~~1409.43~~

323.40

PRIOR DEED 1292/763
 Surveyed By Dane A Hoponek
~~16.94 A.~~ 16/11 C=1:1000000.000

-034 ~~-071~~
 10.95 Ac.

-085
 6.00 Ac
 5.99 Ac.

#16763
 11-00-077-A

1086.03
 1306.48

AC. CORR. PER SURVEY BY:
 DANE A. HOPONEK Reg.
 C=1:1000000.000 Surveyor

232.42

10/21/86
 #16763

APPROVED
 LORAIN CO.
 MAP DEPT.
 DATE 6-4-86
 PAGE 11-00-077-A
 BY C. FRANCIS
 VOID AFTER 16763


-073
 11.13 A.

8-29-86

266

10

180.67

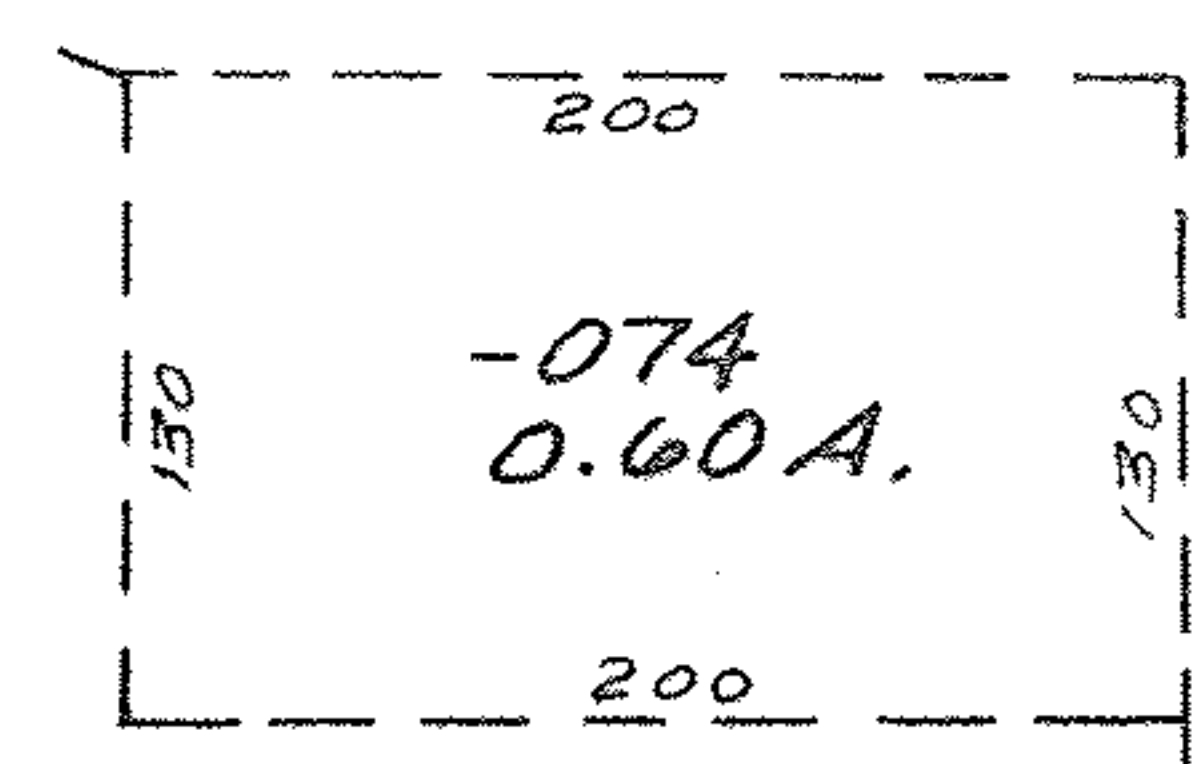

-079
 9.38 A.

-078
 4.35 A.

-076
 4.00 A.

1603.20

180

423.46

170.

187.39

99

76

97

17

97

11

80

11

80

103

103

73.93

96.93

73.93

96.93

73.93

80

80

80

80

200
 -041
 .37A.

200
 -037
 .41A.

200
 380.04

200.05
 380.09

200
 -049
 .41A.

200
 -061
 .46 A.

200

200

200
 -082
 0.45 A.

200
 -083
 0.36 A.

200
 -083
 0.36 A.

200
 -045
 .34 A.

200
 -039
 .37A.

200

200

80
90
60
97
17
99
99
91
97
11
11
103
80
80
80
80

SEE II