

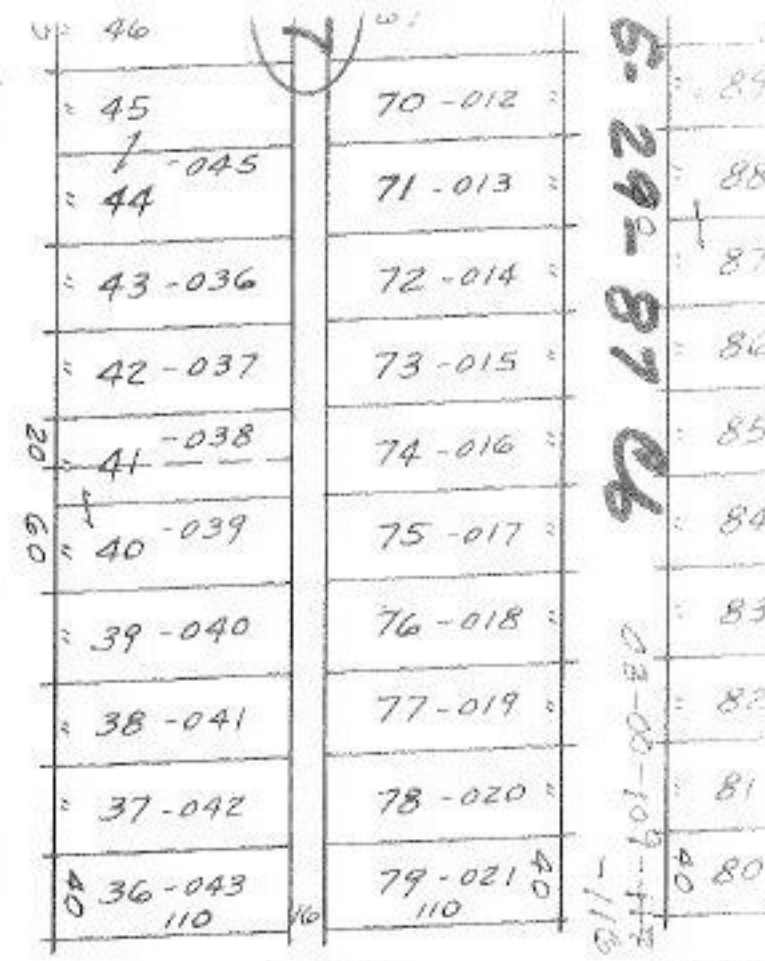


SEE 6-8

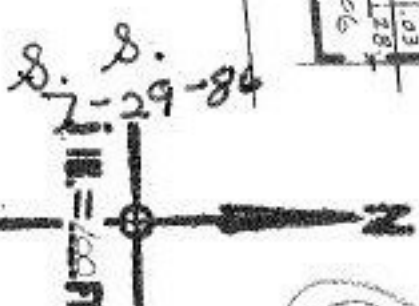

OAKWOOD

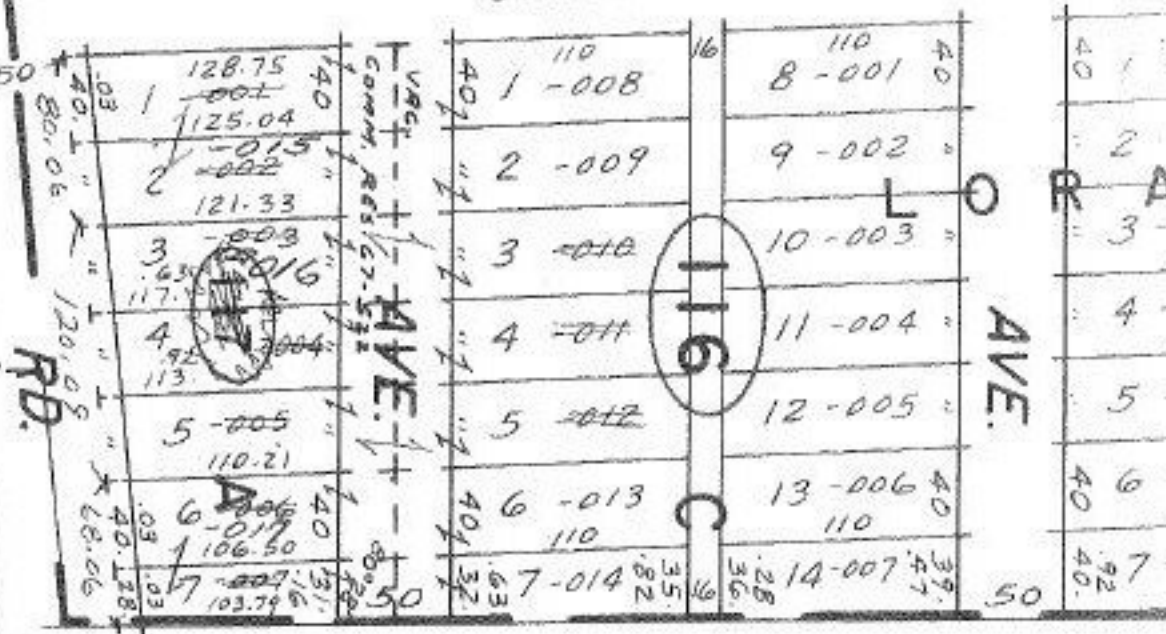

APPROVED  
LORAIN CO.  
MAP DEPT.  
DATE 4-18-68  
BY [Signature]

1677



Done 7-6-68 LWHall

5-29-87

03-08-109-112

1011