


11-25-87 *[Signature]*

009
000A

1001 570

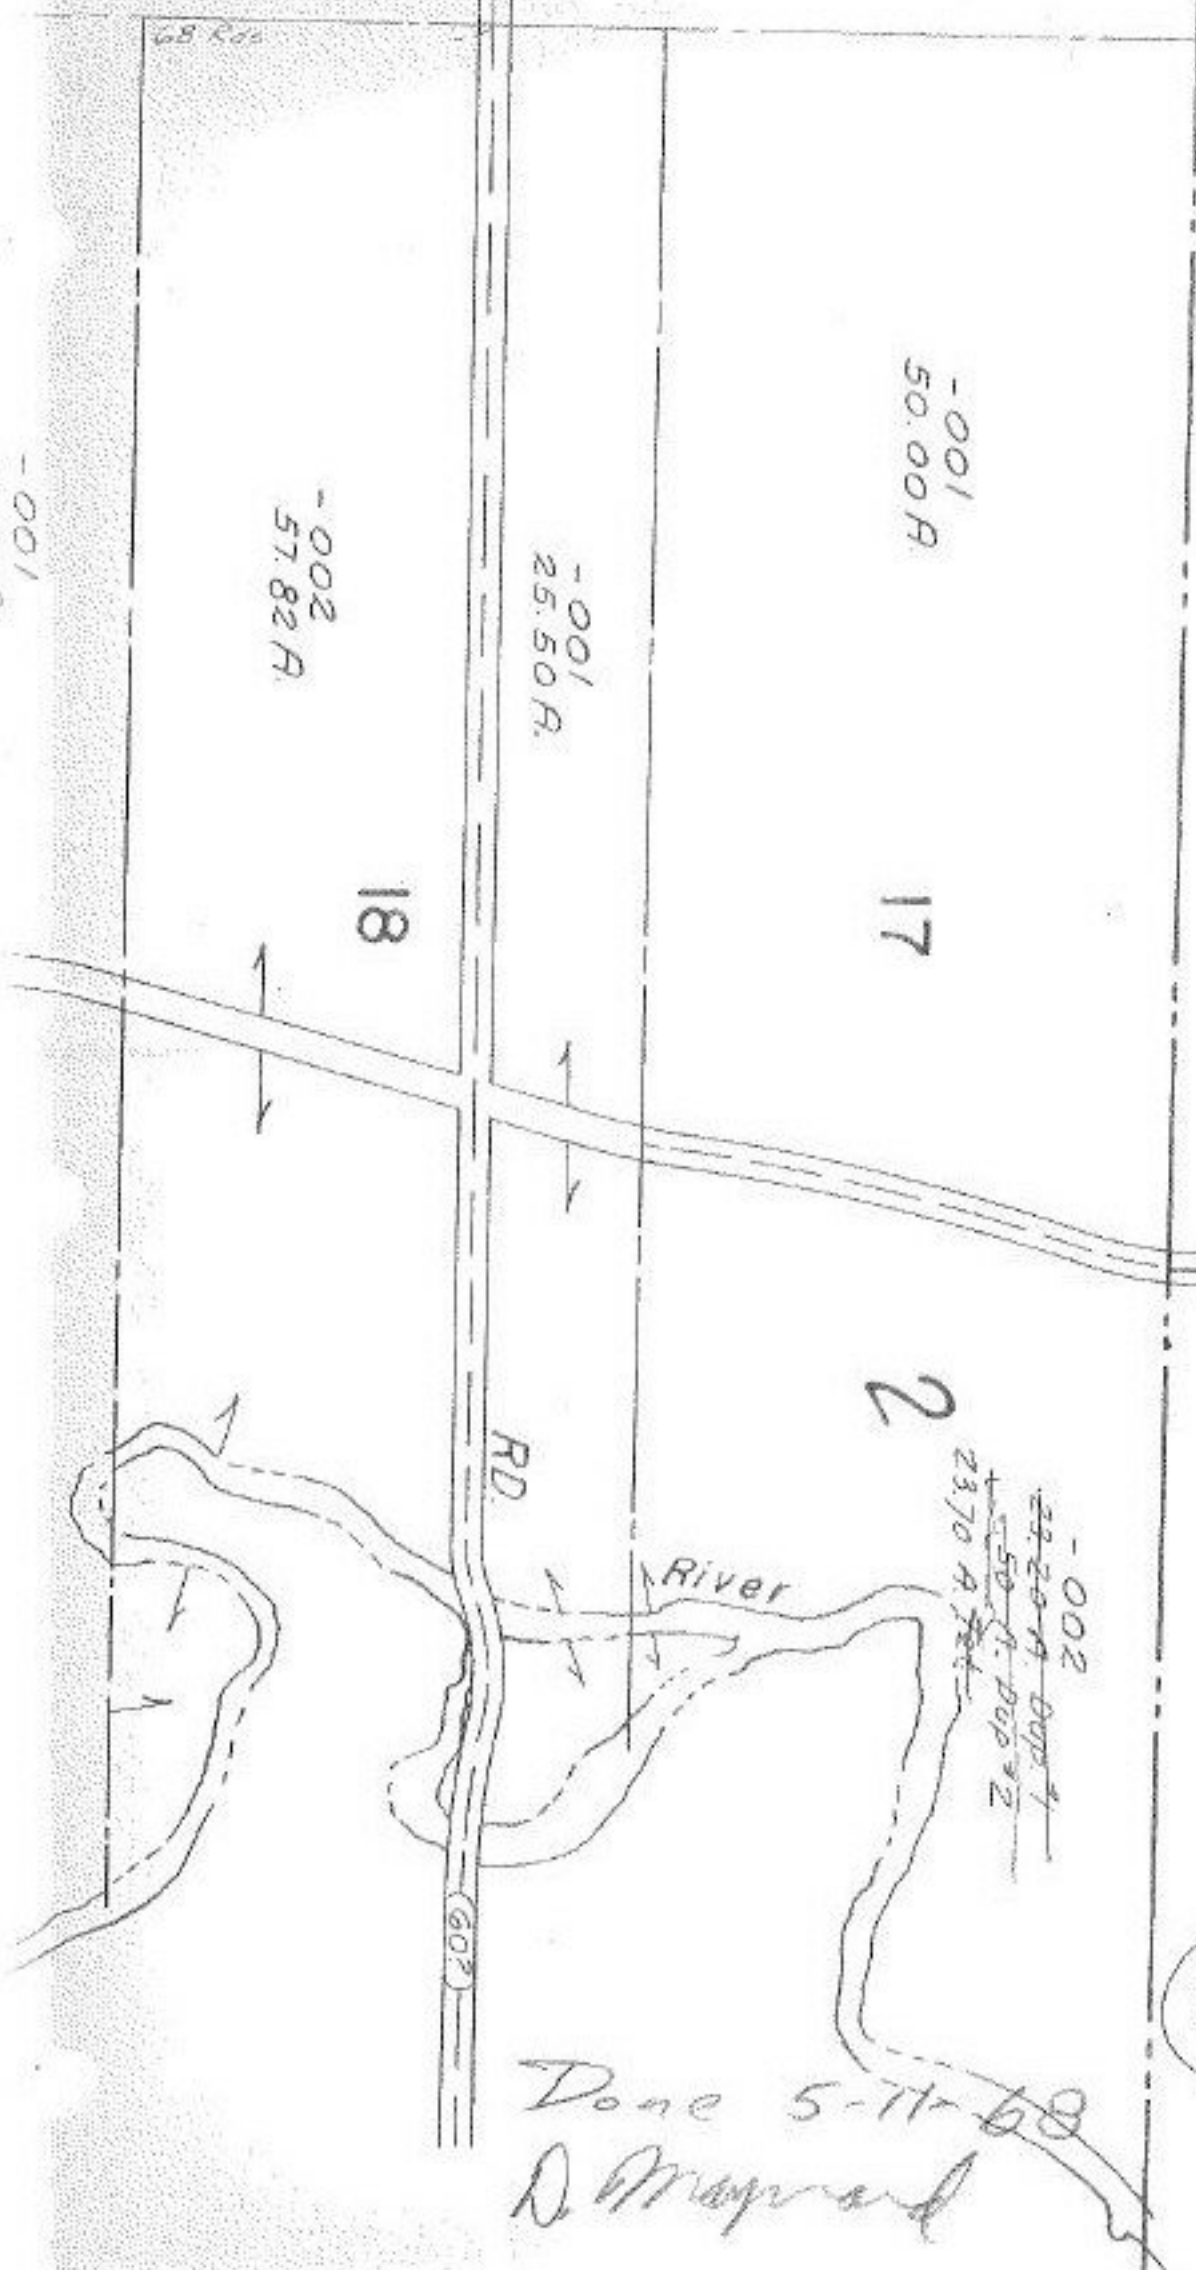

#1678
APPROVED
 LORAIN CO.
 MAP DEPT.
 DATE 4-17-68
 19-F
 BY *[Signature]*

[Signature]

N ↑

Done 5-11-68
D. Maynard