


WAKEMAN-LAGRANGE - RICHFIELD

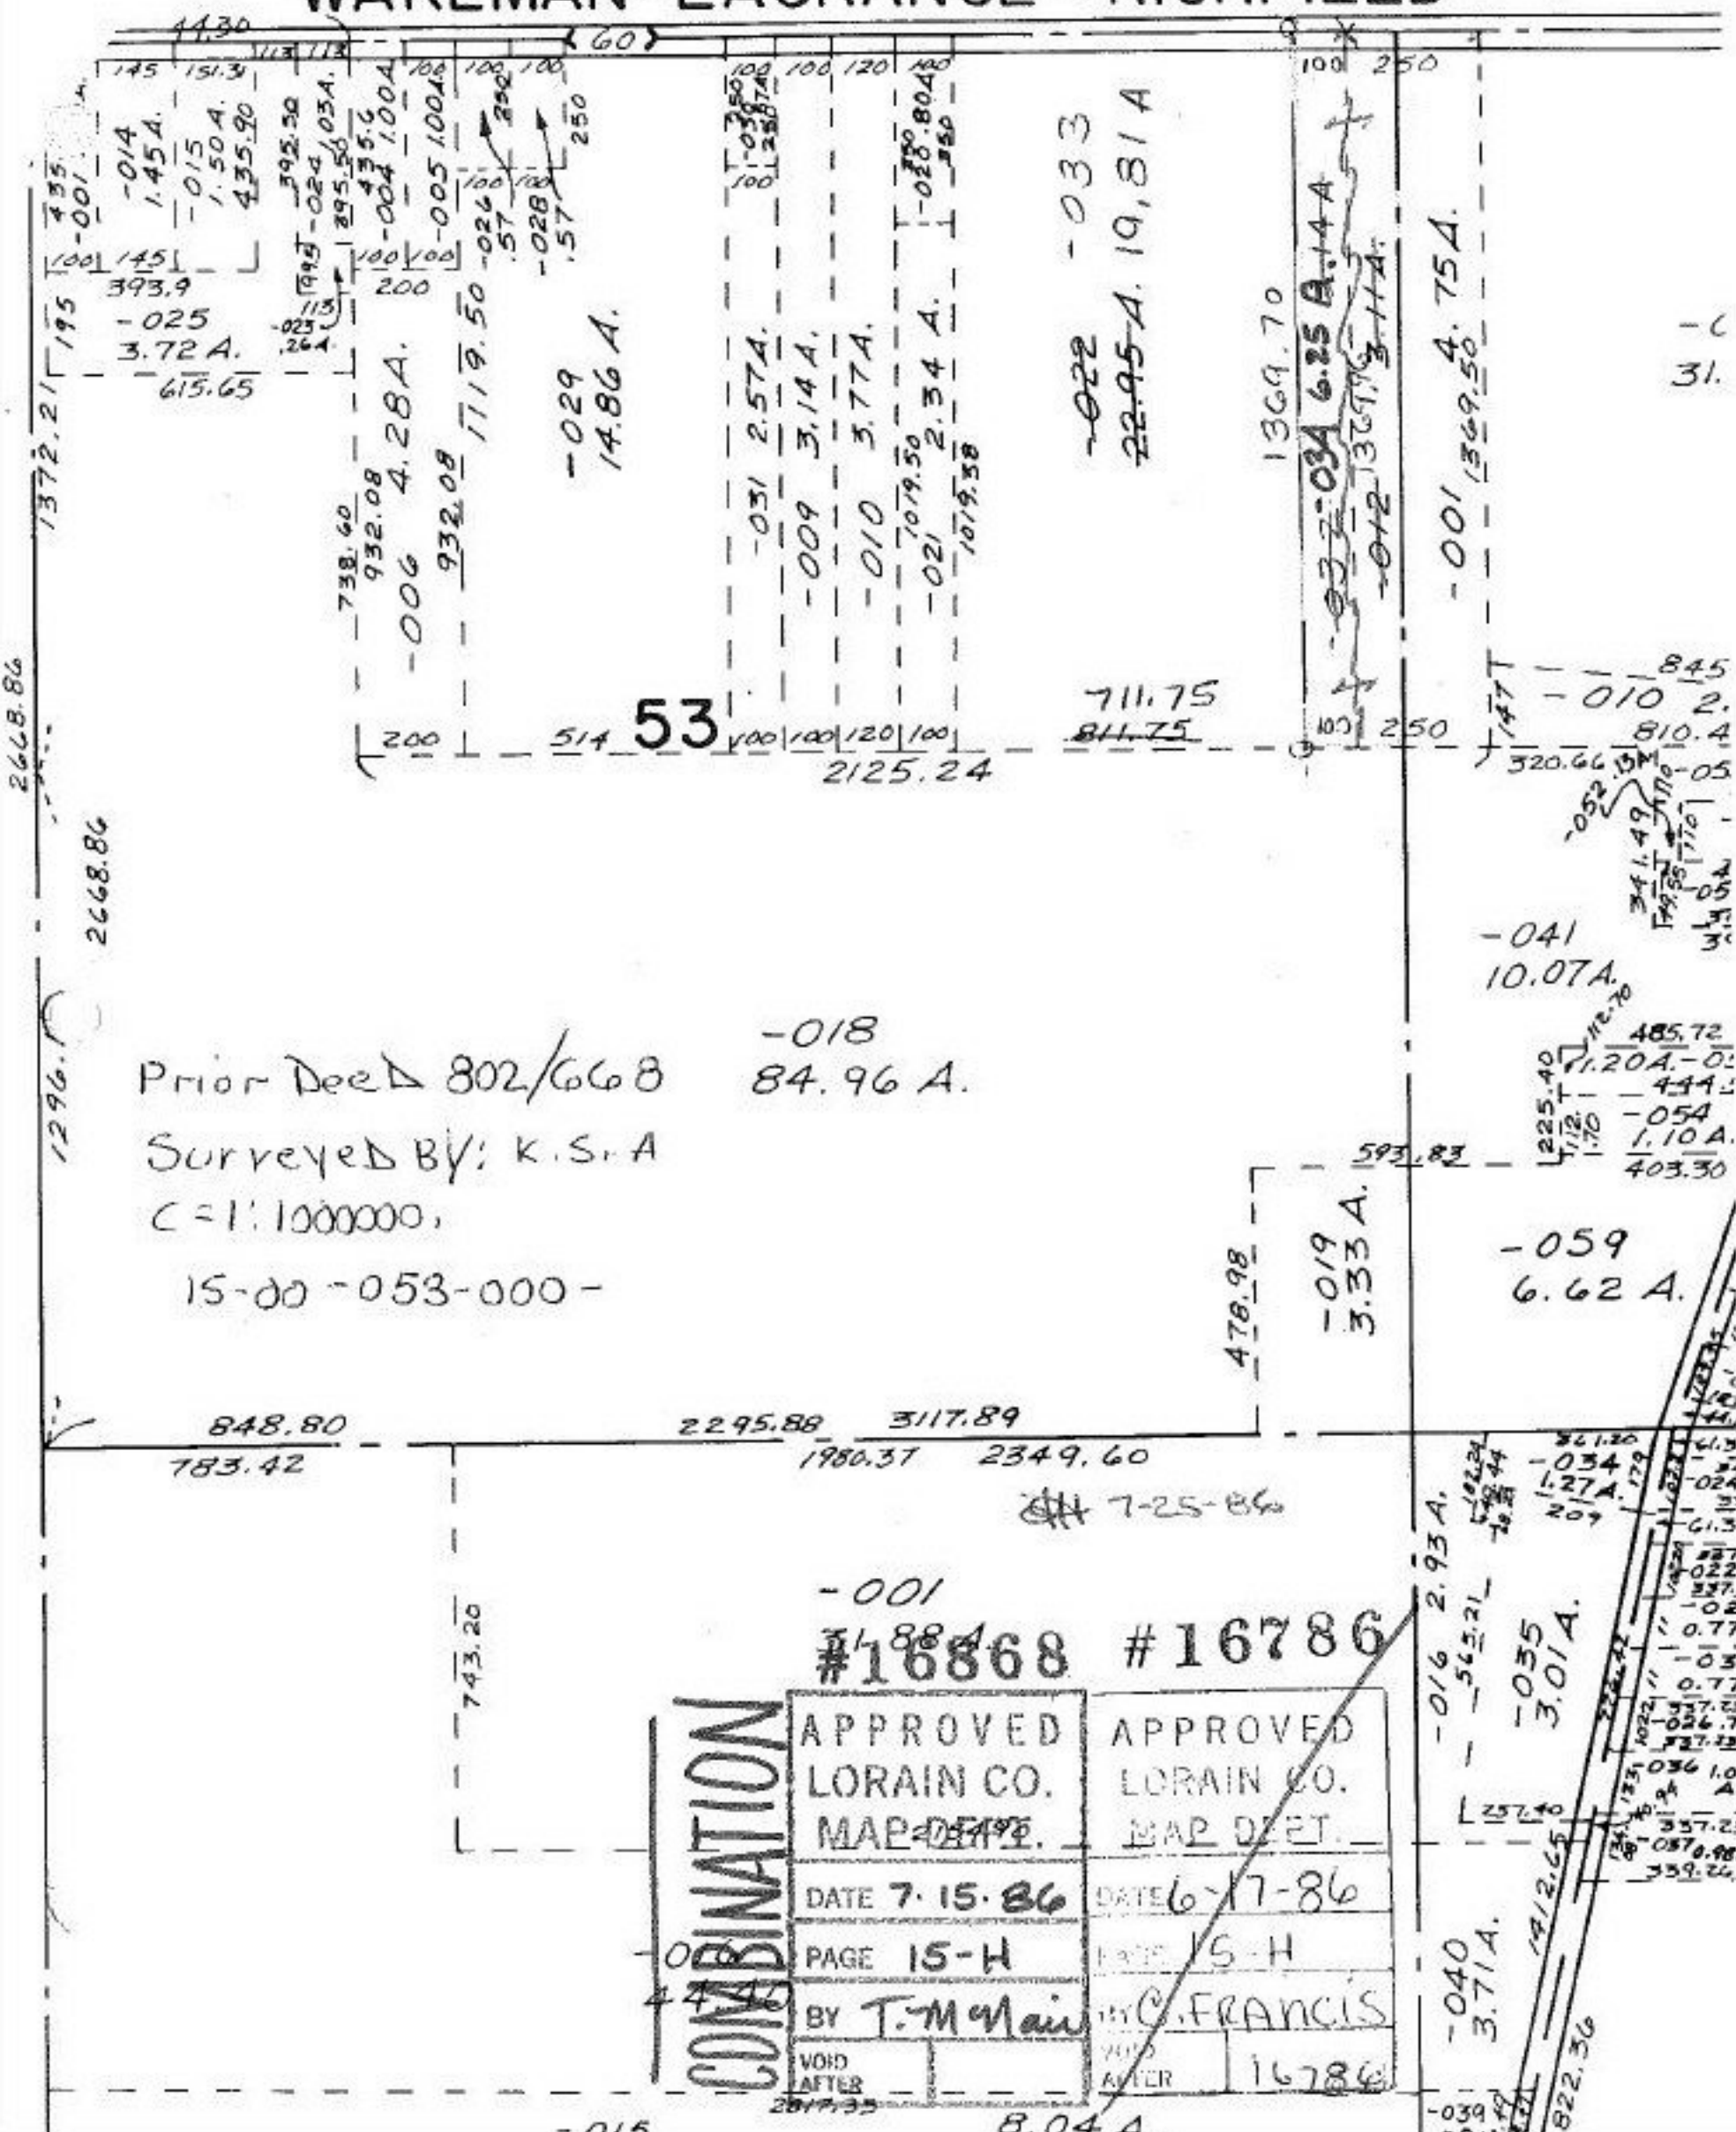

-018
 84.96 A.

-001
 #16868 #16786

COMBINATION	APPROVED LORAIN CO. MAP DEPT.	APPROVED LORAIN CO. MAP DEPT.
	DATE 7-15-86	DATE 6-17-86
	PAGE 15-H	PAGE 15-H
	BY T.M. Main	BY C. FRANCIS
	VOID AFTER 2017/33	VOID AFTER 16786

7-25-86

-015 8.04 A.