


-003
119.86 A.

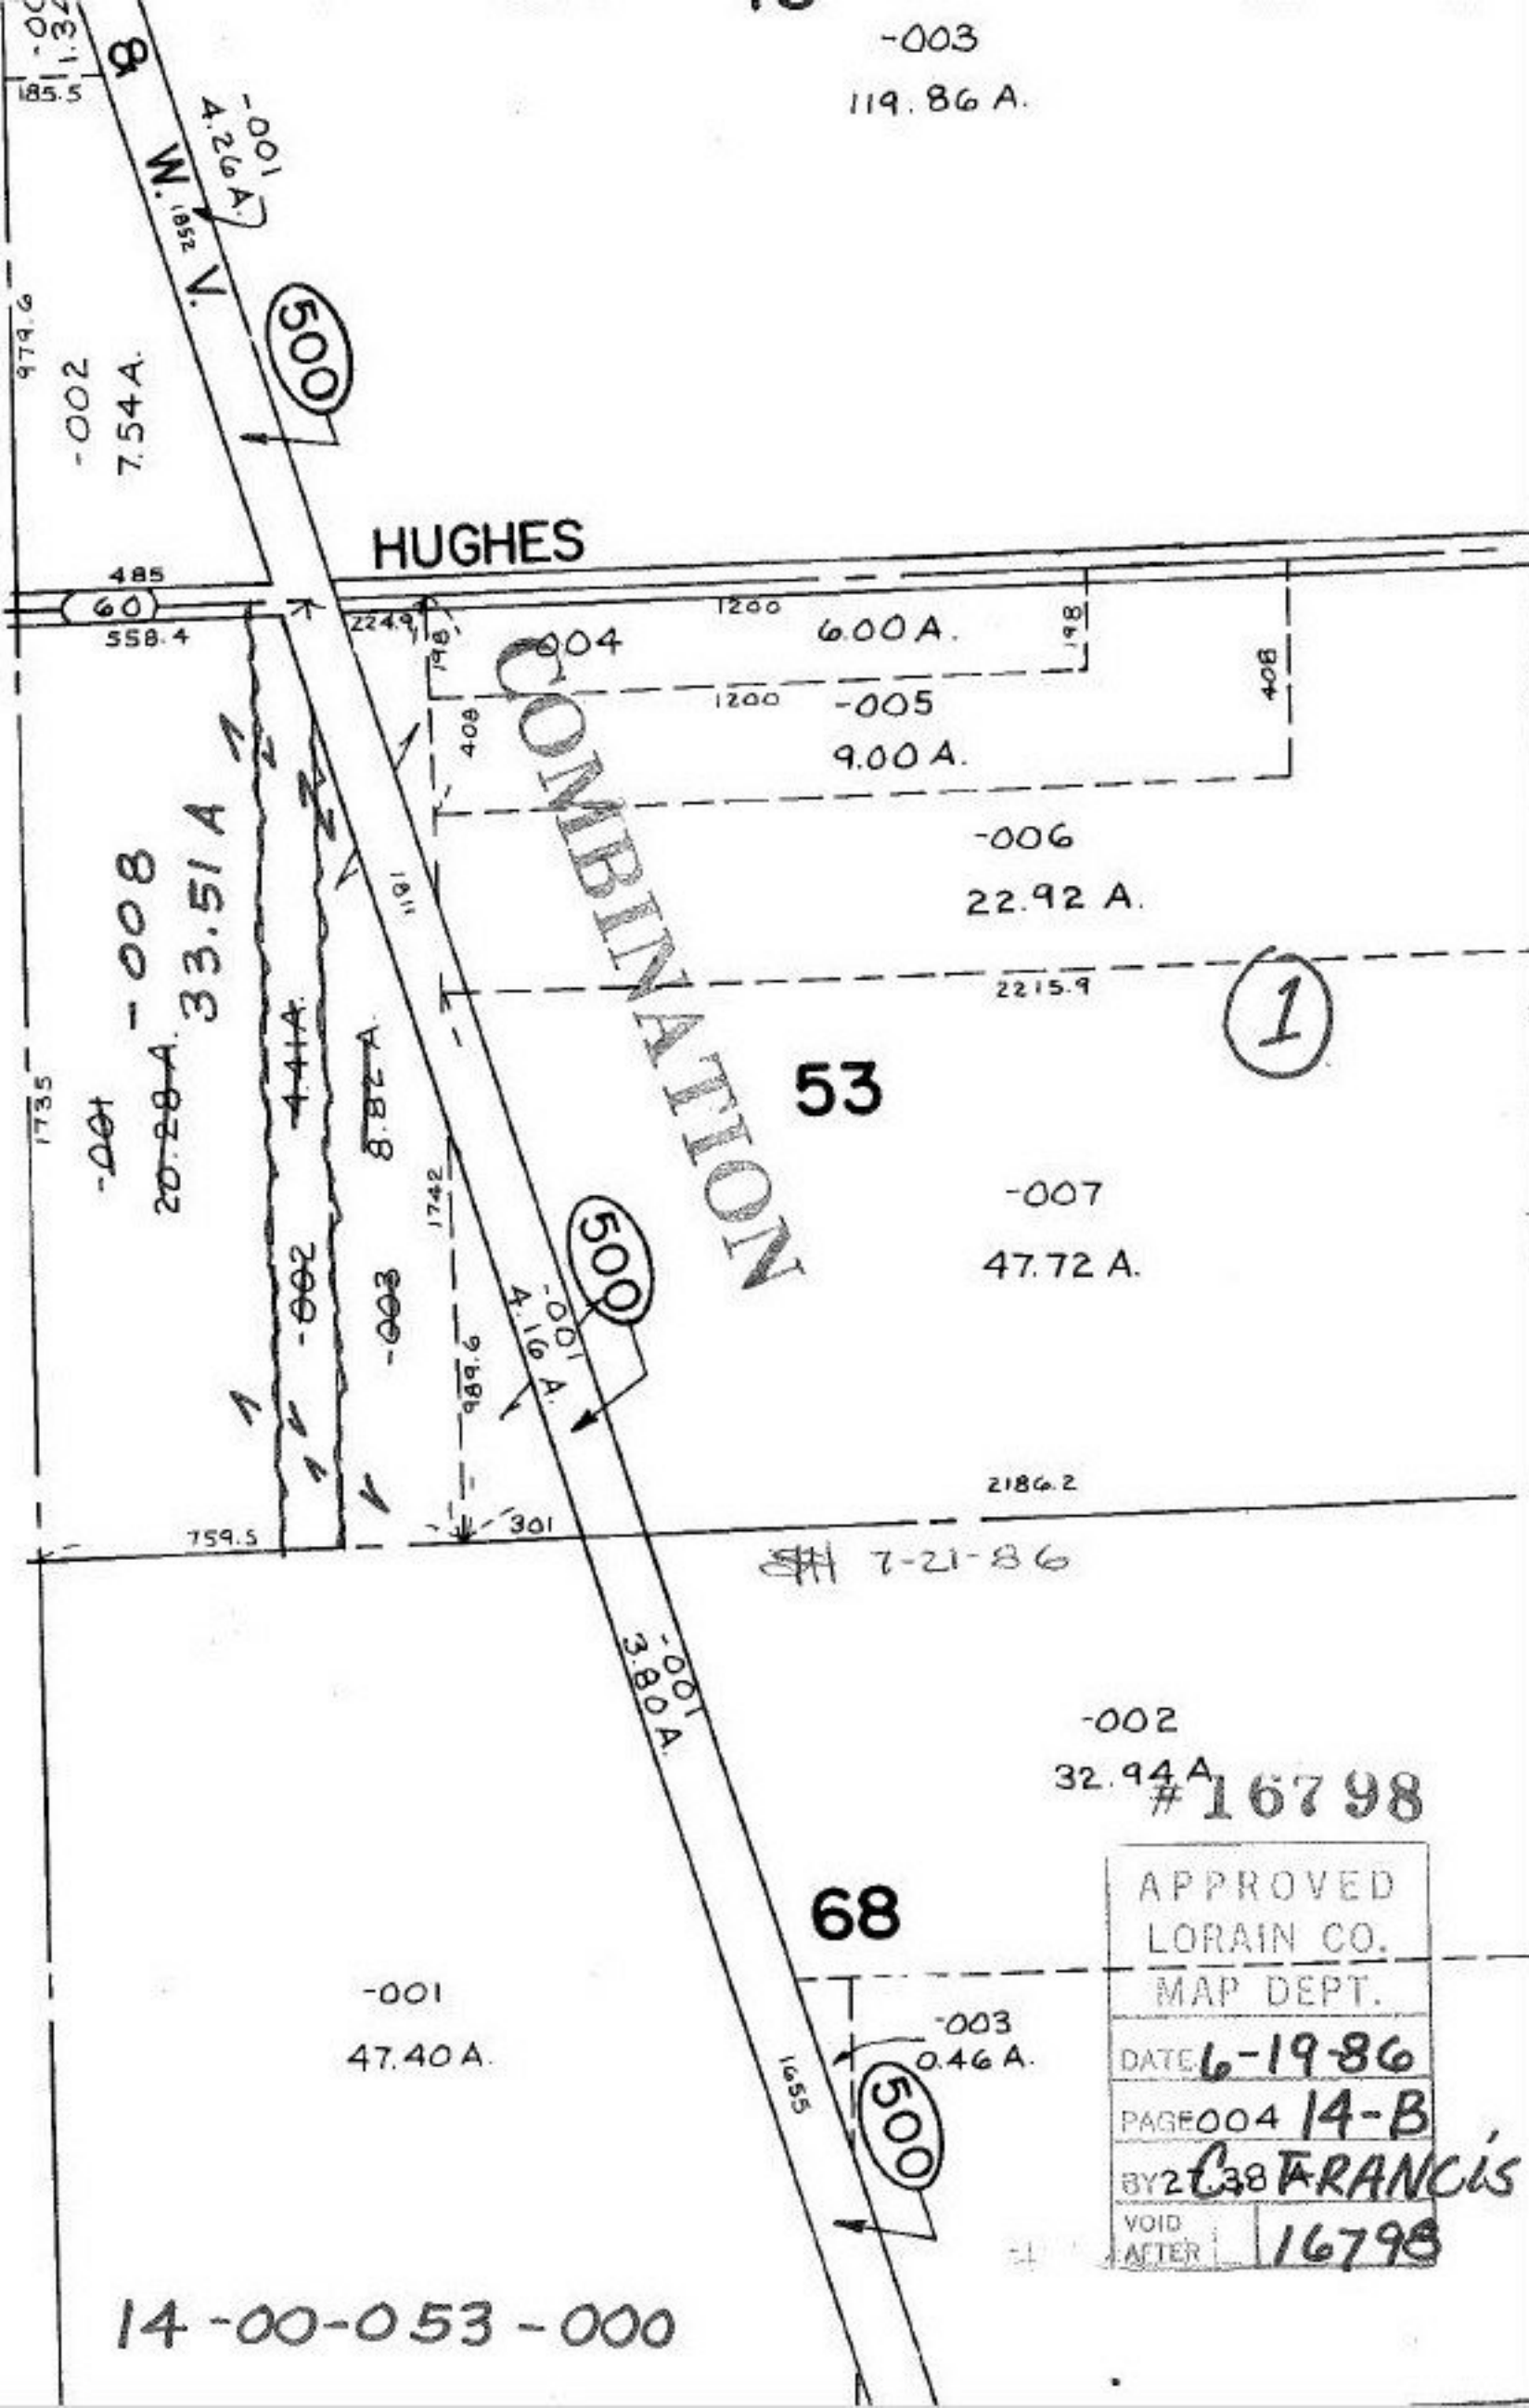

HUGHES

COMBINATION

53

1

7-21-86

68

-002
32.94 A.
16798

APPROVED
LORAIN CO.
MAP DEPT.
DATE 6-19-86
PAGE 004 14-B
BY 238 FRANCIS
VOID AFTER 16798

14-00-053-000